


12A12-90
W BOYD

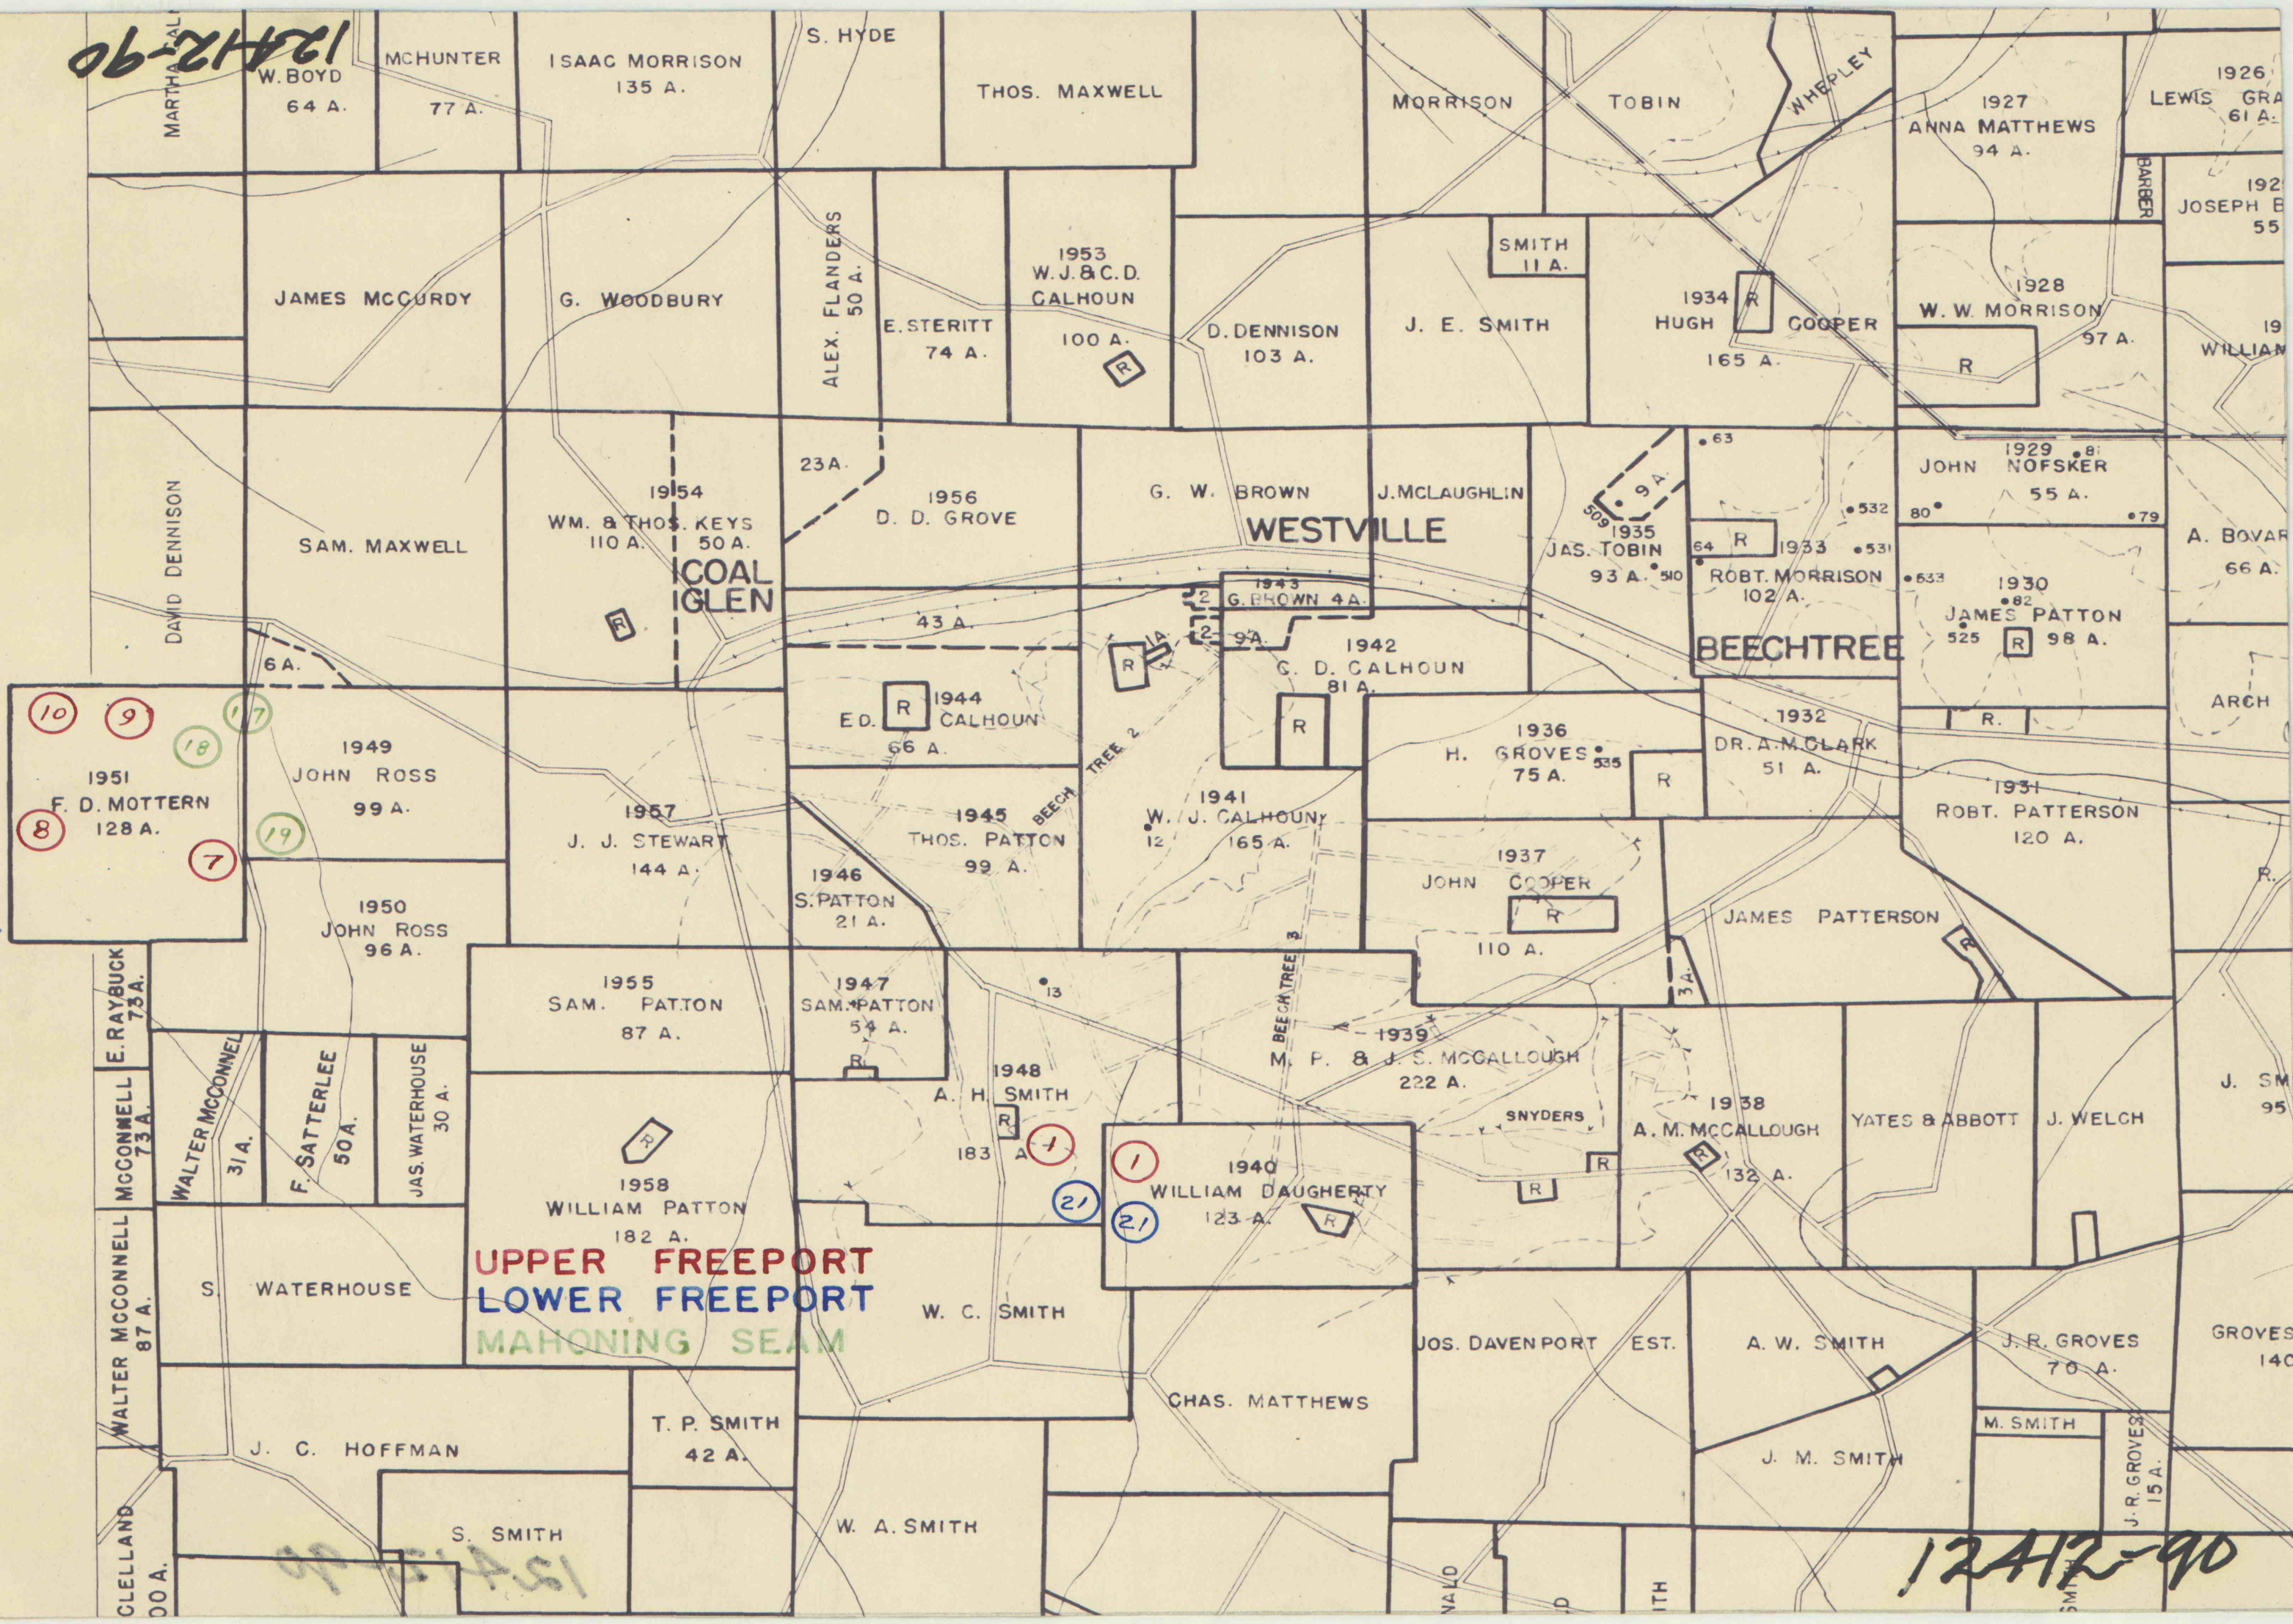

12412-90