


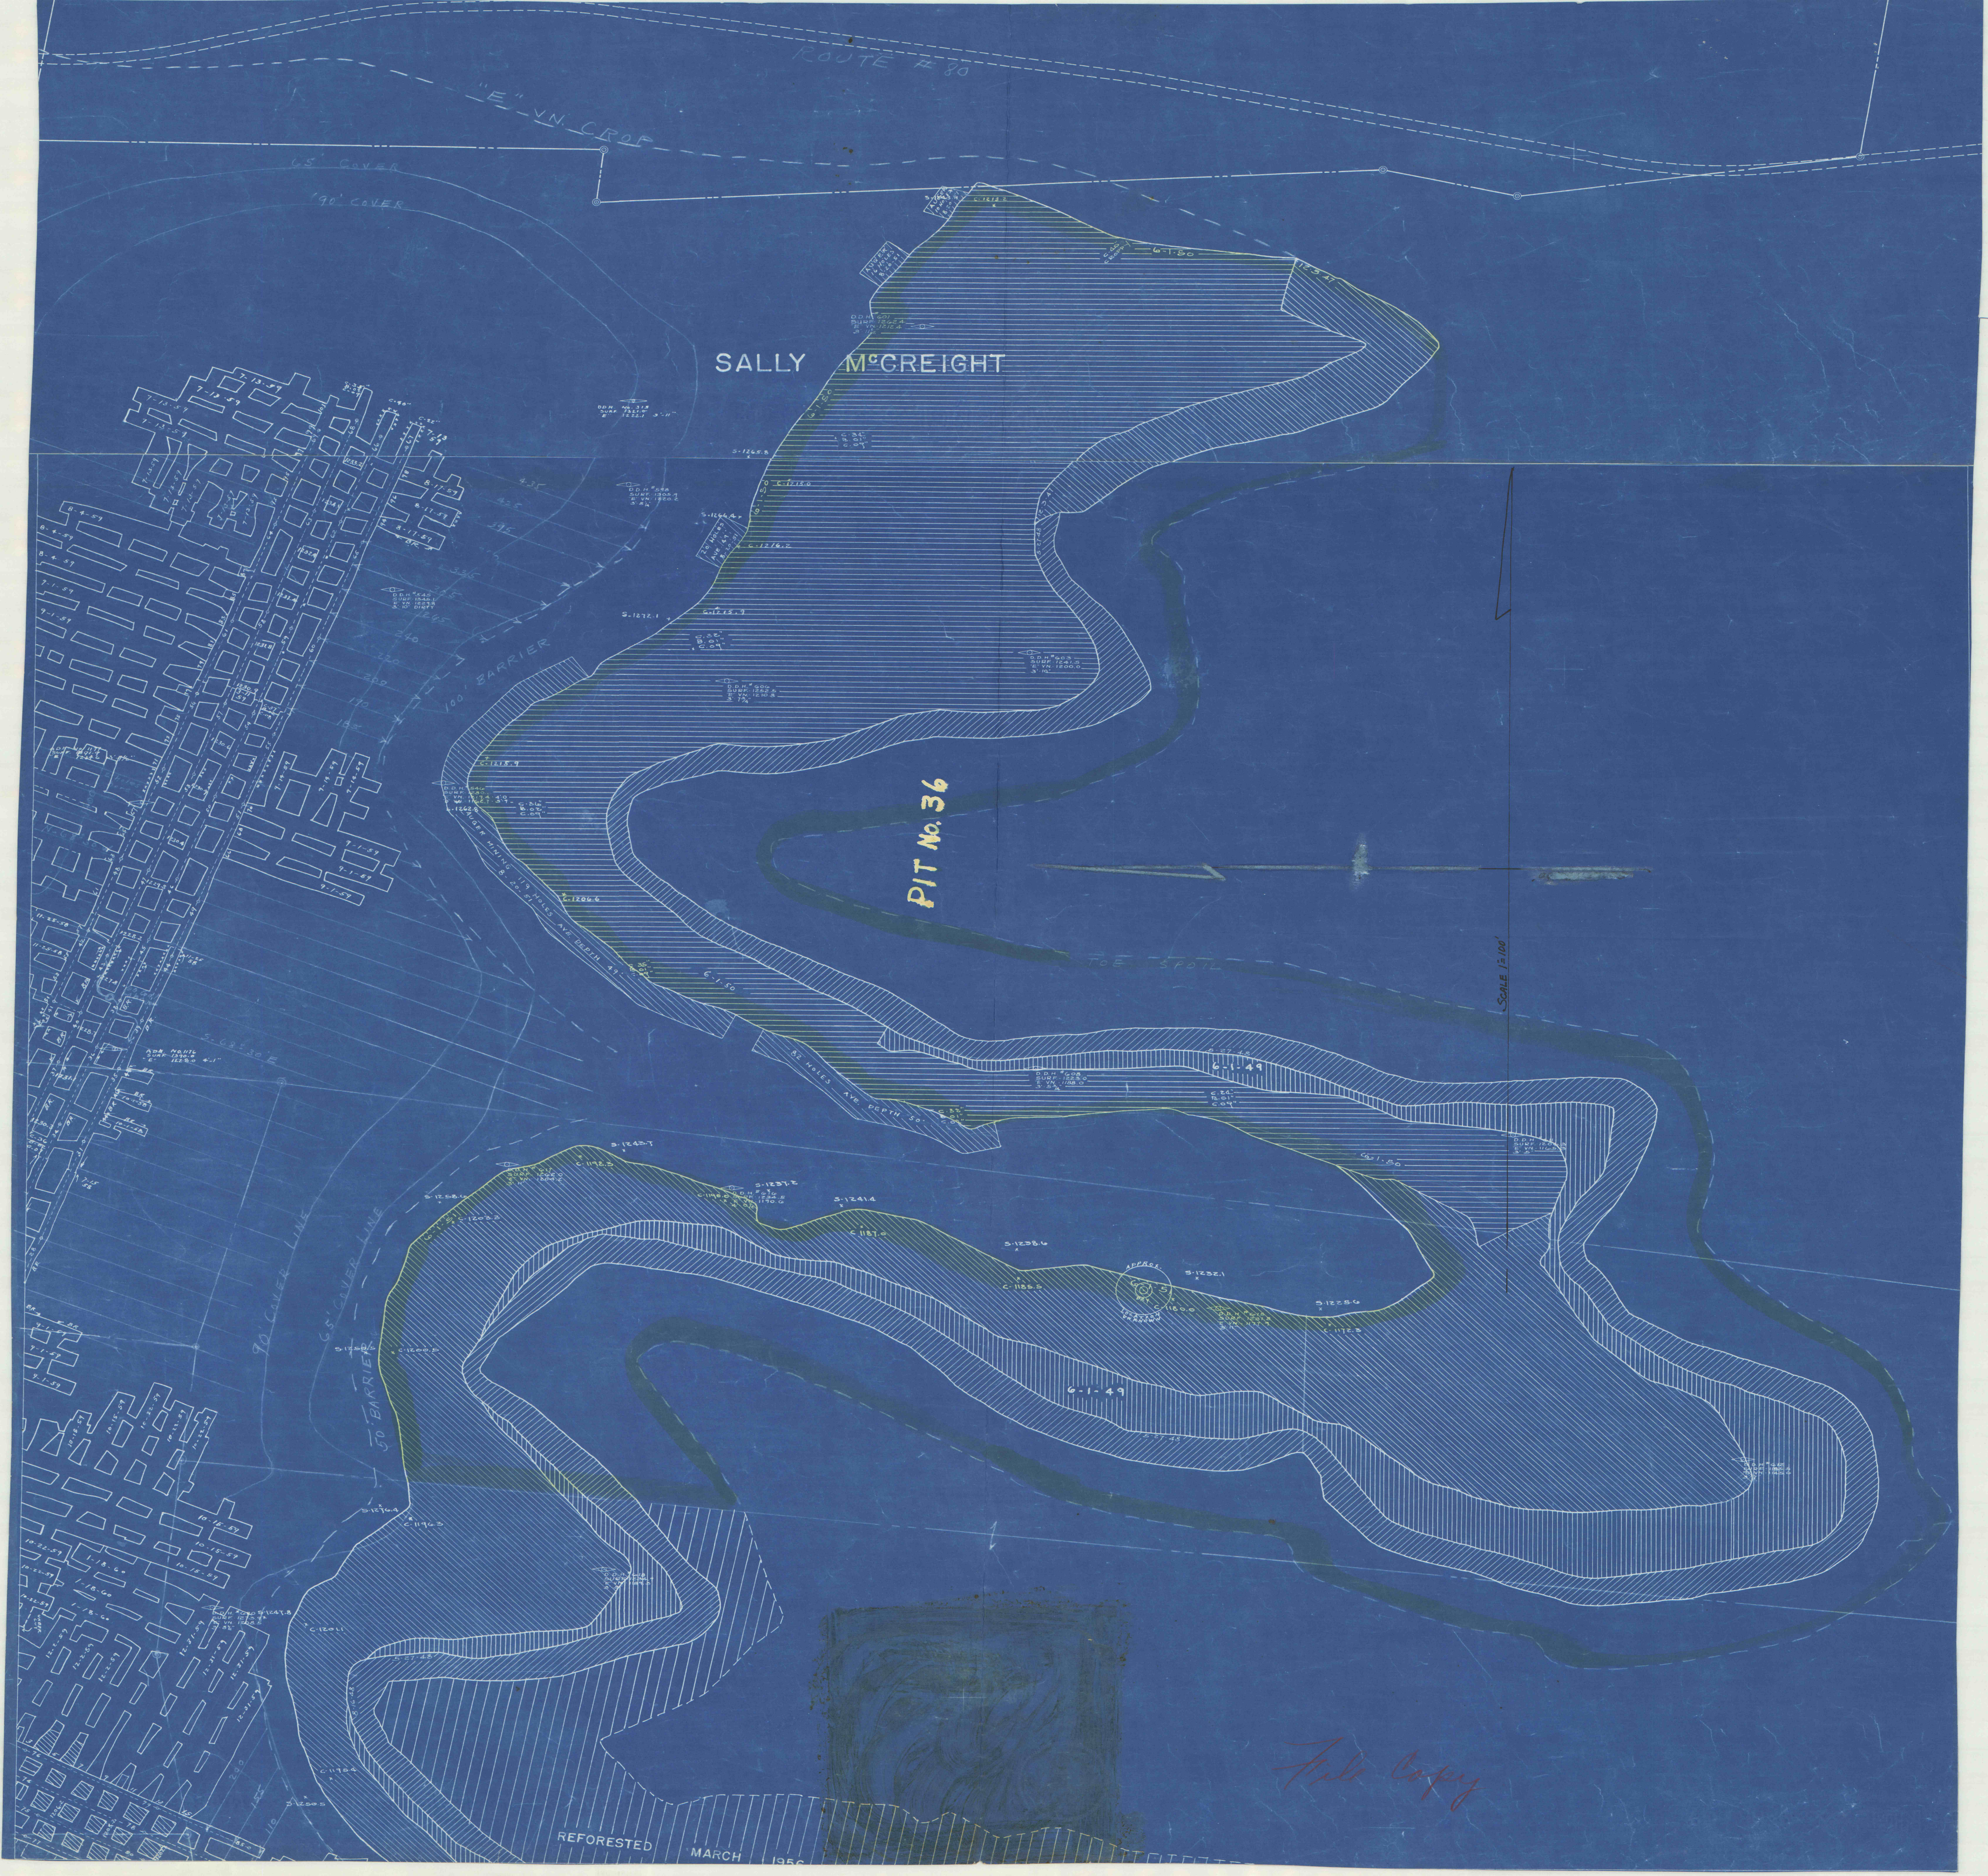

SALLY McCREIGHT

PIT No. 36

SCALE 1"=100'

File Copy

REFORESTED MARCH 1956