


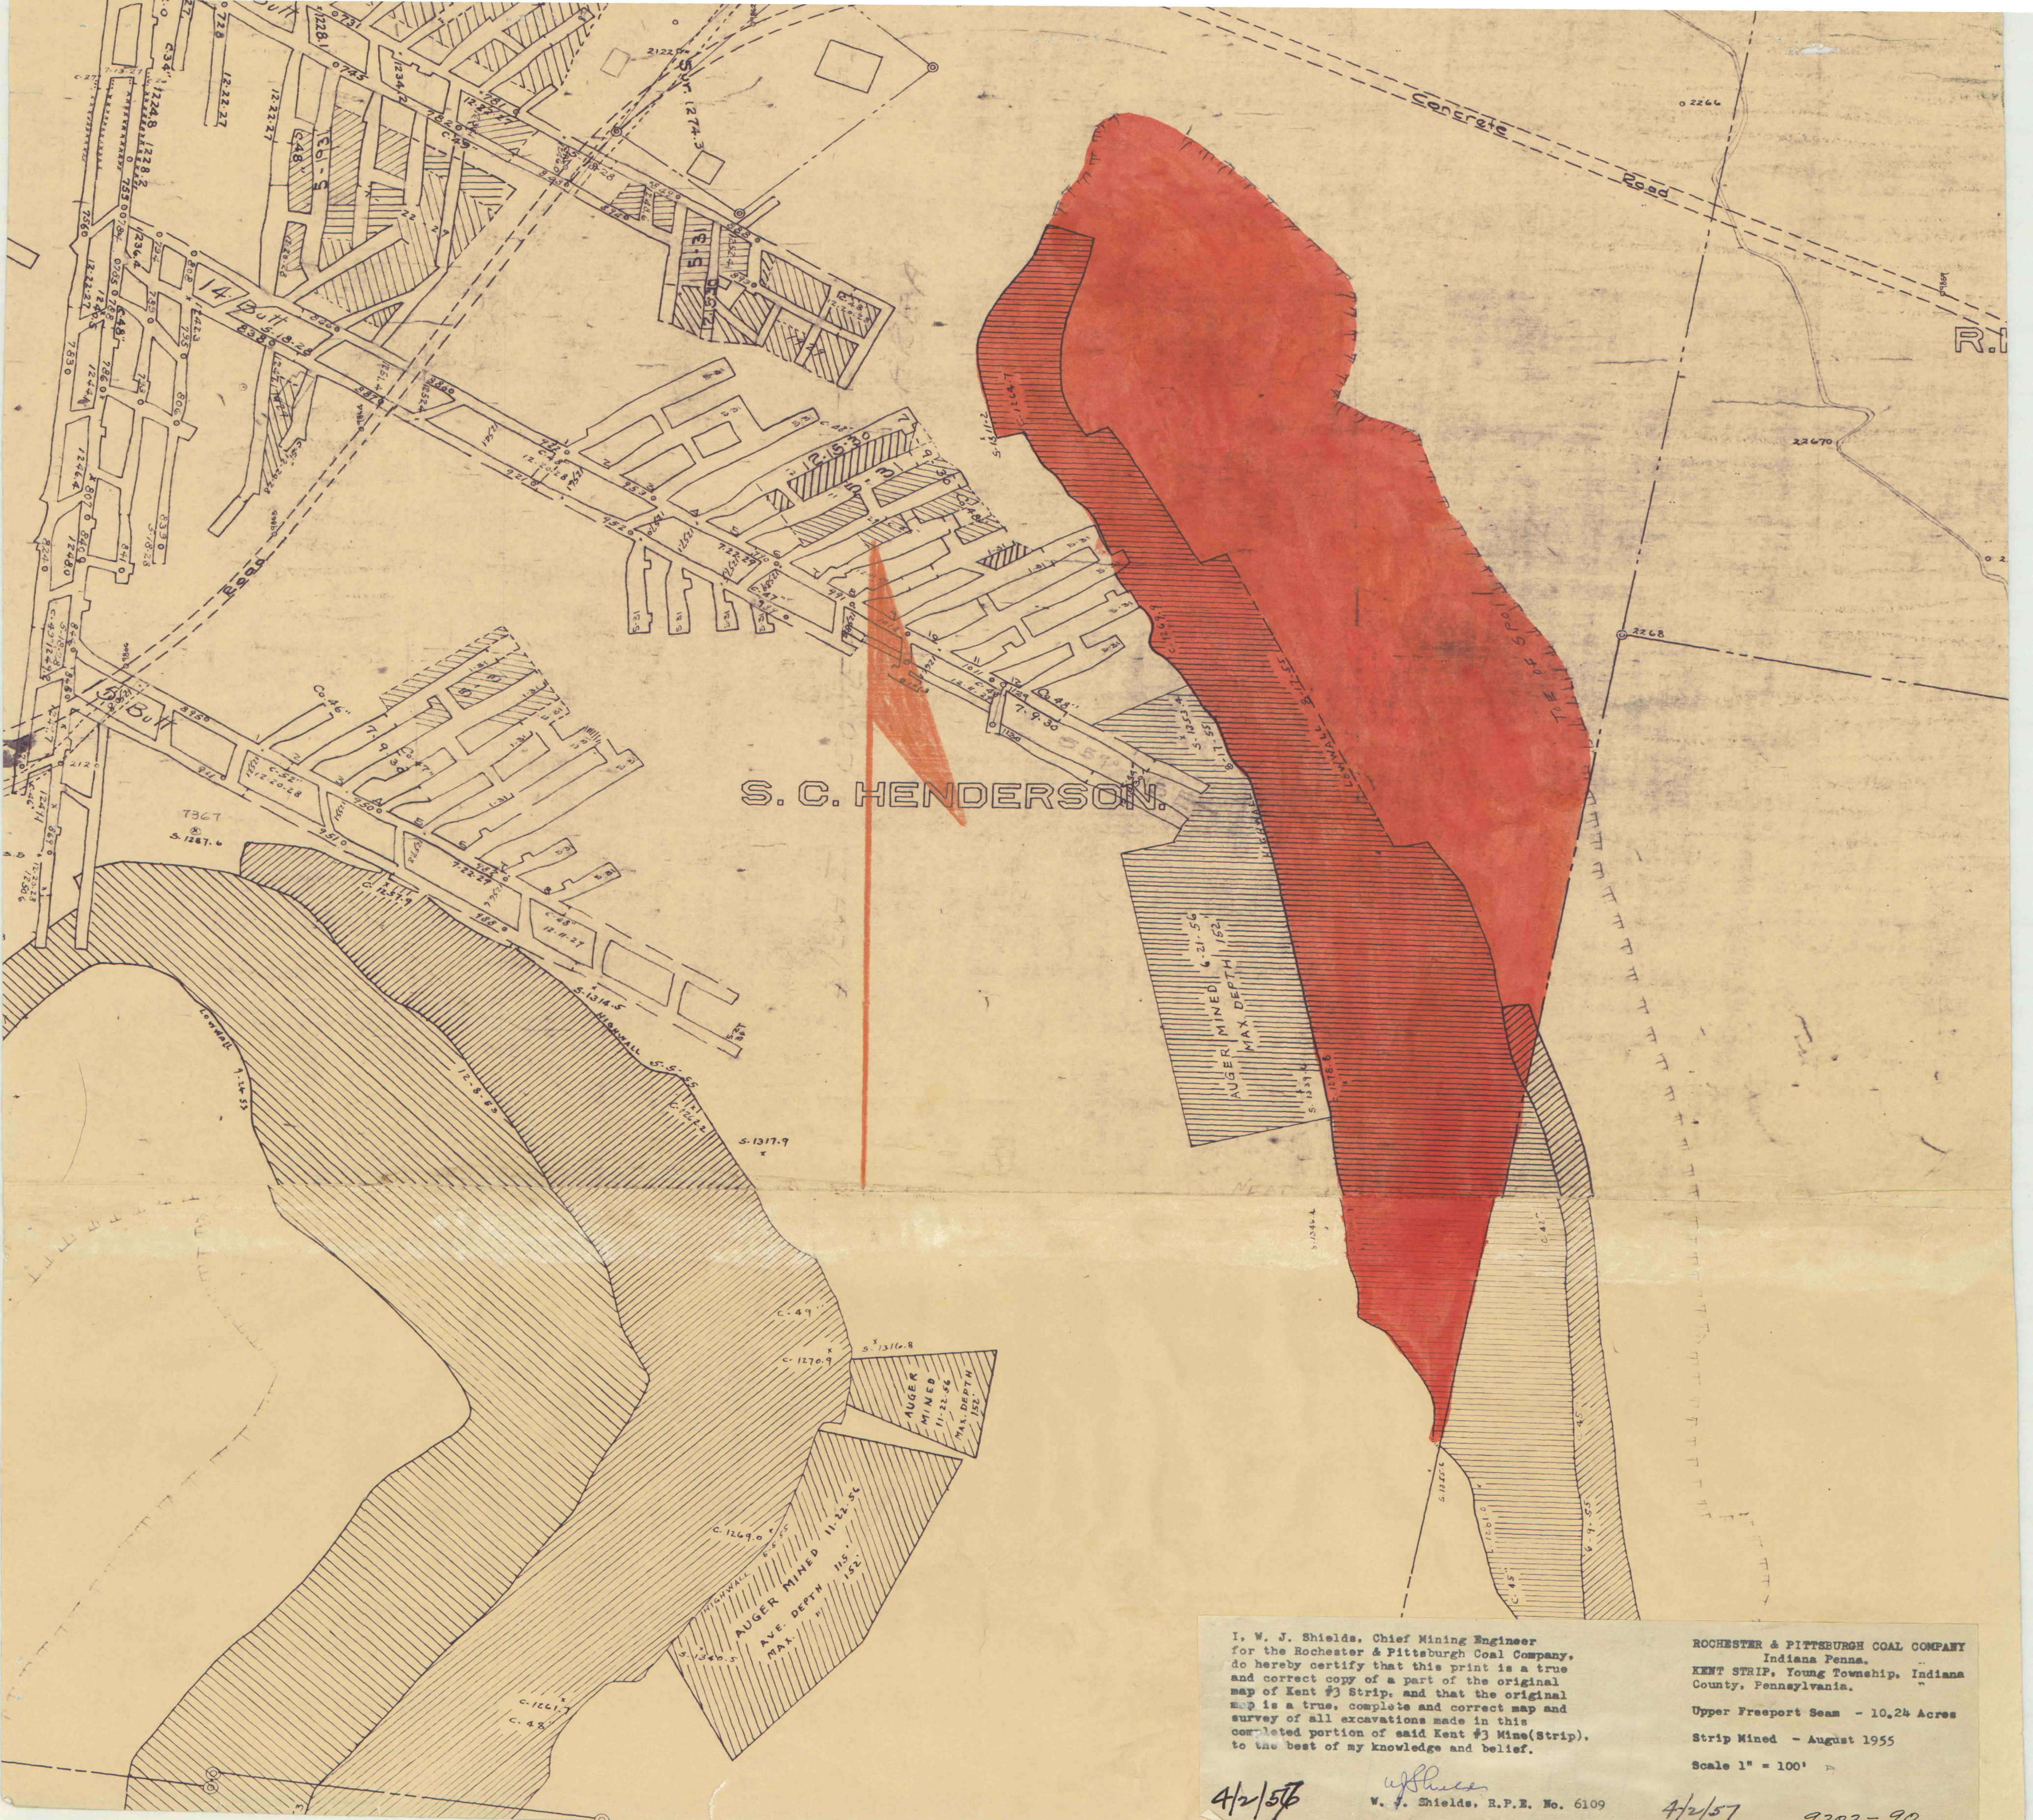

S. C. HENDERSON.

I, W. J. Shields, Chief Mining Engineer for the Rochester & Pittsburgh Coal Company, do hereby certify that this print is a true and correct copy of a part of the original map of Kent #3 Strip, and that the original map is a true, complete and correct map and survey of all excavations made in this completed portion of said Kent #3 Mine (Strip), to the best of my knowledge and belief.

ROCHESTER & PITTSBURGH COAL COMPANY
Indiana Penna.
KENT STRIP, Young Township, Indiana
County, Pennsylvania.

Upper Freeport Seam - 10.24 Acres
Strip Mined - August 1955
Scale 1" = 100'

4/2/57

W. J. Shields, R.P.E. No. 6109

4/2/57

9202-90