


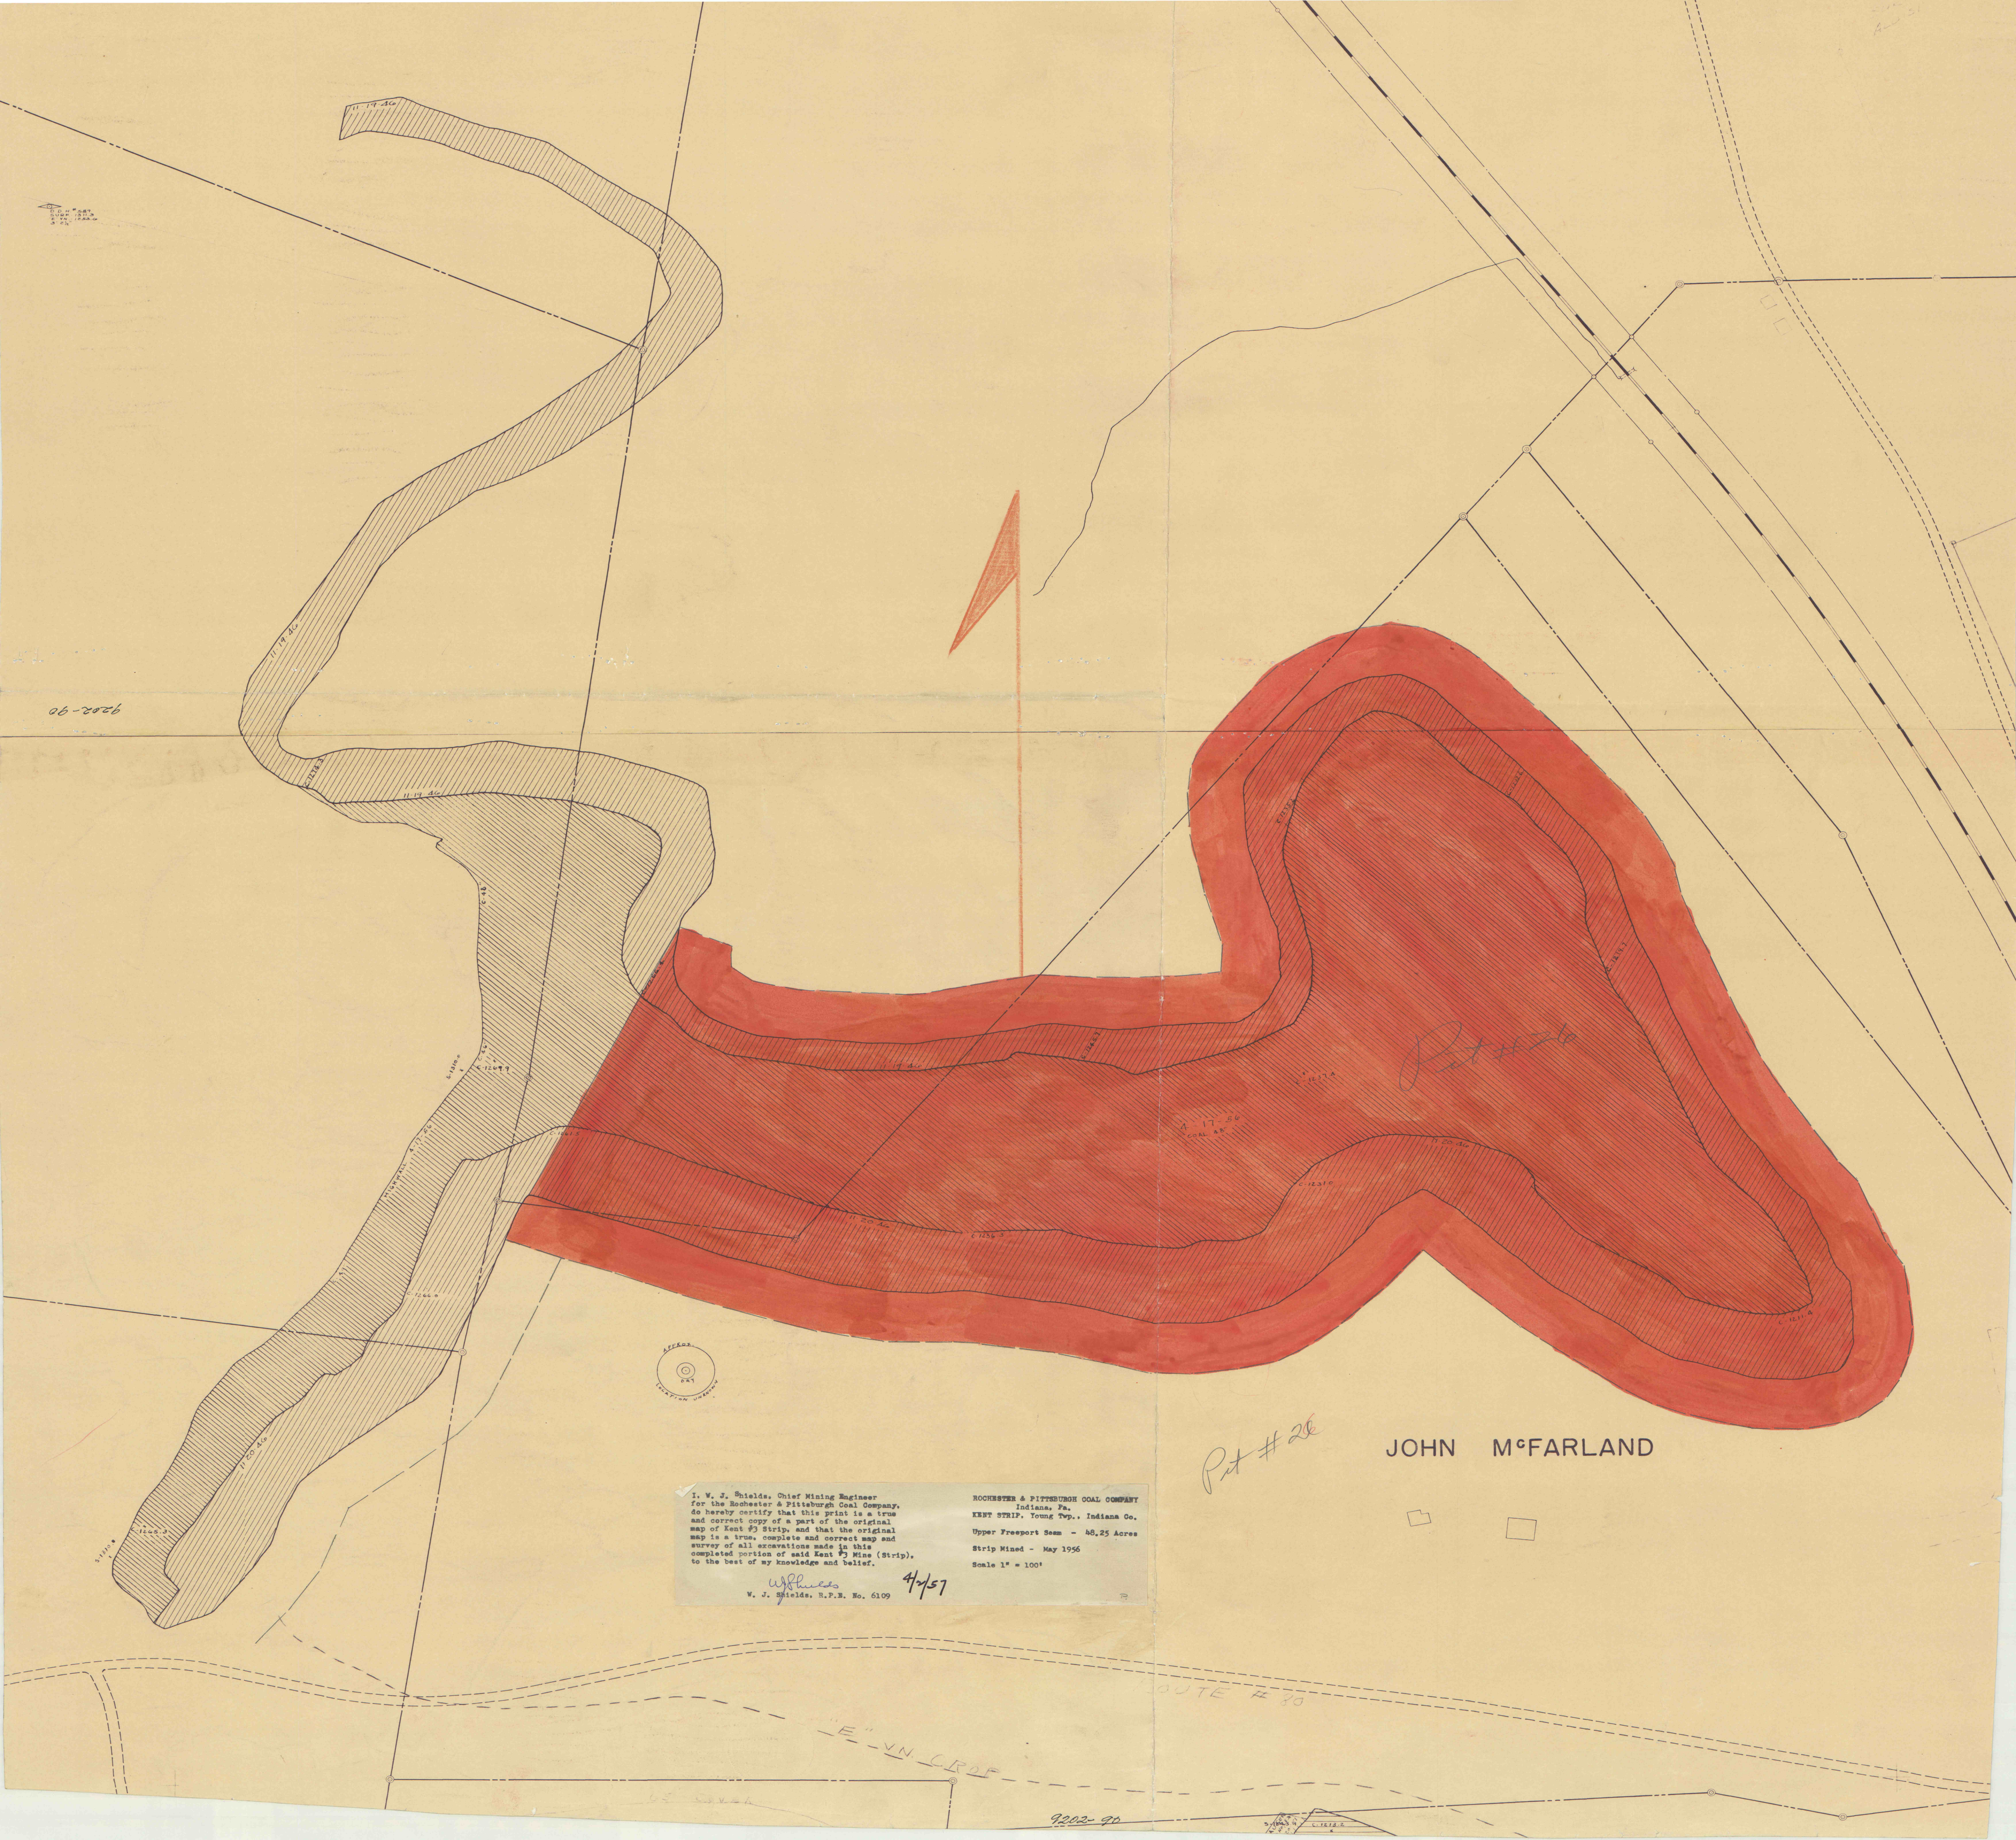

I. W. J. Shields, Chief Mining Engineer for the Rochester & Pittsburgh Coal Company, do hereby certify that this print is a true and correct copy of a part of the original map of Kent #3 Strip, and that the original map is a true, complete and correct map and survey of all excavations made in this completed portion of said Kent #3 Mine (Strip), to the best of my knowledge and belief.

W. J. Shields, R.P.E. No. 6109

ROCHESTER & PITTSBURGH COAL COMPANY
Indiana, Pa.
KENT STRIP, Young Twp., Indiana Co.
Upper Freeport Seam - 48.25 Acres
Strip Mined - May 1956
Scale 1" = 100'

Scale 1" = 100'