


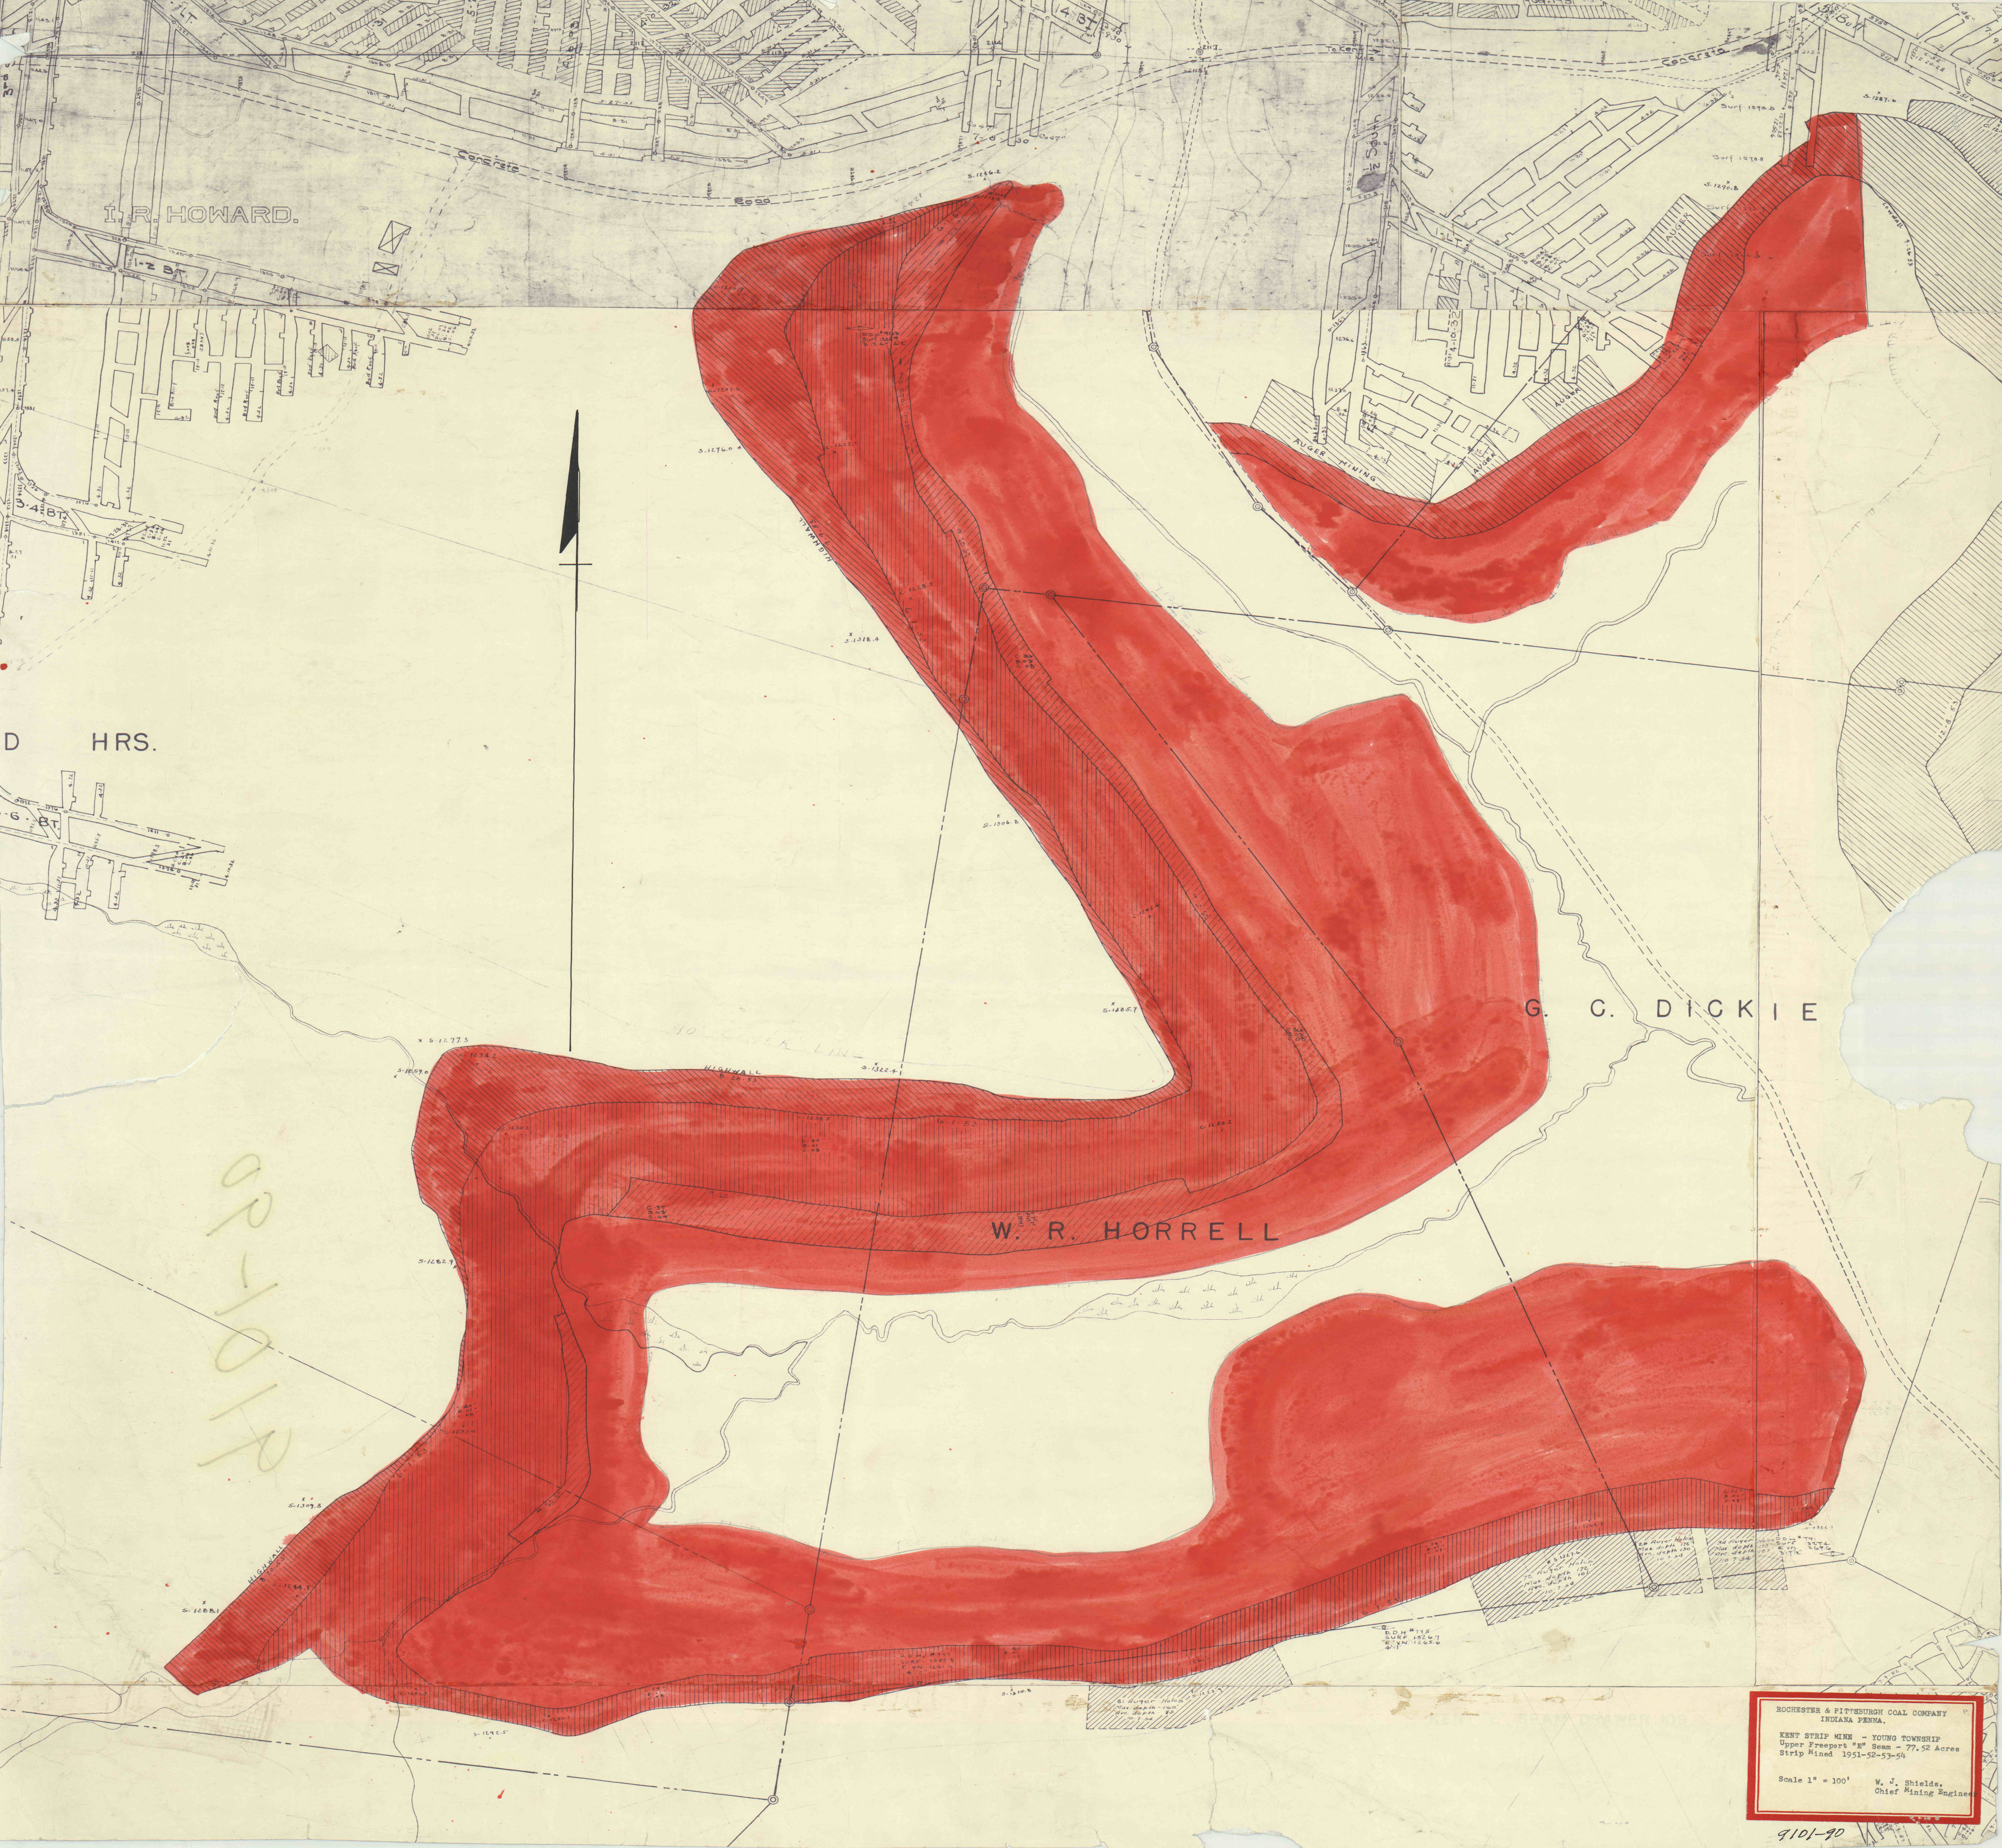

ROCHESTER & PITTSBURGH COAL COMPANY
INDIANA, PENNA.
KENT STRIP MINE - YOUNG TOWNSHIP
Upper Freeport #2 Seam - 77.52 Acres
Strip Mined 1951-52-53-54
Scale 1" = 100' W. J. Shields,
Chief Mining Engineer

9101-90