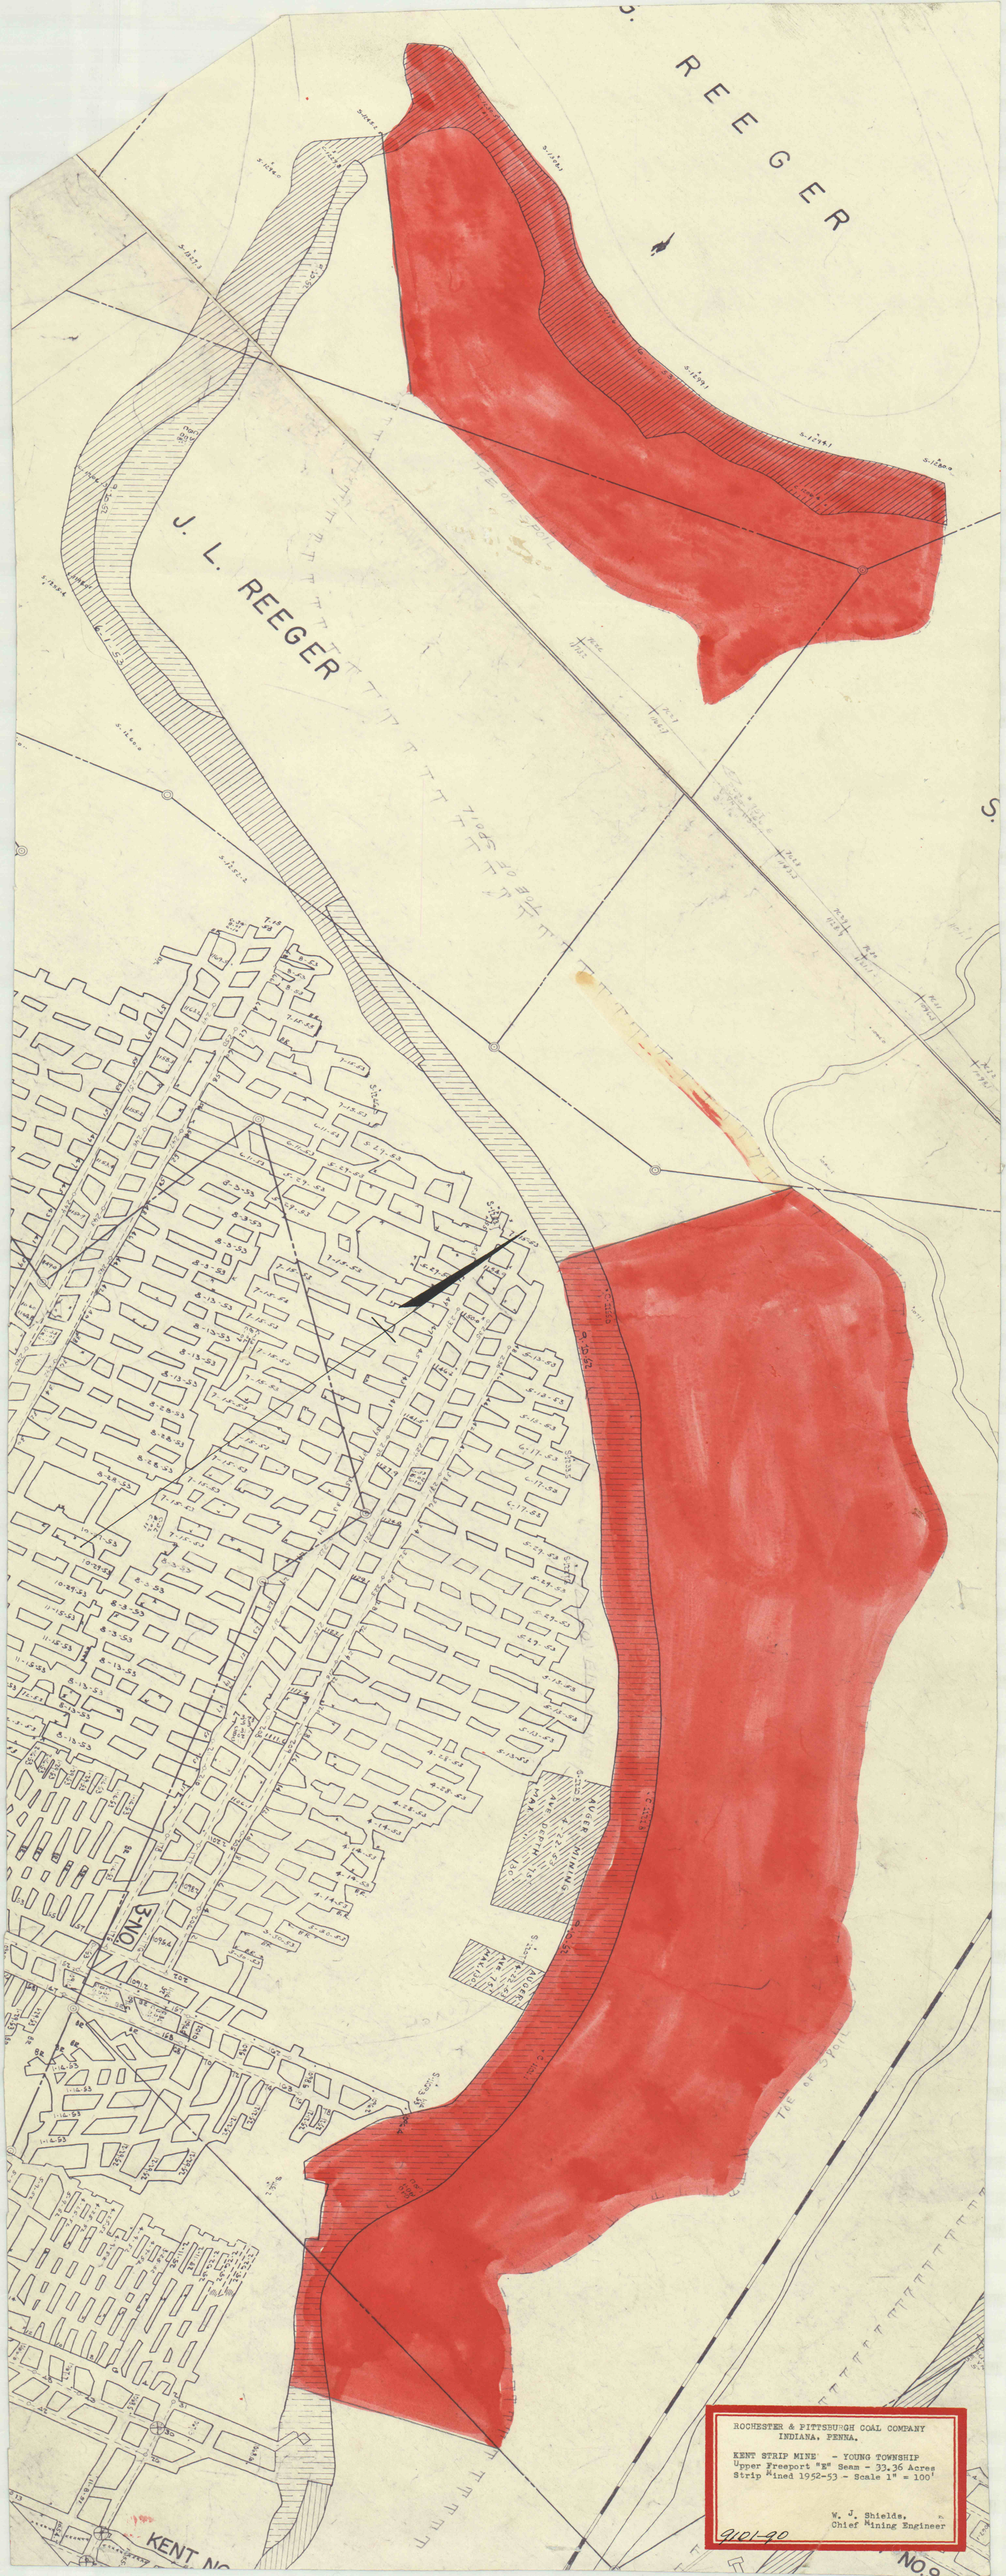
REEGER
J. L. REEGER
KENT
ROCHESTER & PITTSBURGH COAL COMPANY
INDIANA, PENNA.
KENT STRIP MINE - YOUNG TOWNSHIP
Upper Freeport "E" Seam - 33.36 Acres
Strip Mined 1952-53 - Scale 1" = 100'
W. J. Shields,
Chief Mining Engineer
9101-90