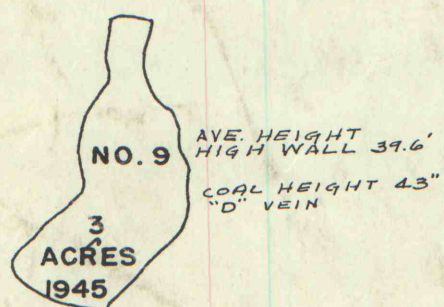
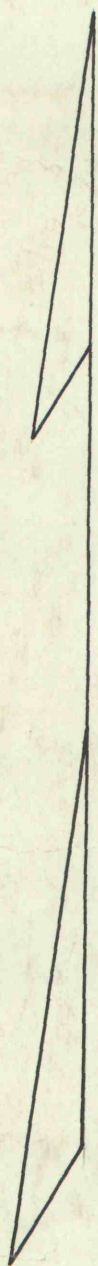
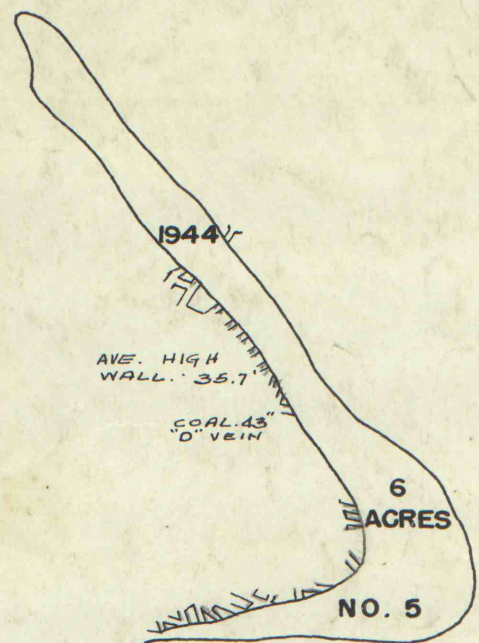


ROCHESTER AND PITTSBURGH COAL CO.
 INDIANA PA.
 KENT STRIP OPERATION
 STRIP PITS NO. 5, 9 & 10
 YOUNG TWP. INDIANA CO.
 LOWER FREEPORT SEAM 43"
 APRIL 1948 SCALE 1" = 400'