


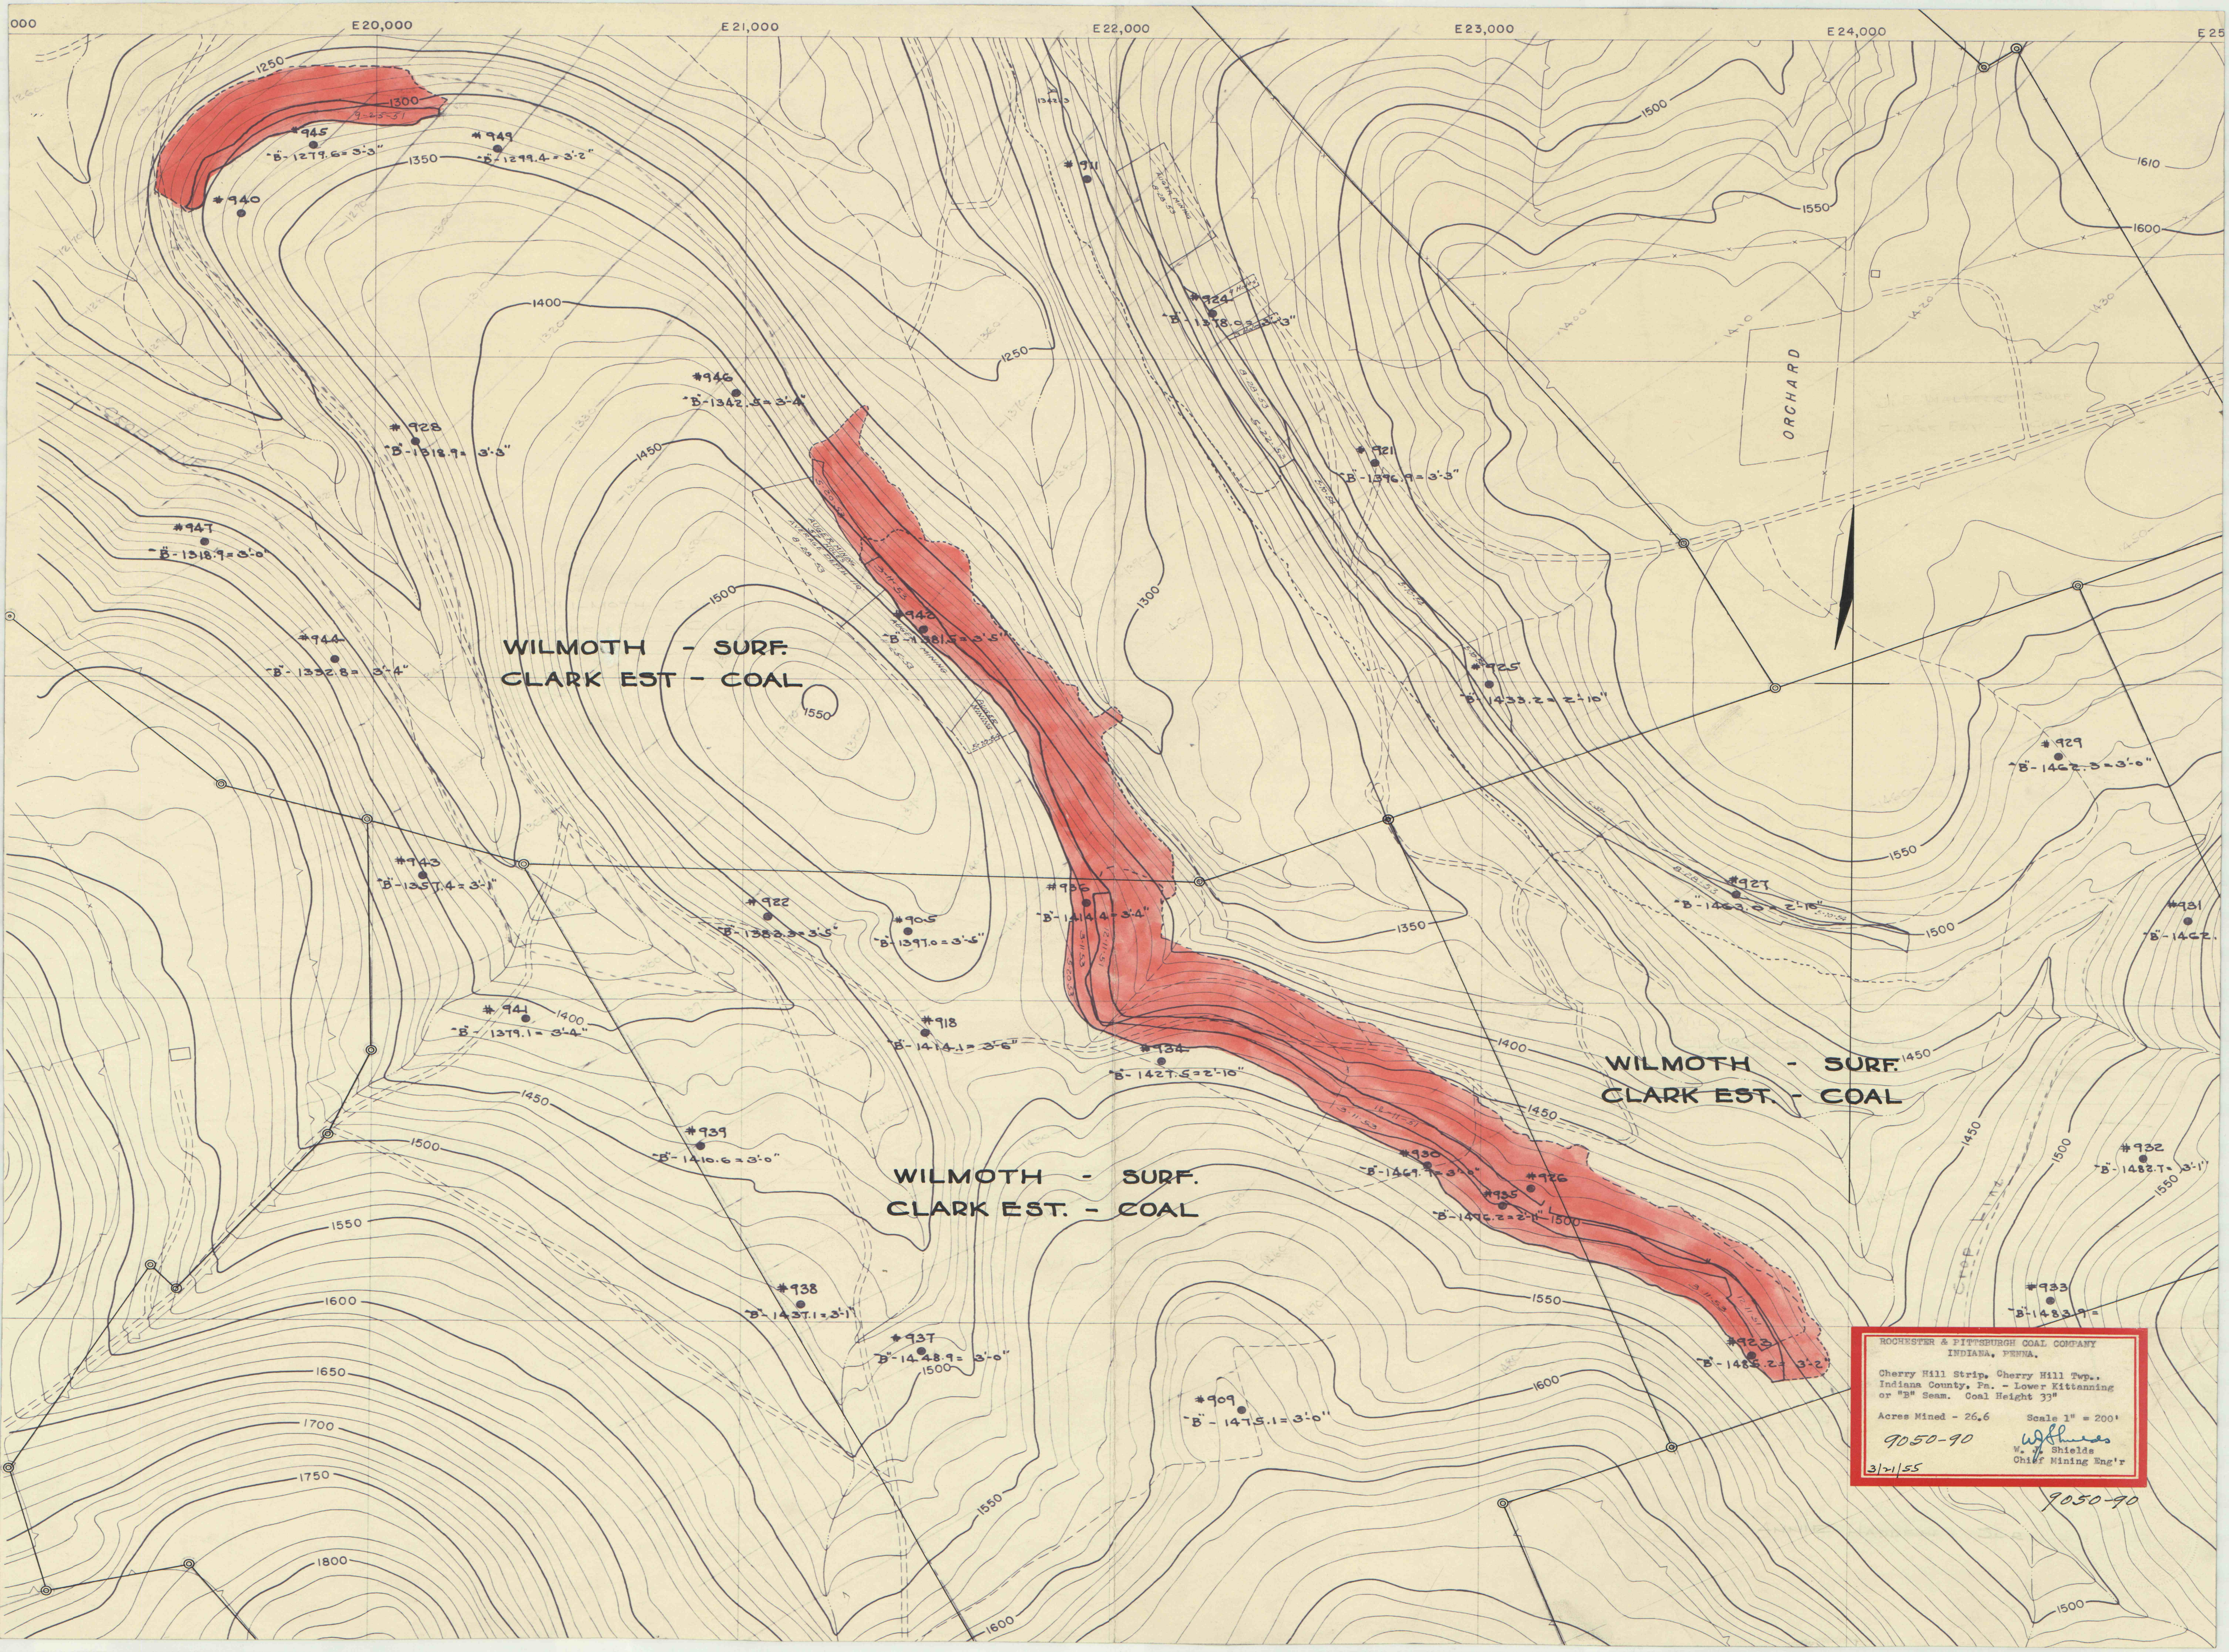

WILMOTH - SURF.
CLARK EST. - COAL

WILMOTH - SURF.
CLARK EST. - COAL

WILMOTH - SURF.
CLARK EST. - COAL

ROCHESTER & PITTSBURGH COAL COMPANY
INDIANA, PENNA.
Cherry Hill Strip, Cherry Hill Twp.,
Indiana County, Pa. - Lower Kittanning
or "B" Seam. Coal Height 33'
Acres Mined - 26.6 Scale 1" = 200'
9050-90
W. J. Shields
Chief Mining Eng'r
3/21/55