


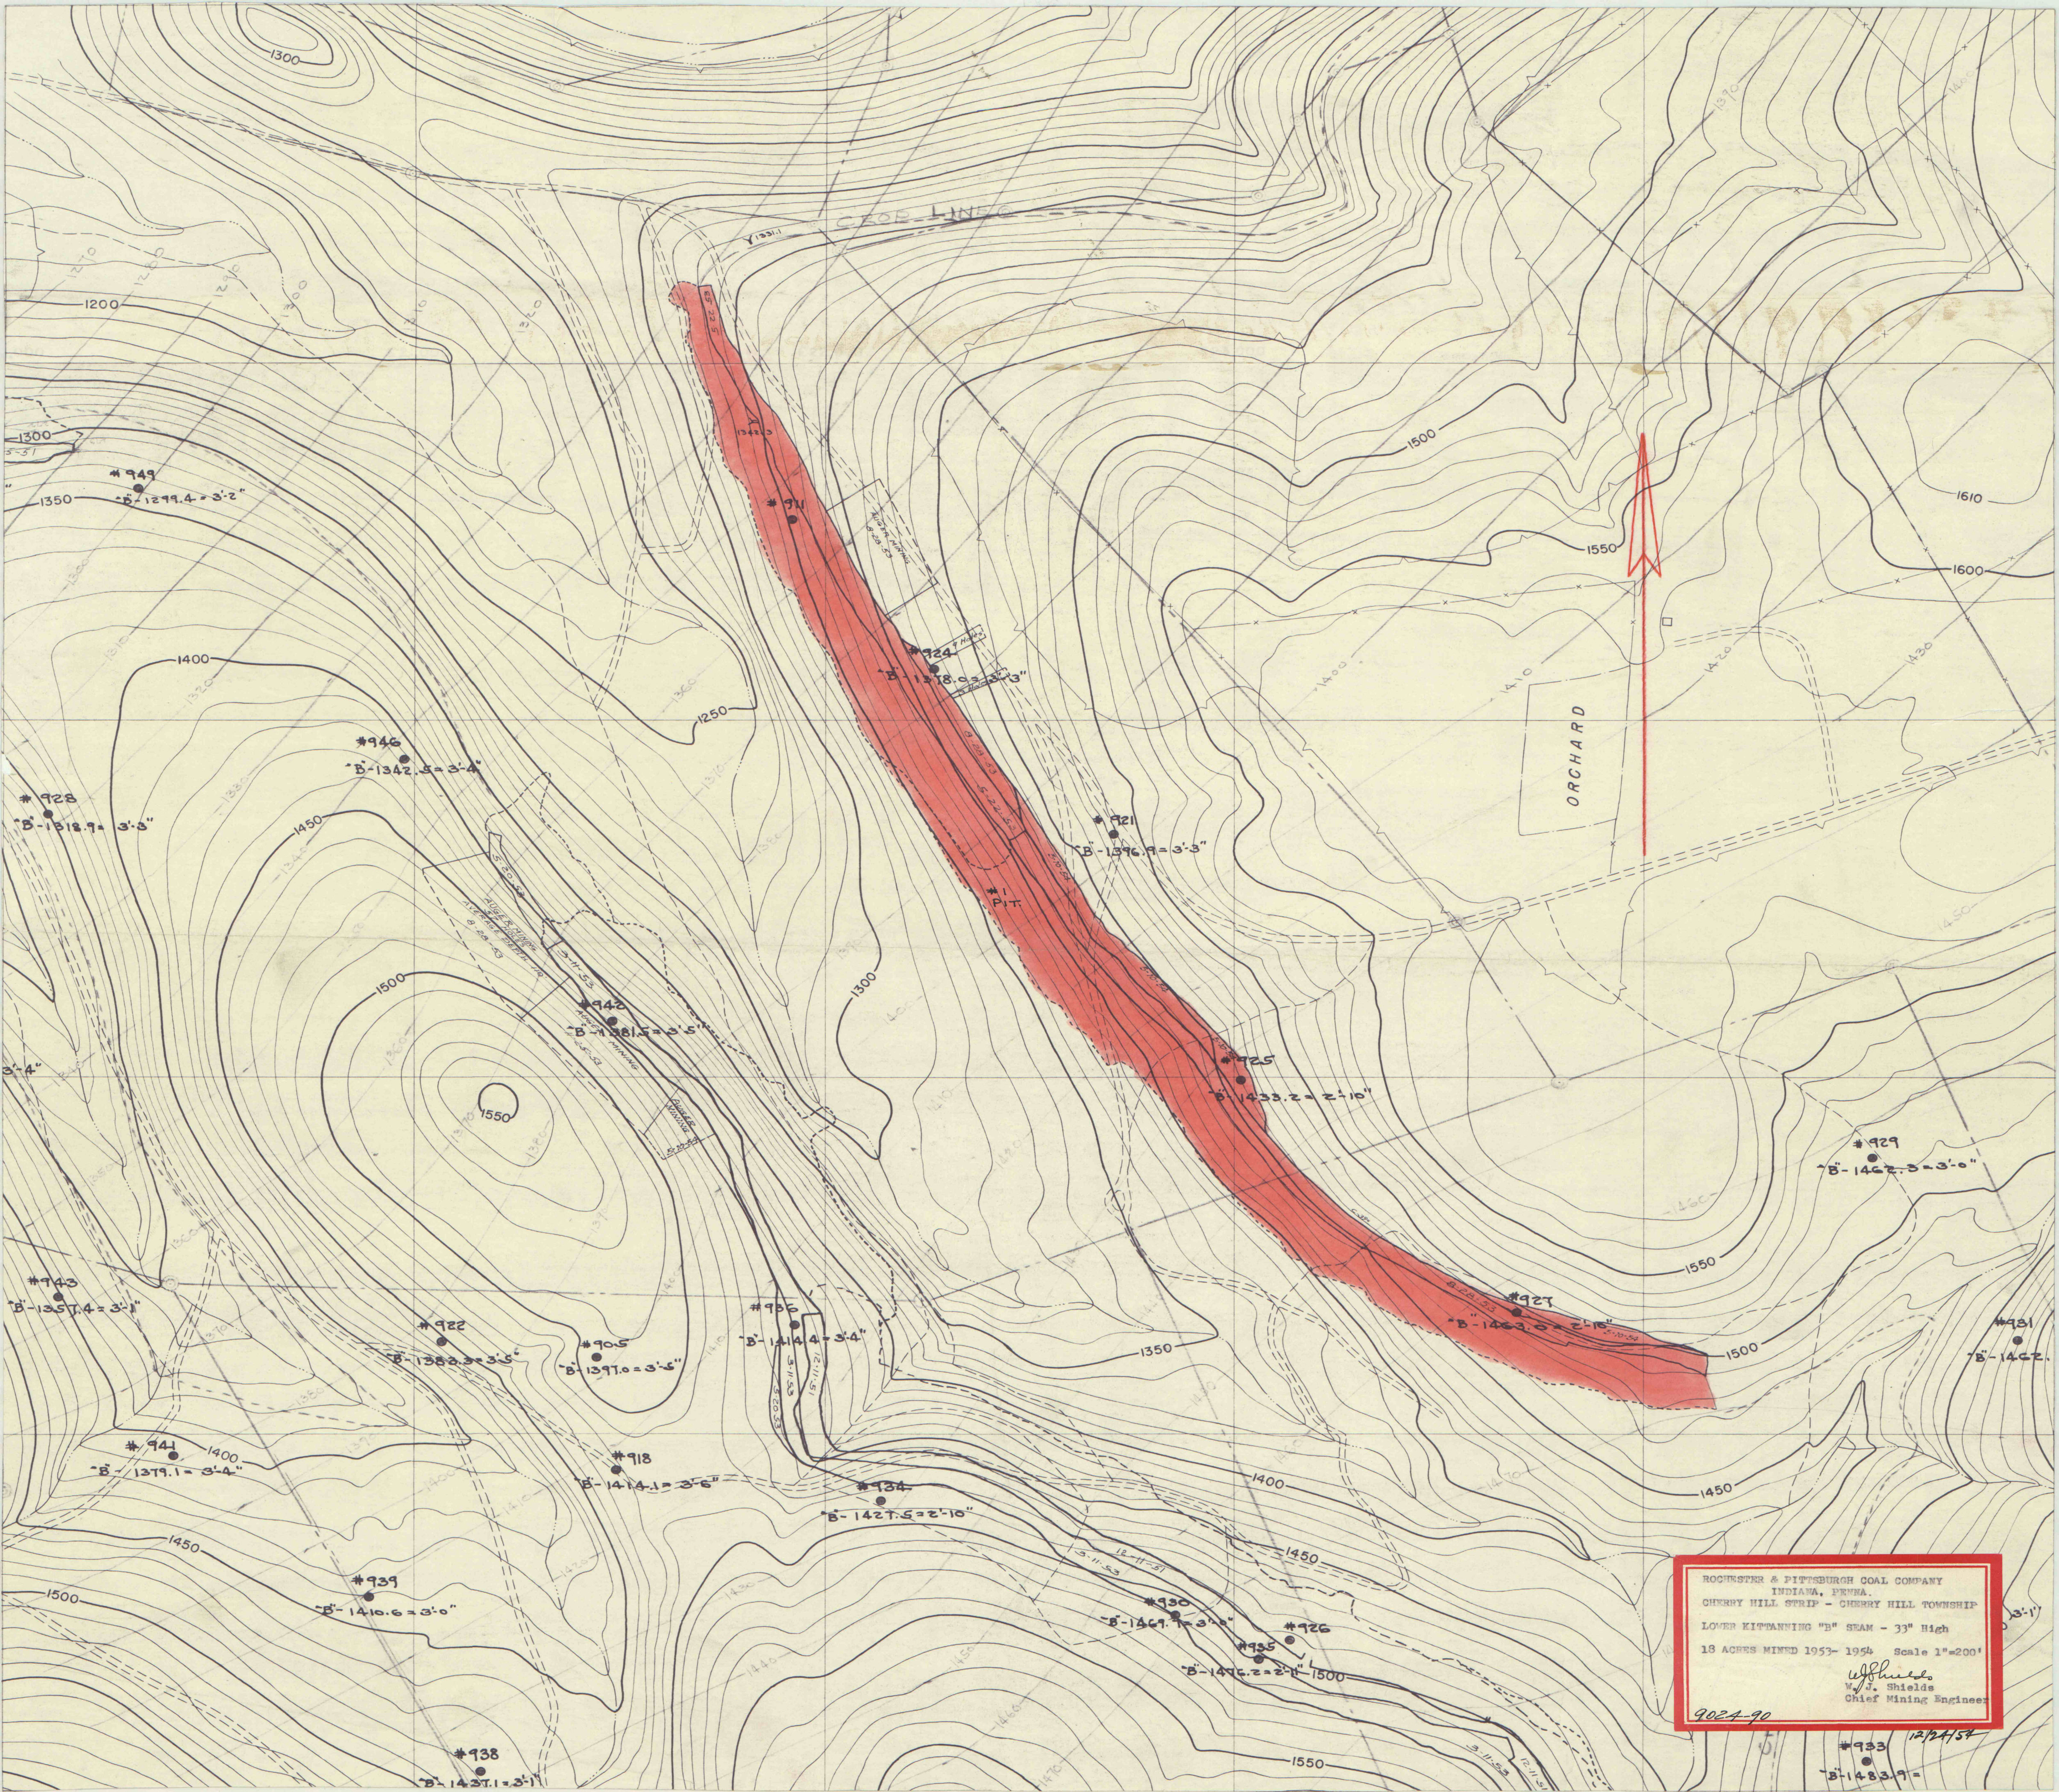

ROCHESTER & PITTSBURGH COAL COMPANY
INDIANA, PENNA.
CHERRY HILL STRIP - CHERRY HILL TOWNSHIP
LOWER KITPANNING "B" SEAM - 33" High
18 ACRES MINED 1953- 1954 Scale 1"=200'
W. J. Shields
Chief Mining Engineer
9024-90

#933 12/24/54
B-1483.9 =