


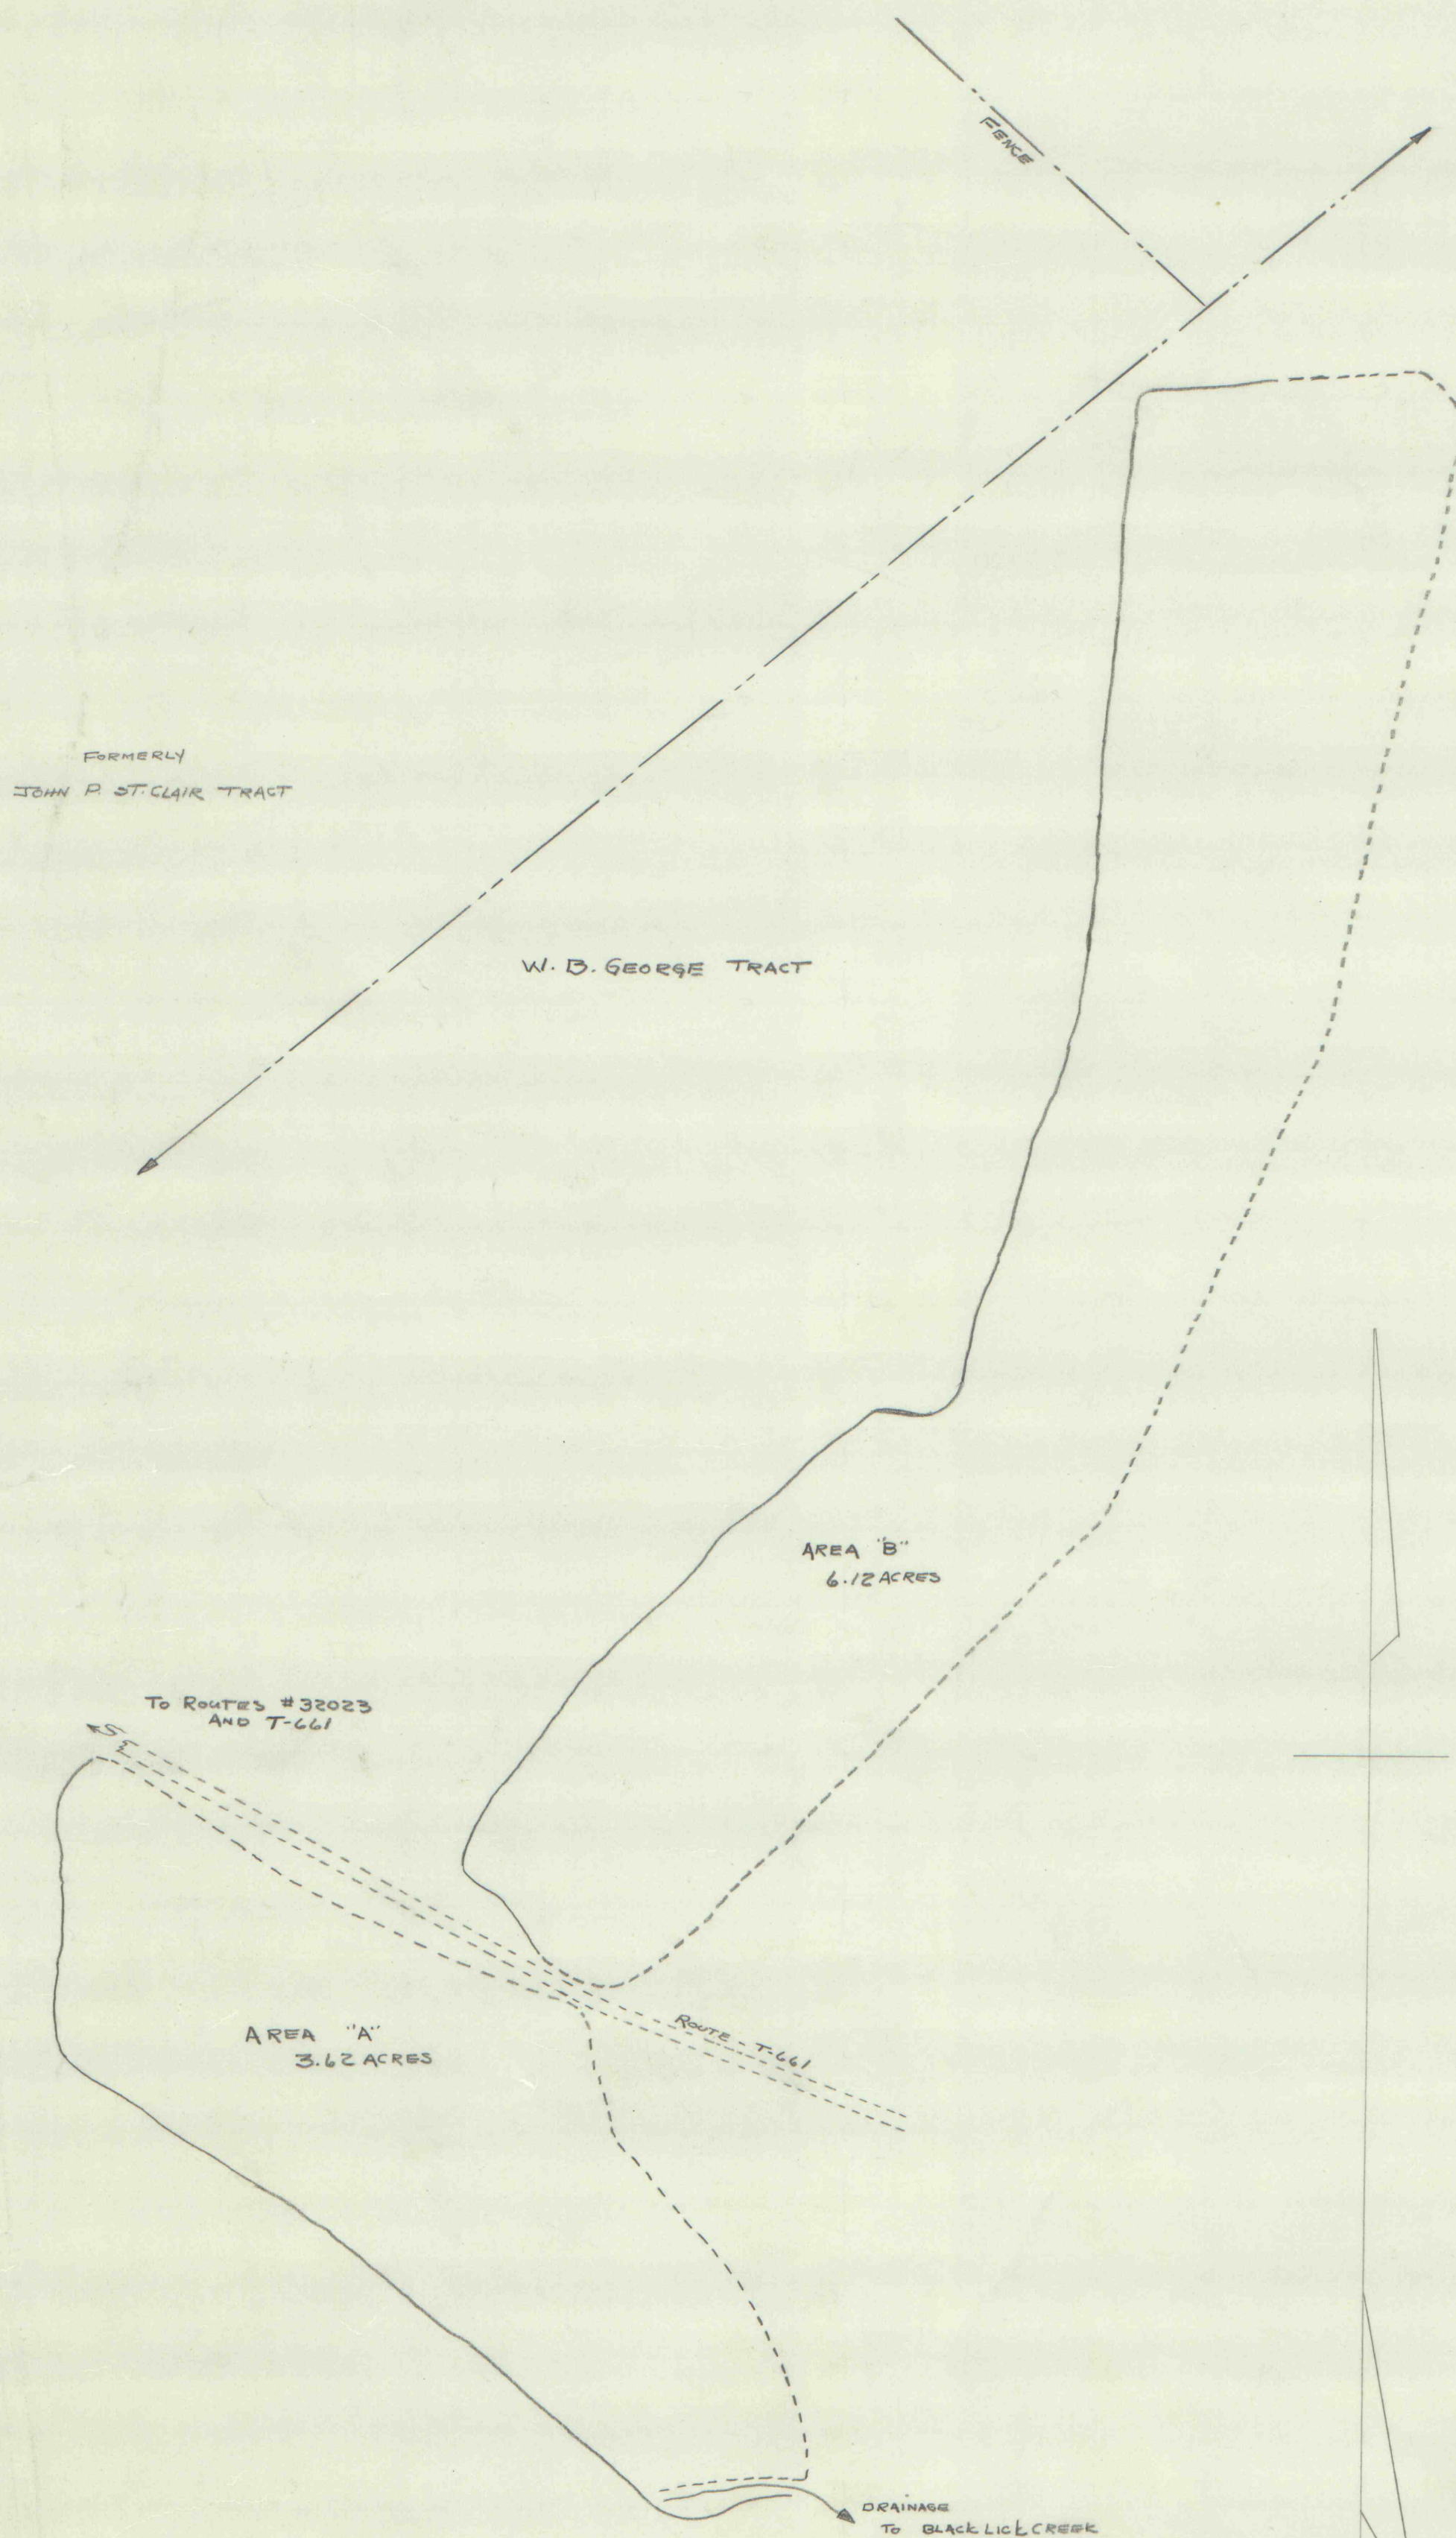

STRIP OPERATION

Completion Map - Backfill Completed this date, May 17, 1962 - C. E. Lauver & Sons on W. B. George Tract, formerly A.T. & T. Corporation - in fee.
OPERATION ON "B", or Lower Kittanning Coal Seam

Situate - Center Township, Indiana County, Pennsylvania

Scale 1" = 100' (Area "A" & "B") = 9.74 Acres

Surveyed May 17, 1962 by George R. Jones, RPE #14254 - New Florence, Penna.