


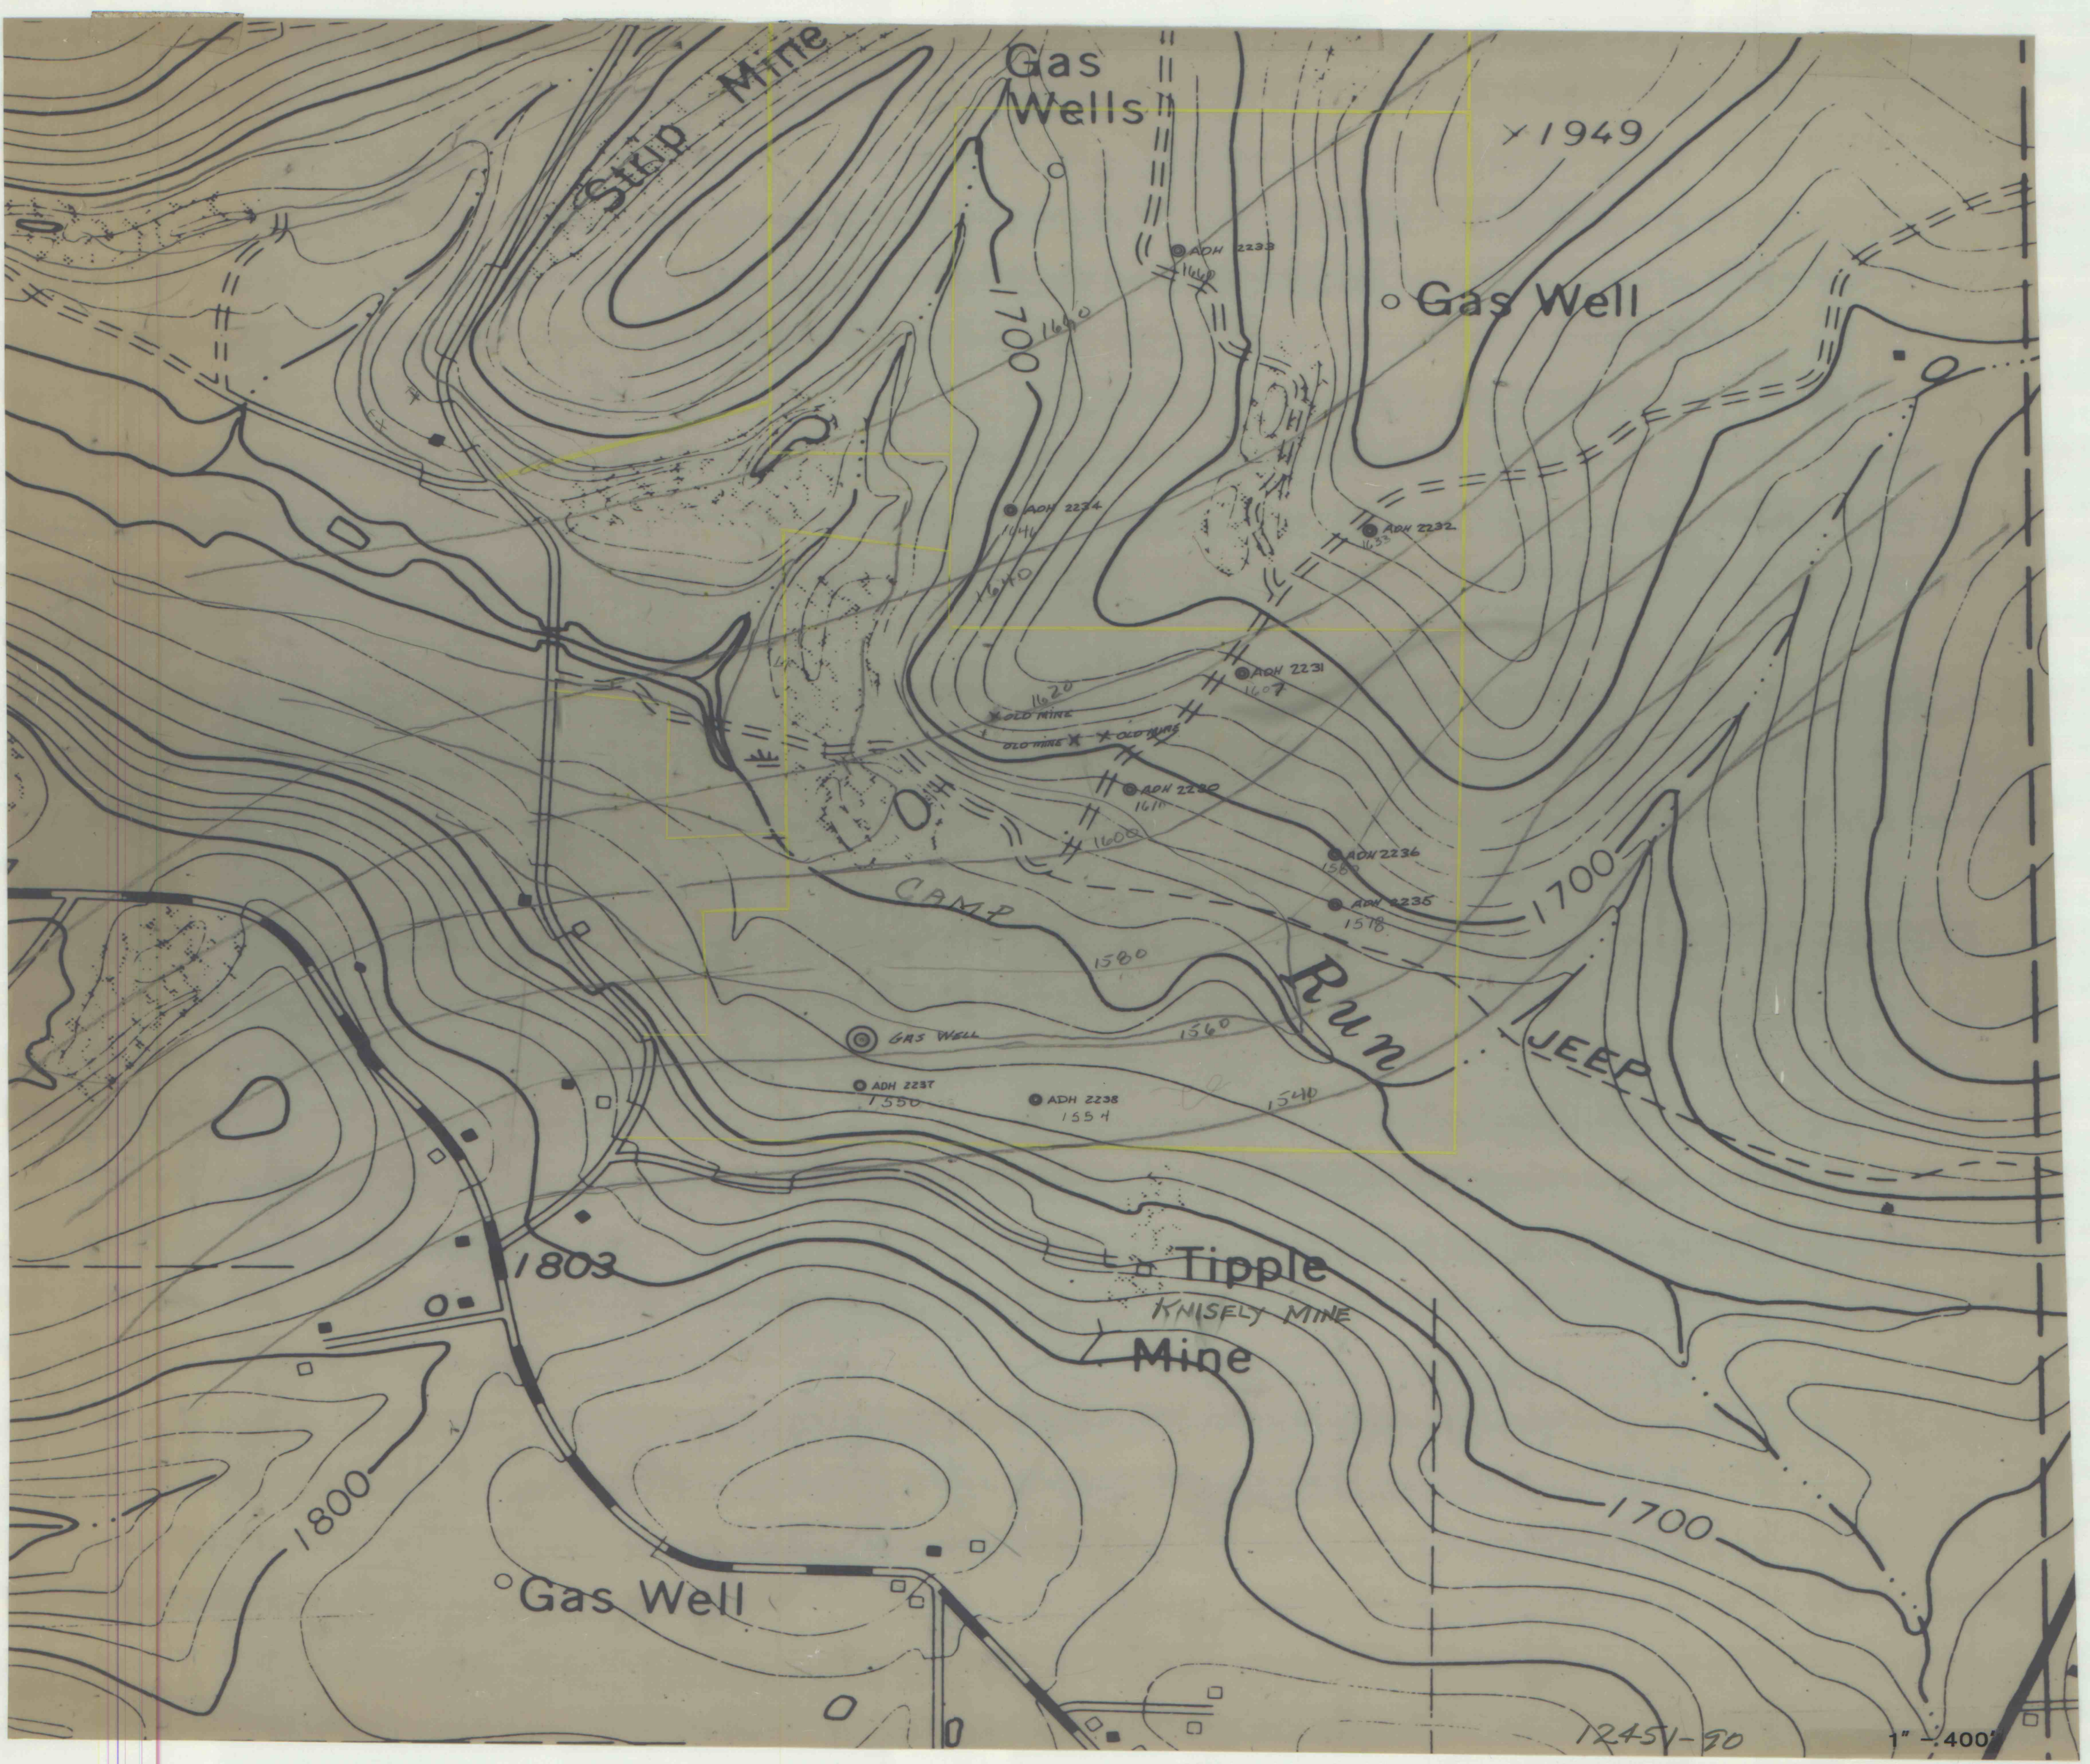

1949

Gas Well

Gas Wells

Strip Mine

CAMP

Run

JEEP

Tipple Mine
KNISELY MINE

Gas Well

12451-90

1" = 400'