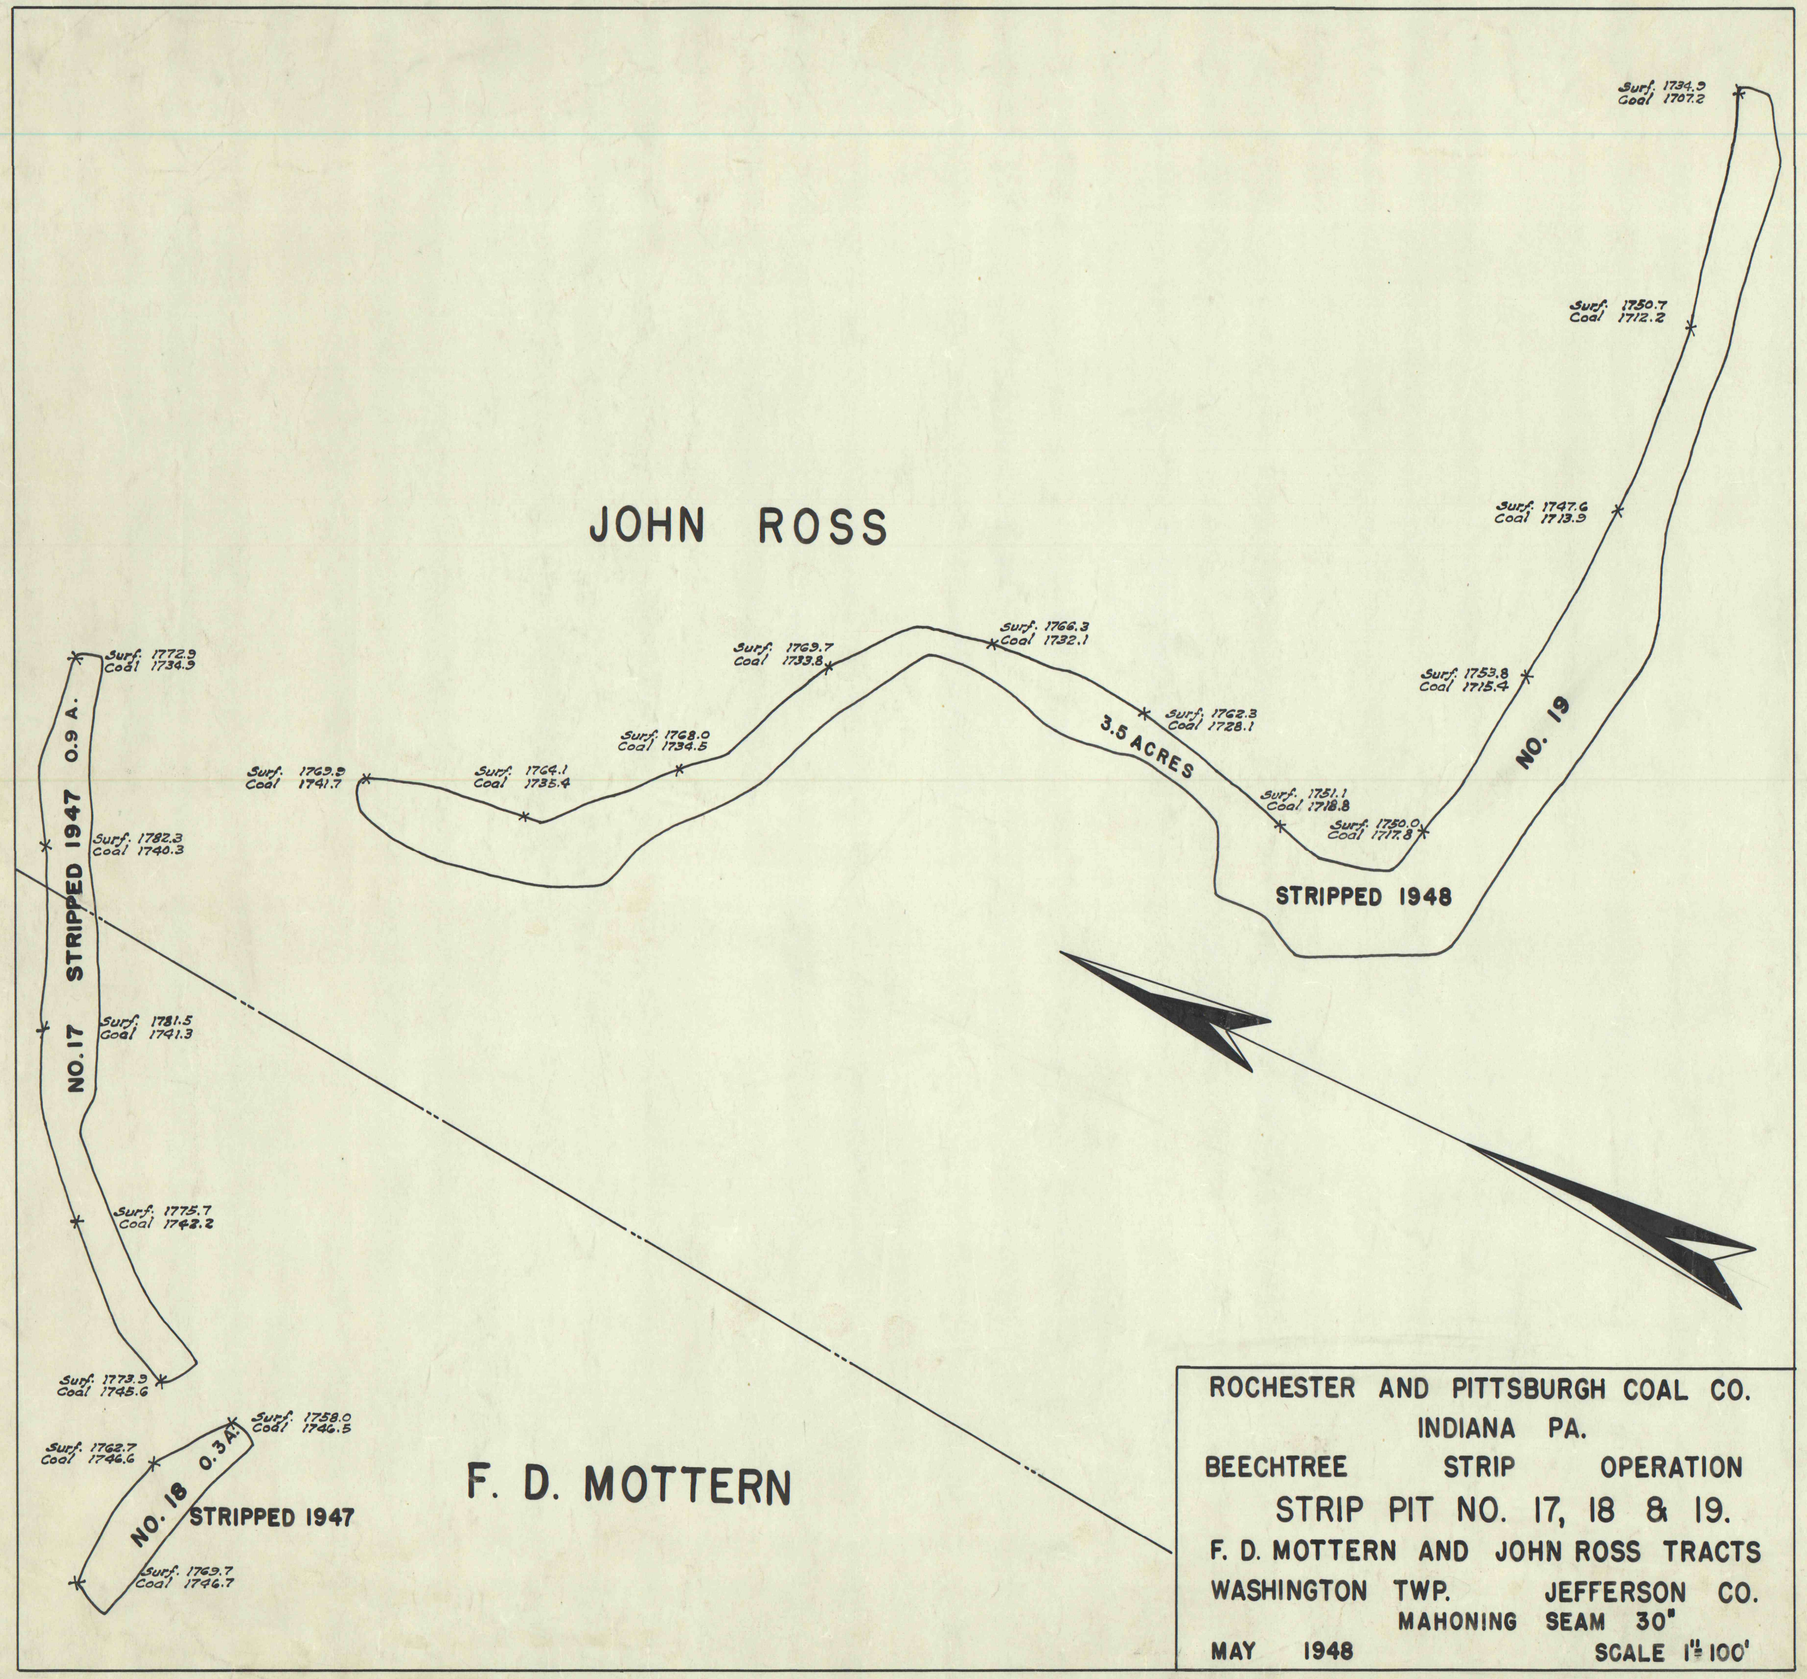


ROCHESTER AND PITTSBURGH COAL CO.
INDIANA PA.
BEECHTREE STRIP OPERATION
STRIP PIT NO. 17, 18 & 19.
F. D. MOTTERN AND JOHN ROSS TRACTS
WASHINGTON TWP. JEFFERSON CO.
MAHONING SEAM 30"
MAY 1948 SCALE 1" = 100'

12380-90