


101-19921

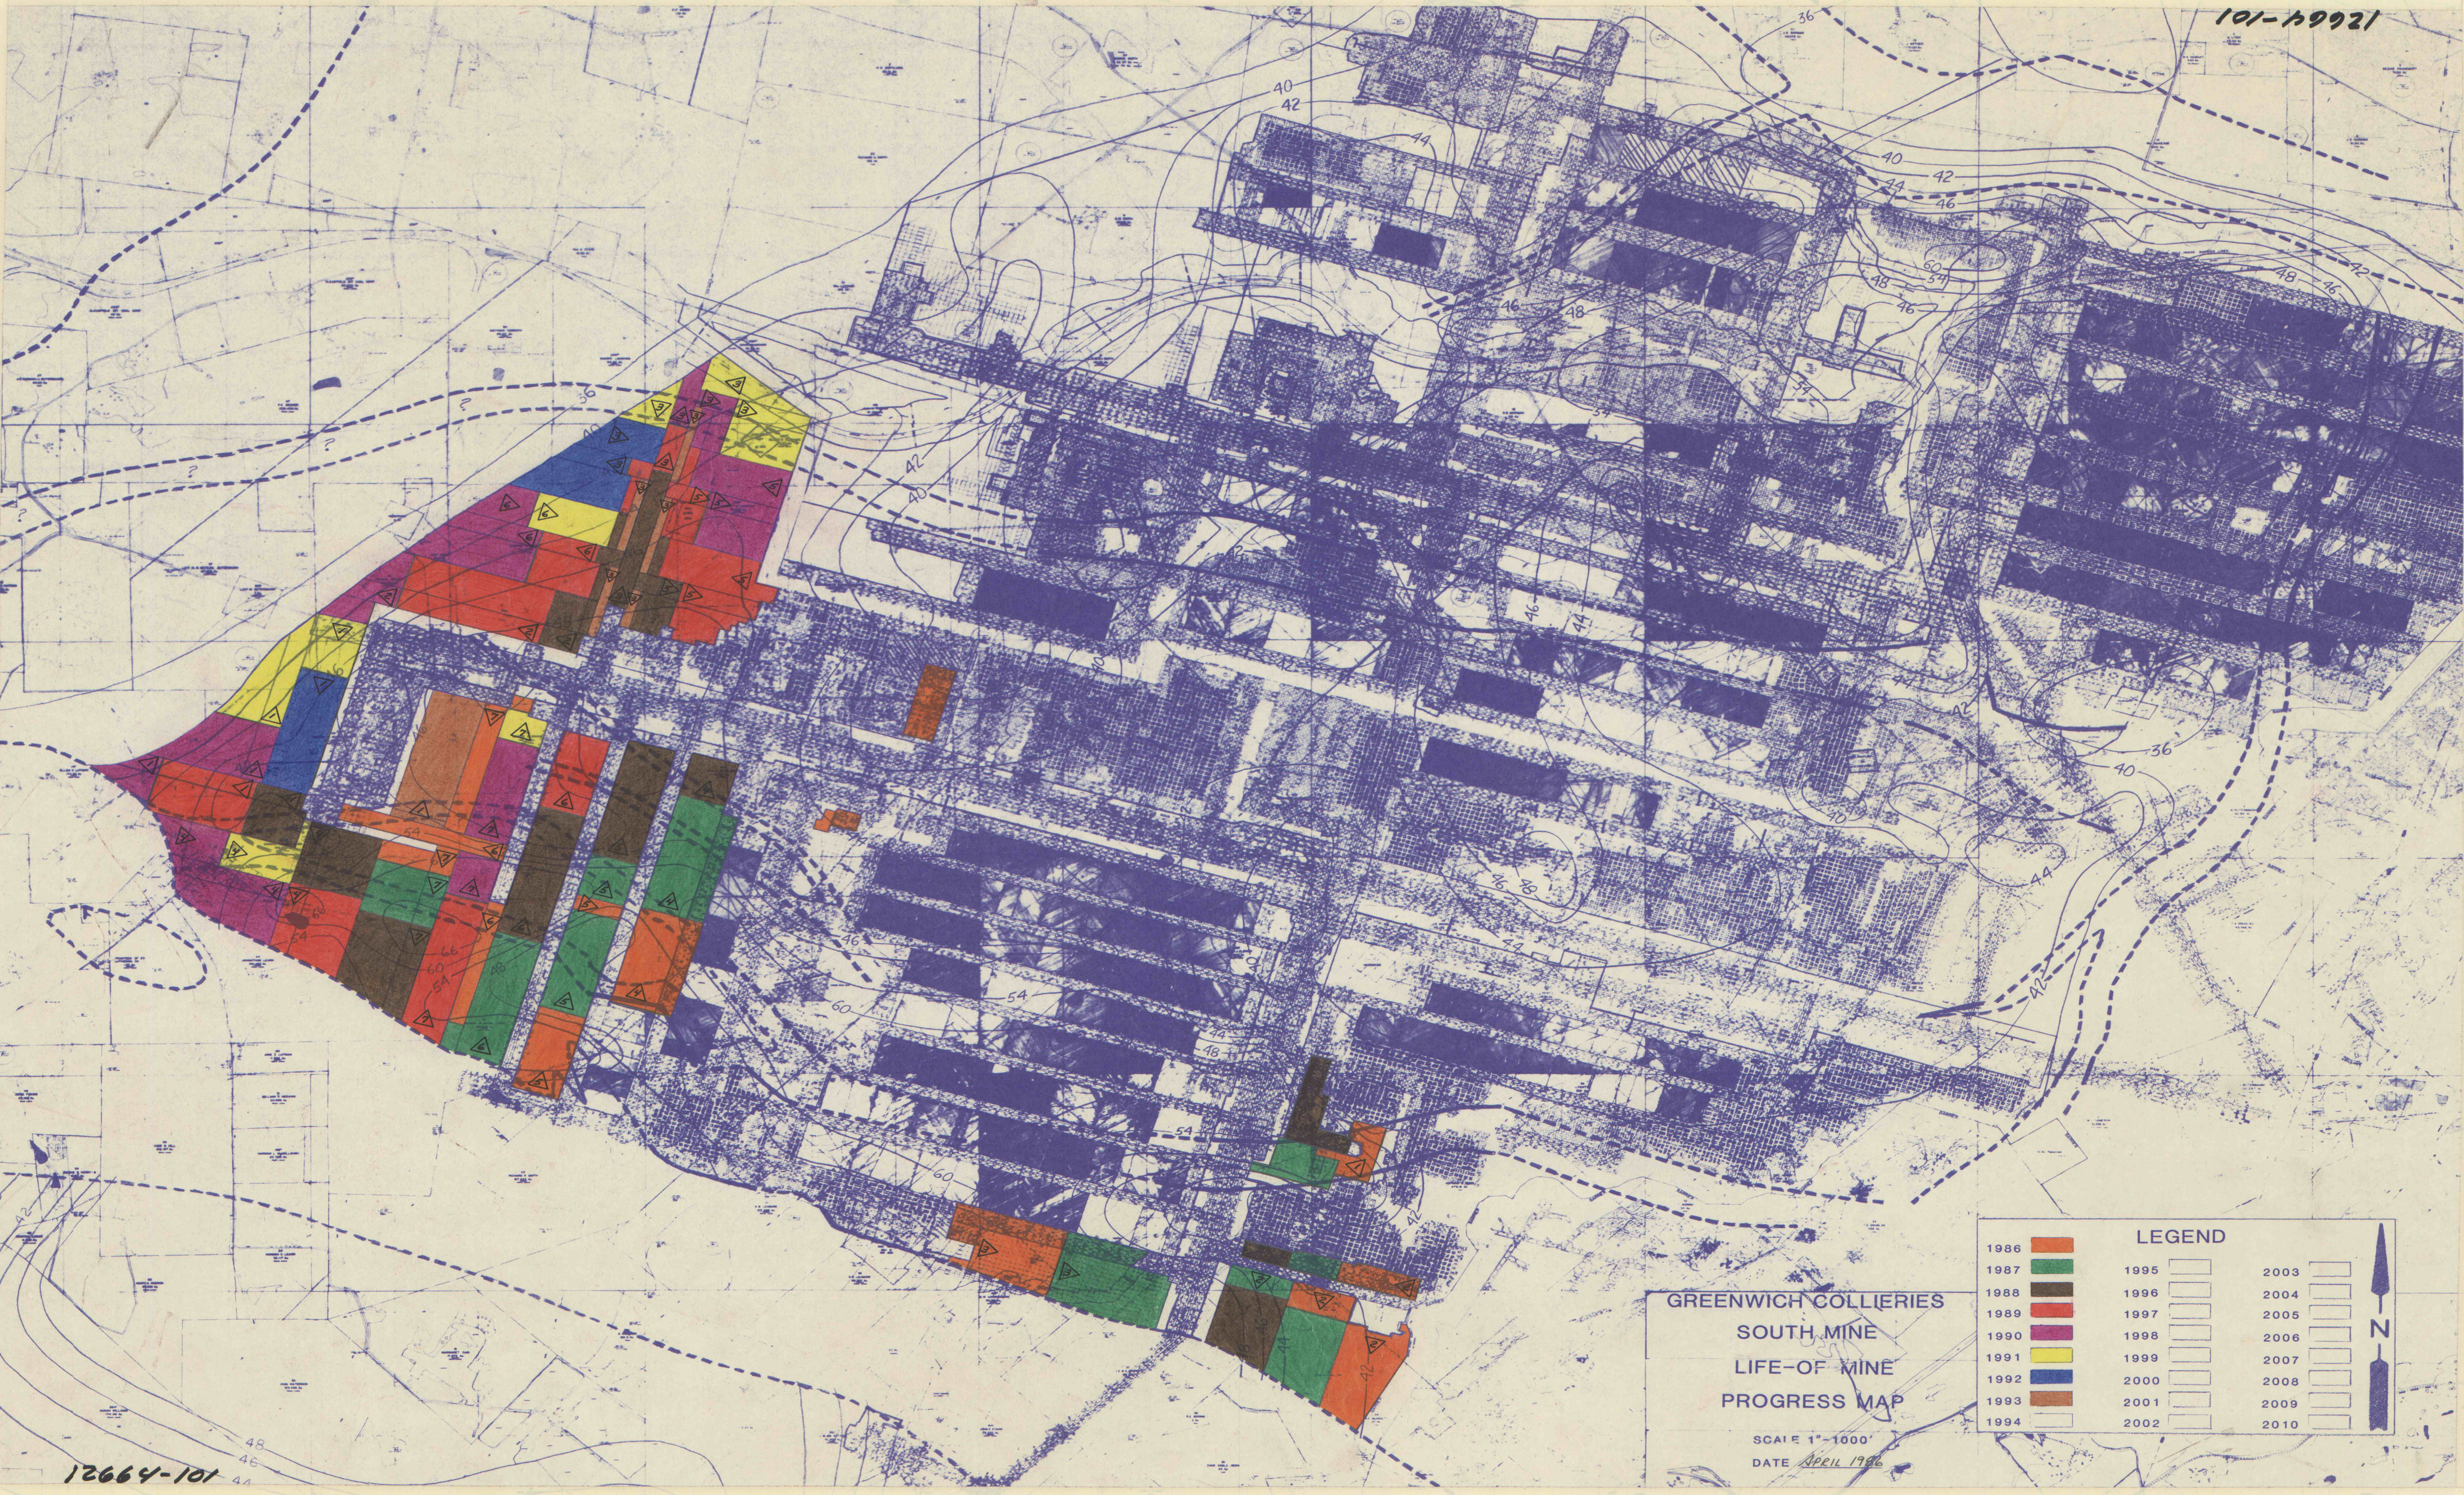

GREENWICH COLLIERIES
SOUTH MINE
LIFE-OF-MINE
PROGRESS MAP

SCALE 1"=1000'
DATE APRIL 1996

LEGEND					
1986		1995		2003	
1987		1996		2004	
1988		1997		2005	
1989		1998		2006	
1990		1999		2007	
1991		2000		2008	
1992		2001		2009	
1993		2002		2010	
1994					

12664-101