


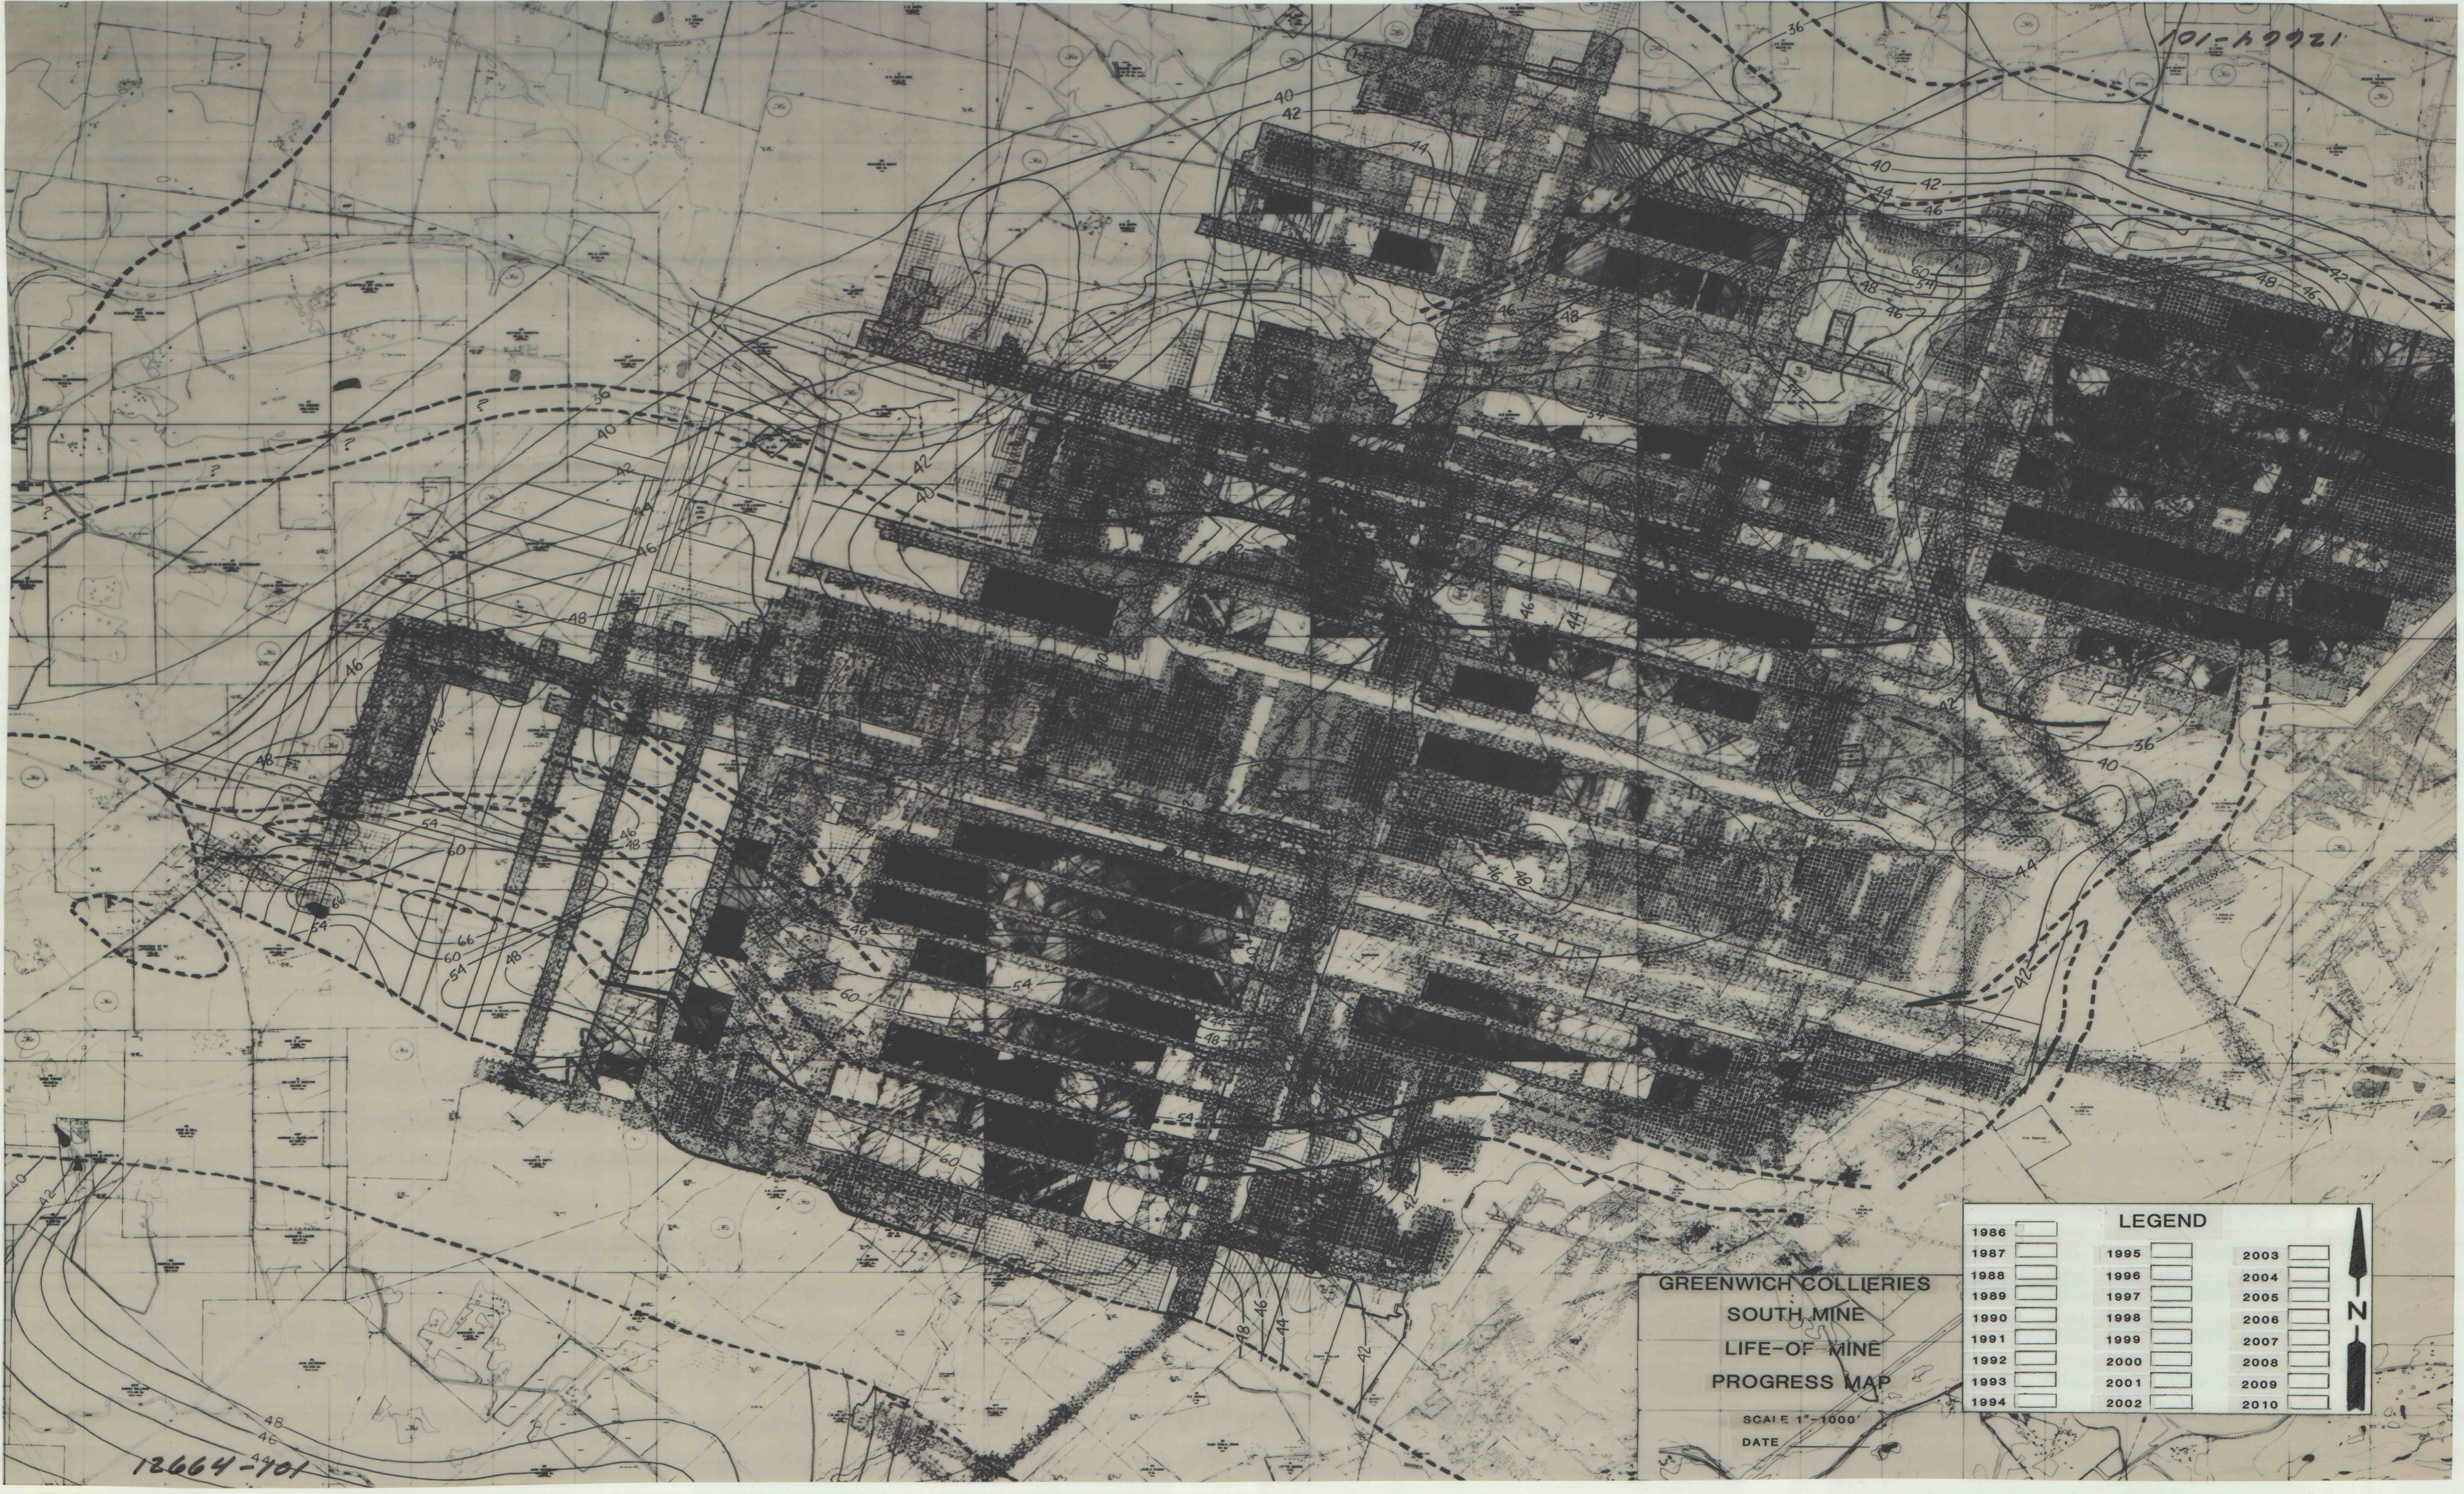

101-19921

12664-101

GREENWICH COLLIERIES
SOUTH MINE
LIFE-OF-MINE
PROGRESS MAP

SCALE 1" = 1000'
DATE

LEGEND					
1986	☐				
1987	☐	1995	☐	2003	☐
1988	☐	1996	☐	2004	☐
1989	☐	1997	☐	2005	☐
1990	☐	1998	☐	2006	☐
1991	☐	1999	☐	2007	☐
1992	☐	2000	☐	2008	☐
1993	☐	2001	☐	2009	☐
1994	☐	2002	☐	2010	☐

