


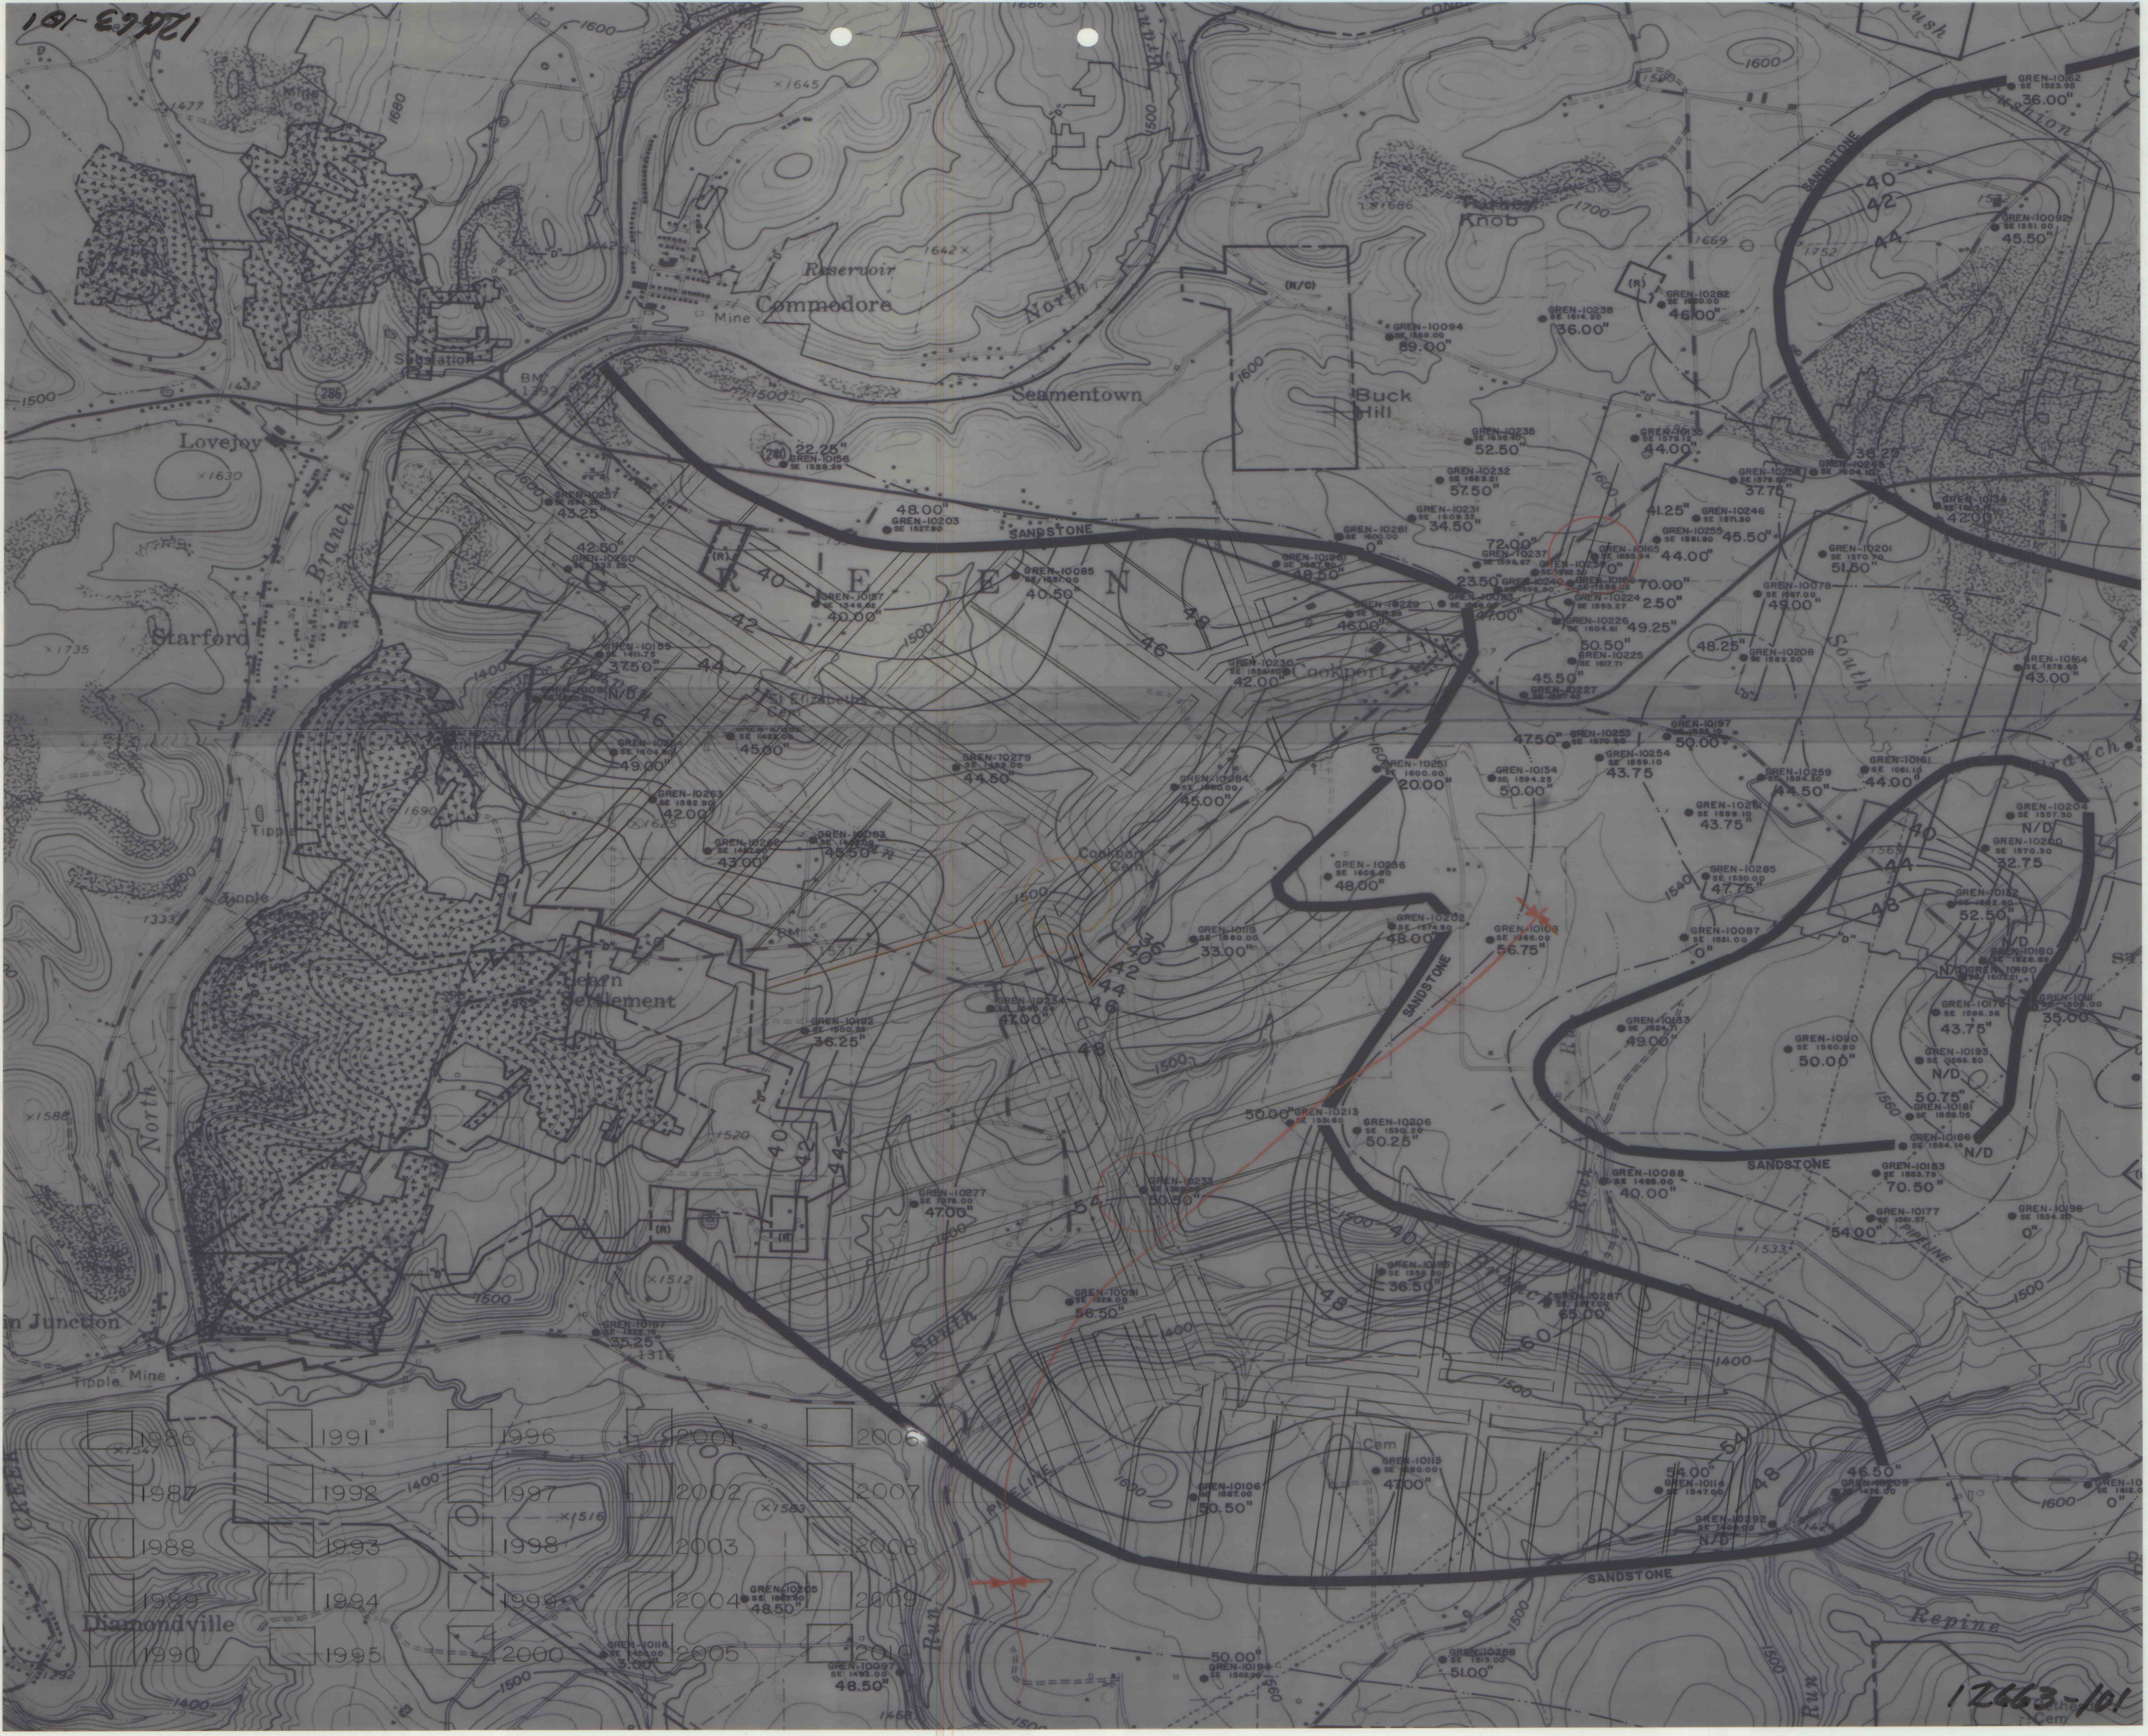

1986	1991	1996	2001	2006
1987	1992	1997	2002	2007
1988	1993	1998	2003	2008
1989	1994	1999	2004	2009
1990	1995	2000	2005	2010