


12660-101

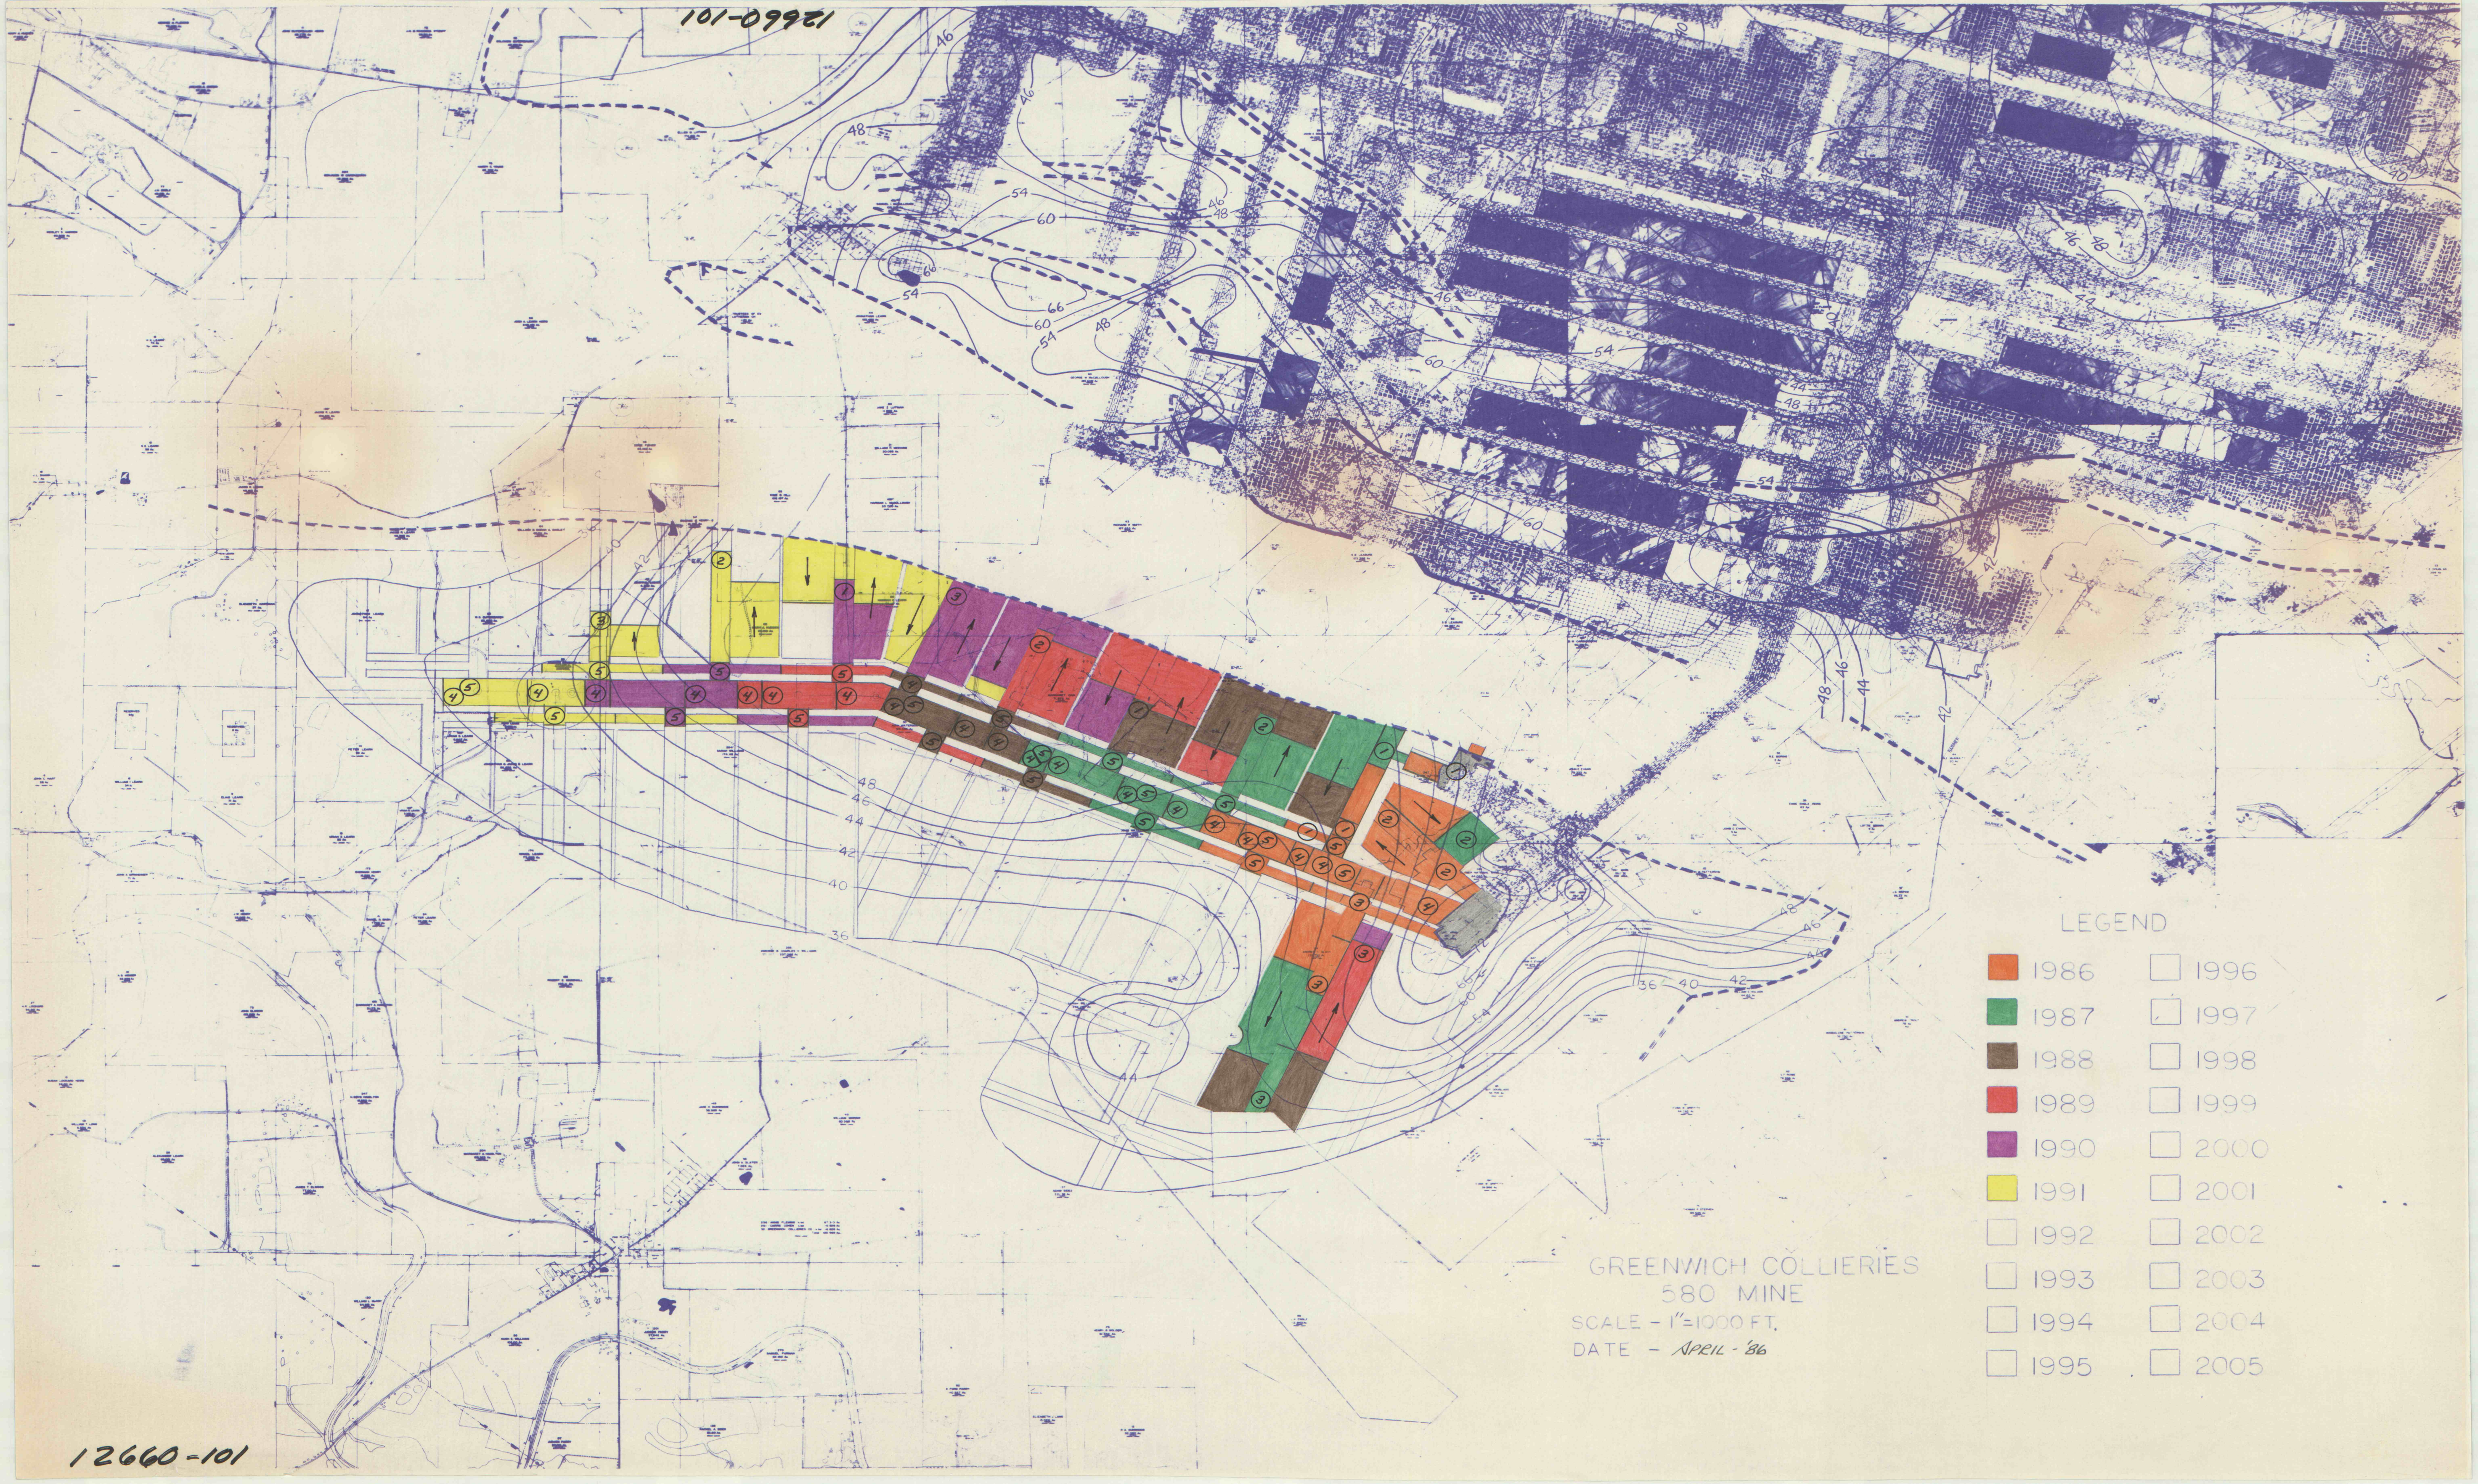

LEGEND

|      |      |
|------|------|
| 1986 | 1996 |
| 1987 | 1997 |
| 1988 | 1998 |
| 1989 | 1999 |
| 1990 | 2000 |
| 1991 | 2001 |
| 1992 | 2002 |
| 1993 | 2003 |
| 1994 | 2004 |
| 1995 | 2005 |

GREENWICH COLLIERIES  
580 MINE  
SCALE - 1"=1000 FT.  
DATE - APRIL - '86

12660-101