


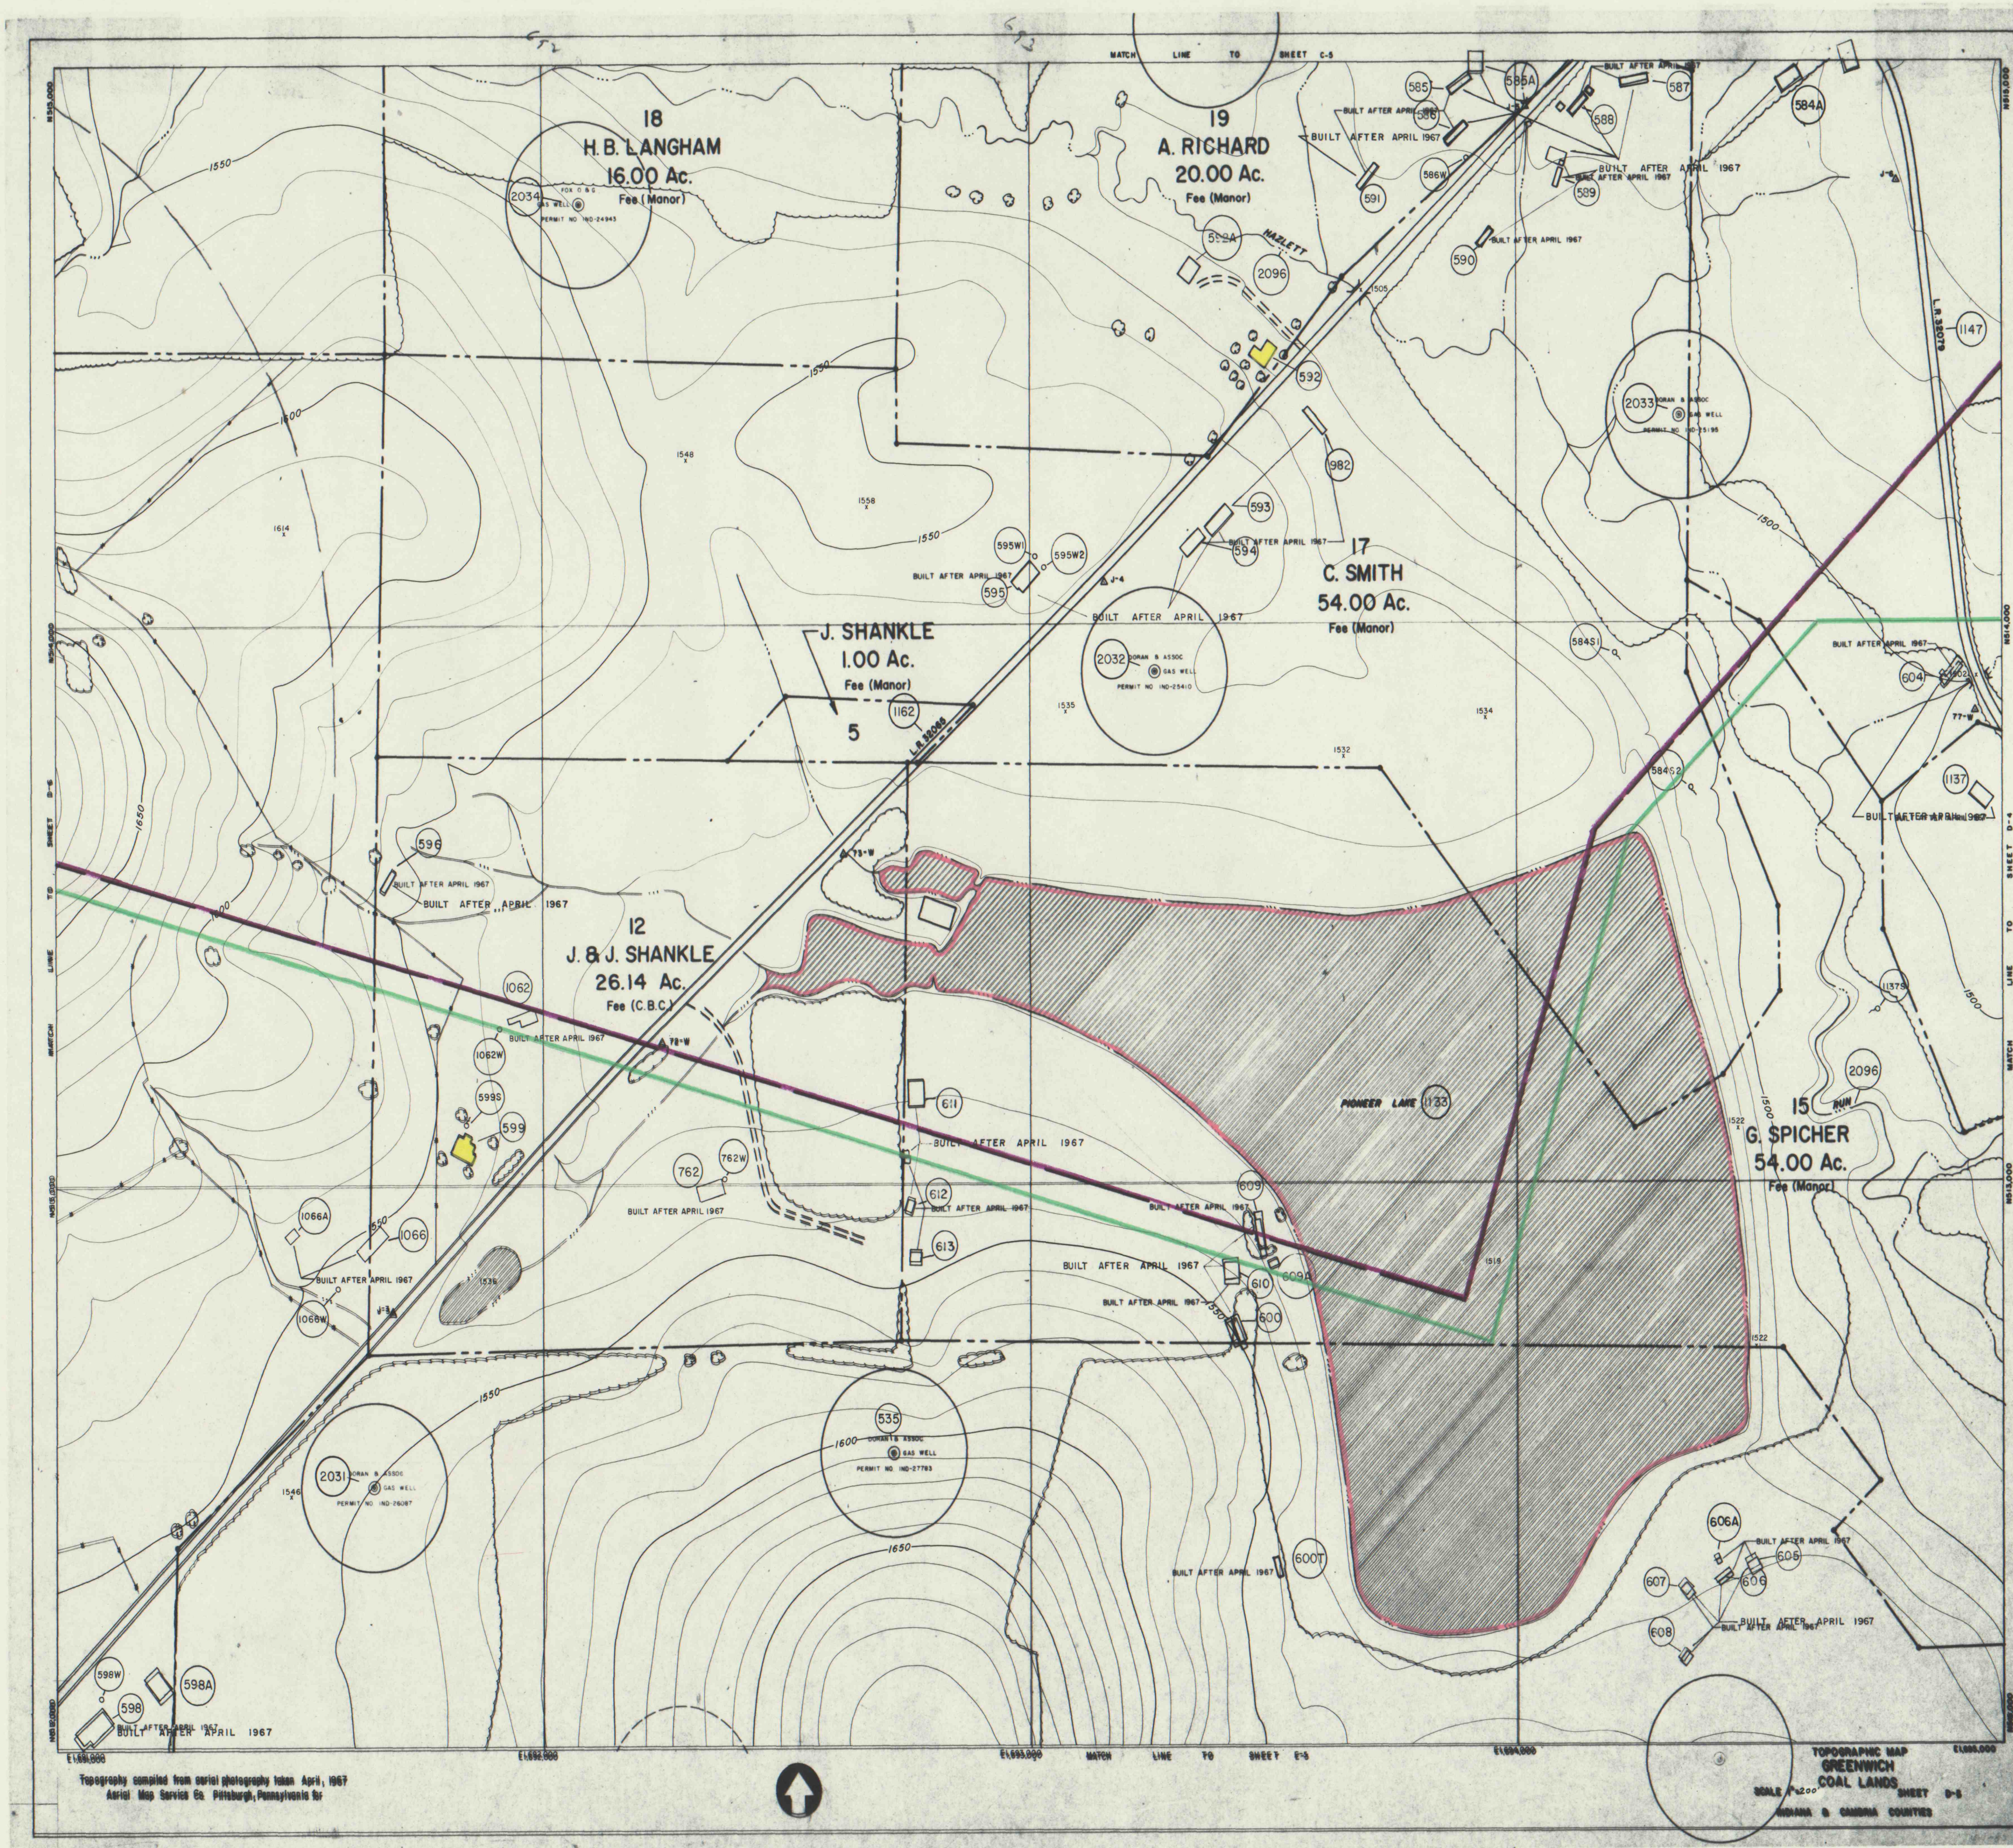


EXHIBIT "A"

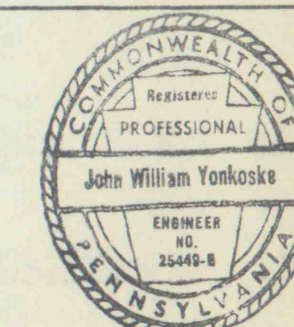

GREENWICH COLLIERIES NO'S 1 AND 2 MINES DIV. OF PENNSYLVANIA MINES CORP.

GREEN & MONTGOMERY TOWNSHIPS. INDIANA COUNTY, PA.
SCALE 1"=200' SURVEY DATE 10-1-83
PERIOD COVERED 10-1-83 THRU 1990
(REVISED JULY 1995)

DWELLINGS & CEMETERIES (IN PLACE BEFORE 1966 ACT) ■
PUBLIC BUILDINGS; IMPOUNDMENTS (PLUS 20 AC. FEET) ■
BOUNDARY OF MINE ■
POLITICAL SUBDIVISION BOUNDARIES ■
SUBSIDENCE CONTROL PLAN BOUNDARY ■
PERMIT BOUNDARY ■
FEATURE IDENTIFICATION NO. 1