


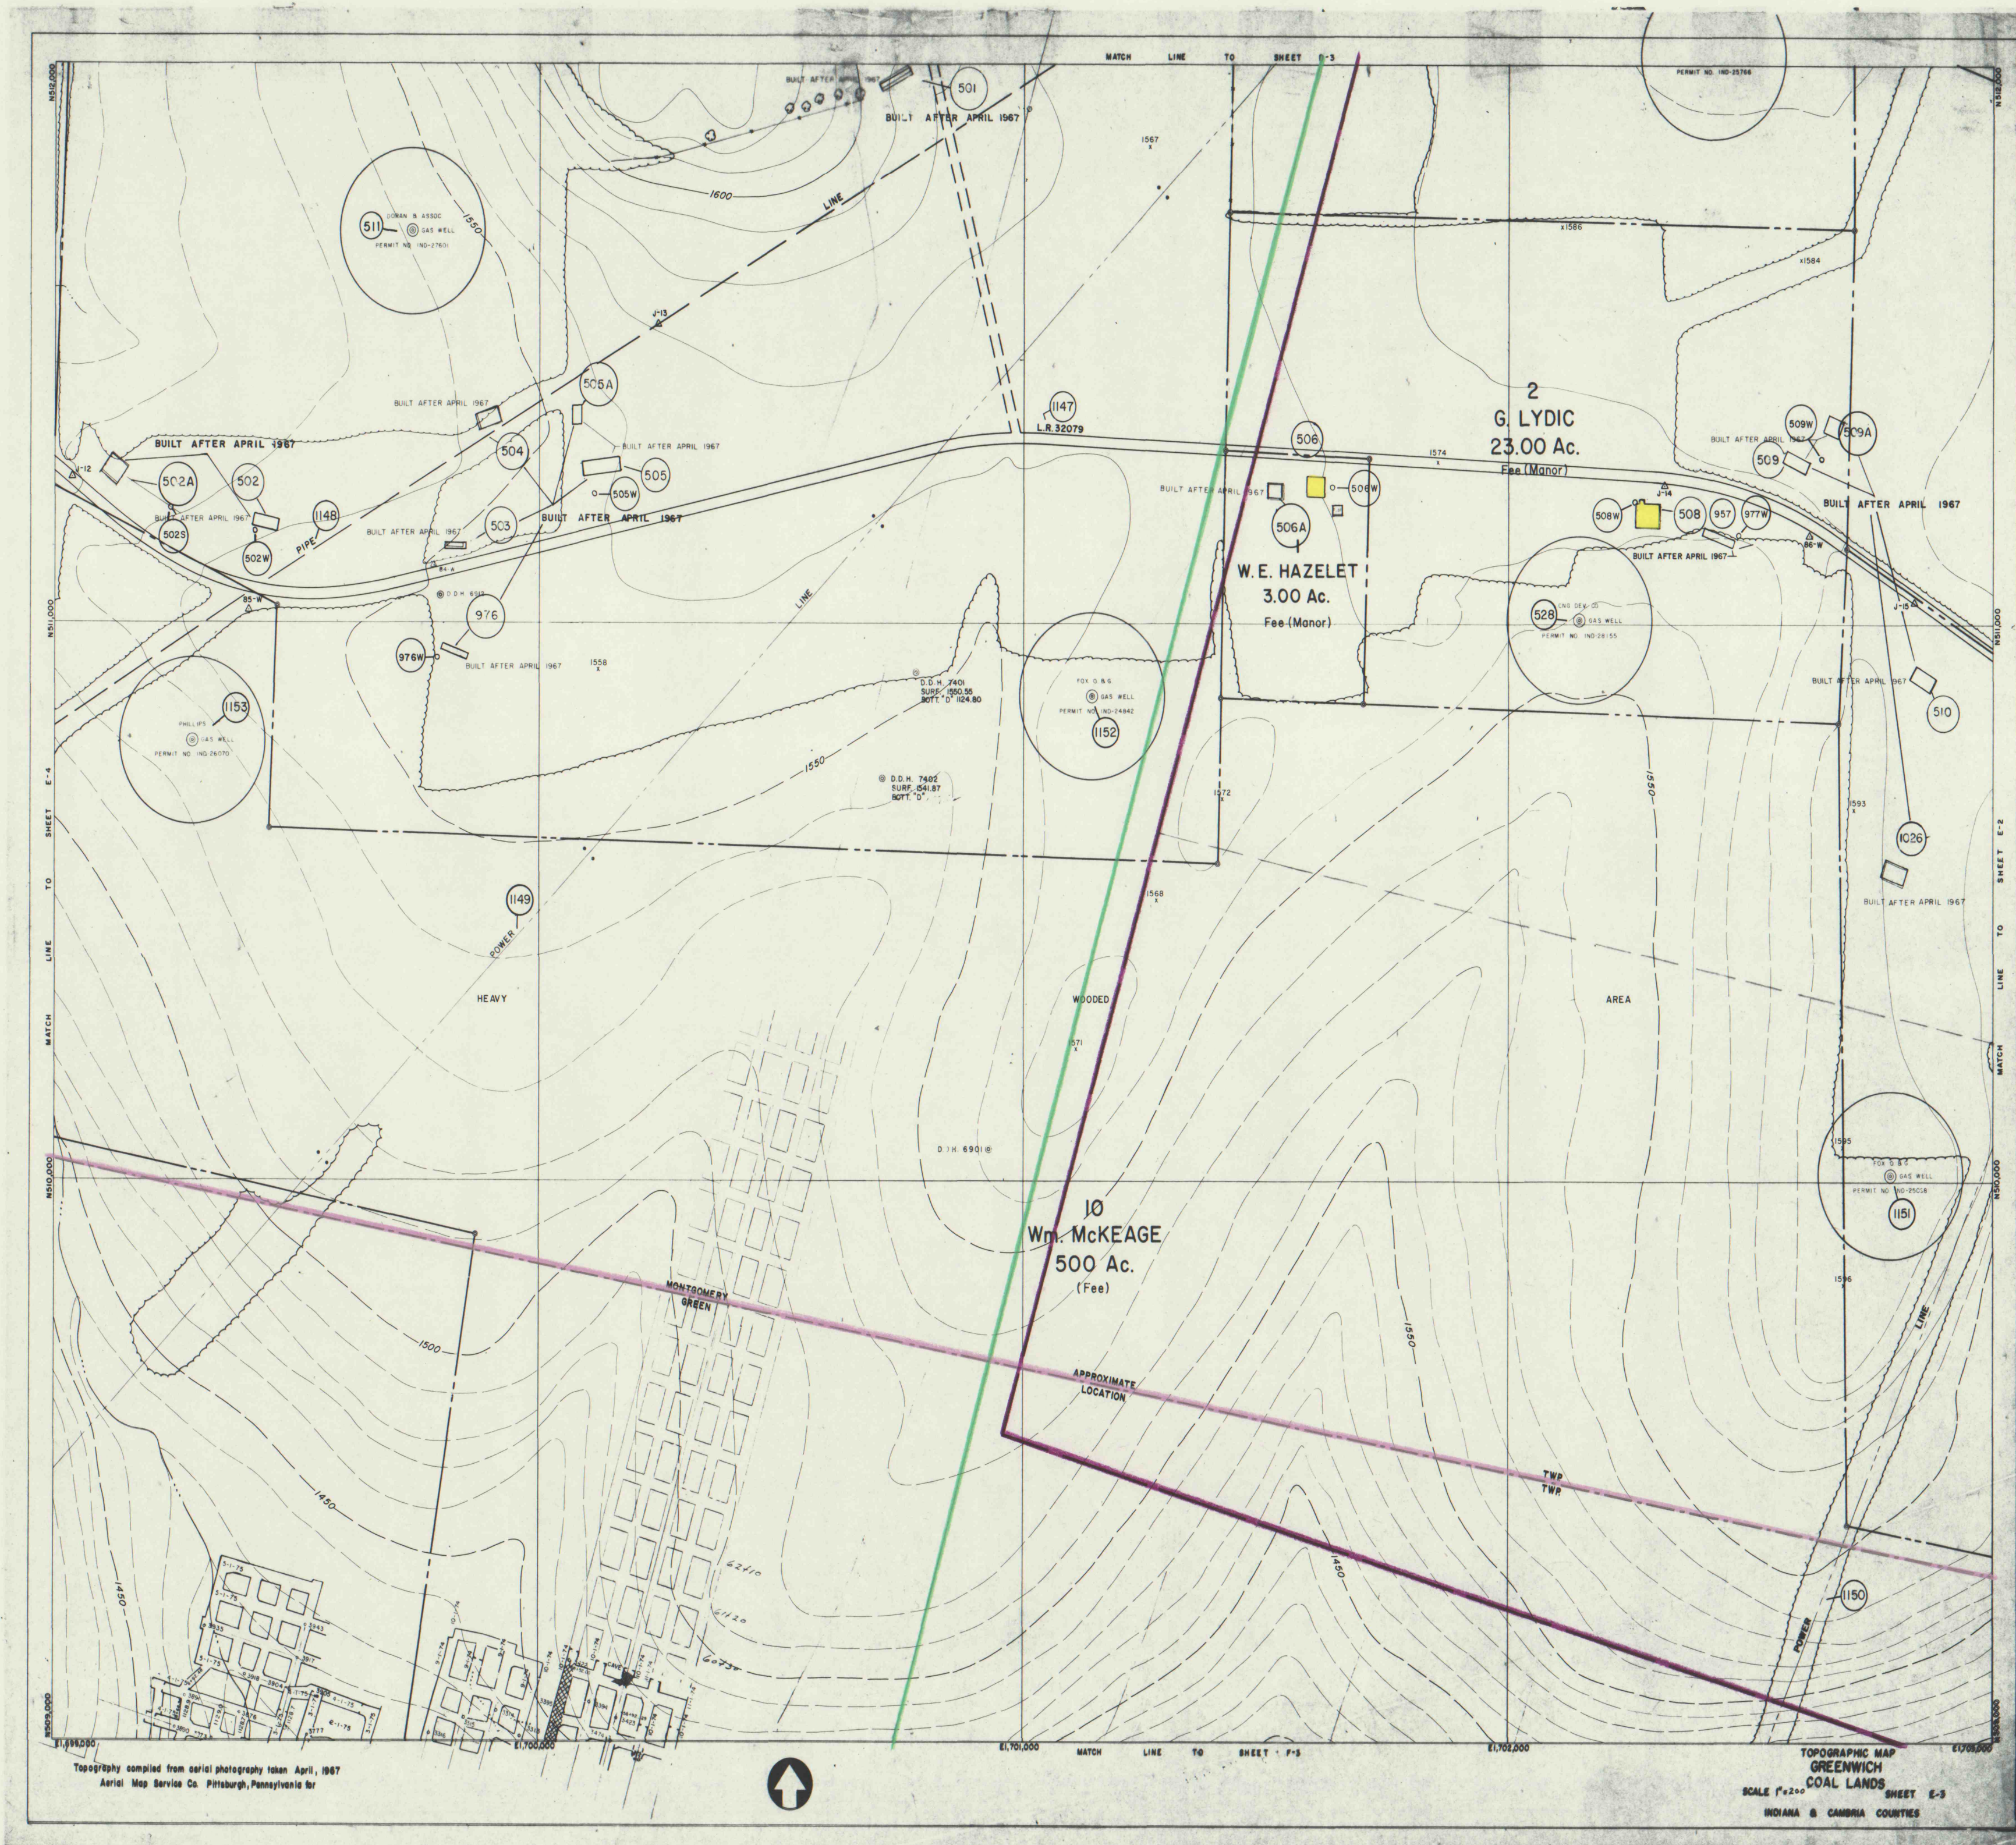


EXHIBIT "A"

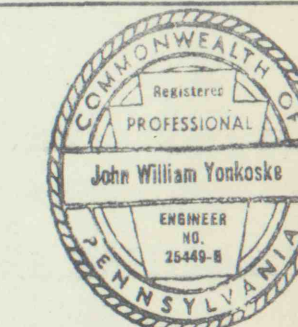

GREENWICH COLLIERIES NO'S 1 AND 2 MINES

DIV. OF PENNSYLVANIA MINES CORP.

GREEN & MONTGOMERY TWPS. INDIANA COUNTY, PA.

SCALE 1"=200' SURVEY DATE 10-1-83
(REVISED - JULY 1985)
PERIOD COVERED 10-1-83 THRU 1990

DWELLINGS & CEMETERIES (IN PLACE BEFORE 1966 ACT) ■
PUBLIC BUILDINGS; IMPOUNDMENTS (PLUS 20 AC. FEET) ■
BOUNDARY OF MINE —
POLITICAL SUBDIVISION BOUNDARIES —
SUBSIDENCE CONTROL PLAN BOUNDARY —
PERMIT BOUNDARY —
FEATURE IDENTIFICATION NO. 1