


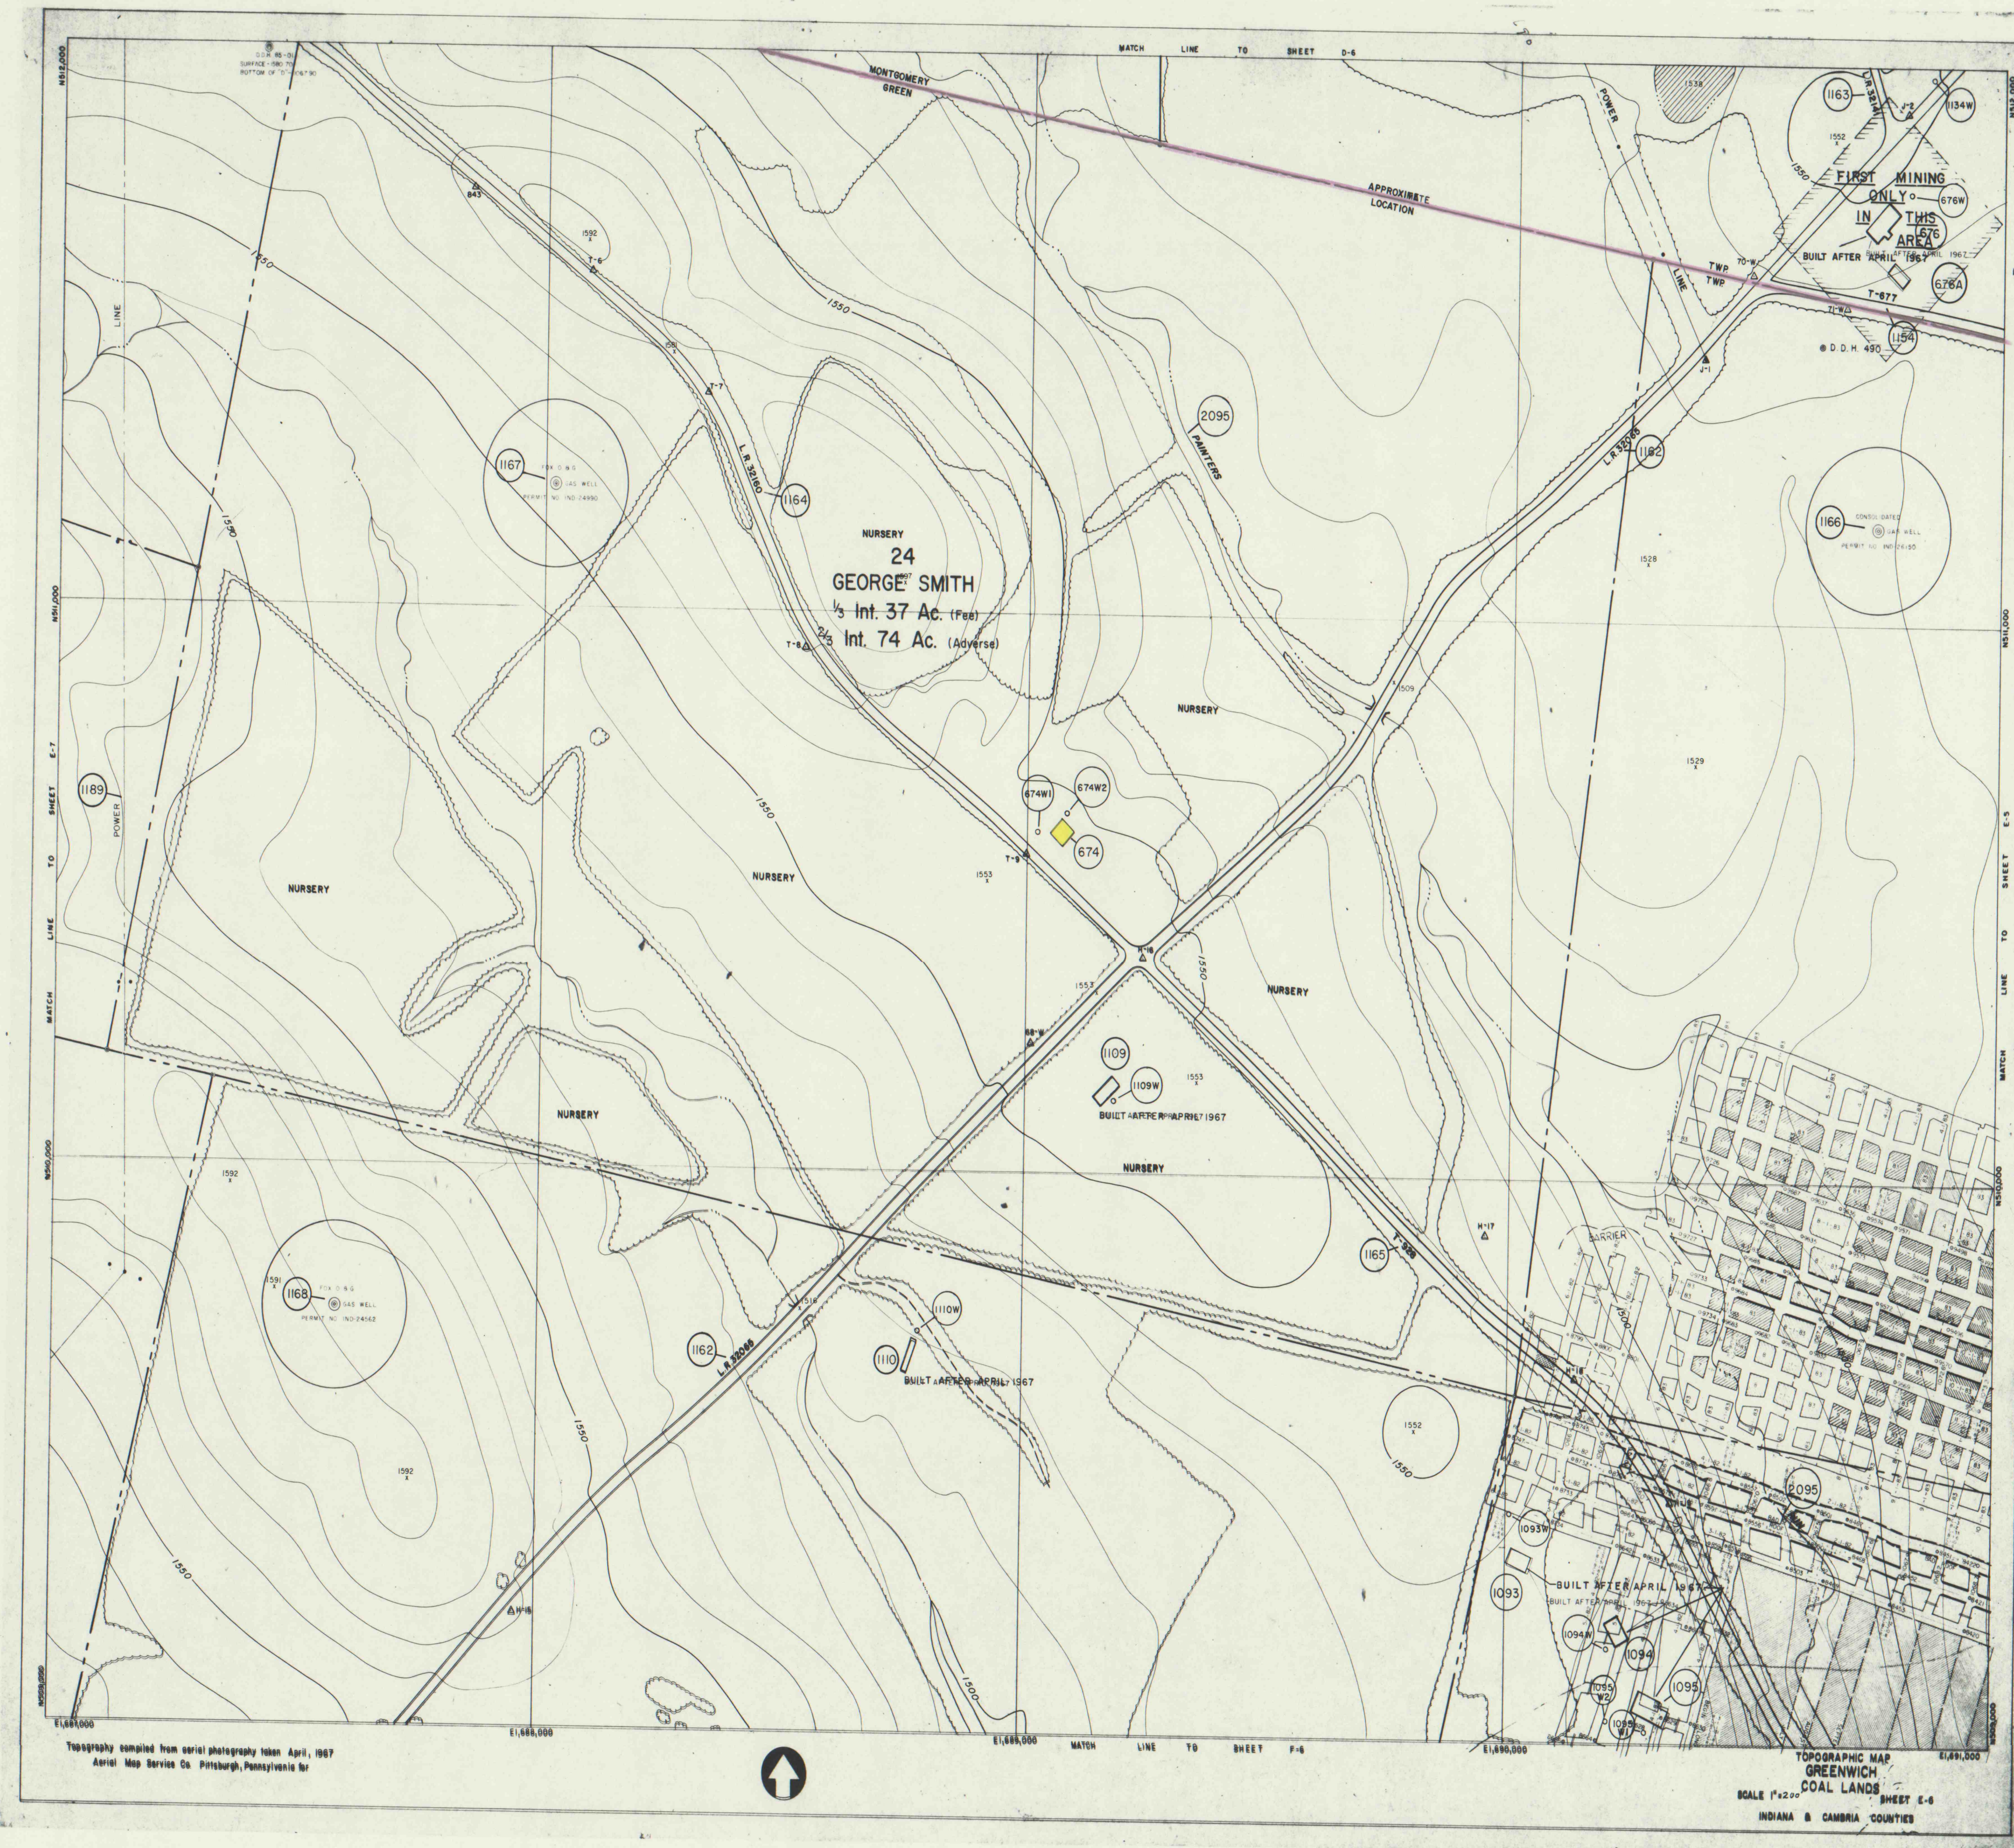


EXHIBIT "A"

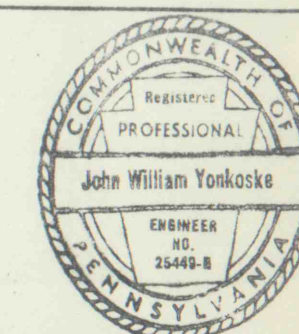

John W. Yonkoske

GREENWICH COLLIERIES

NO'S 1 AND 2 MINES

DIV. OF PENNSYLVANIA MINES CORP.

GREEN & MONTGOMERY TOWNSHIPS. INDIANA COUNTY, PA.

SCALE 1"=200' SURVEY DATE 10-1-83

PERIOD COVERED 10-1-83 THRU 1990

- DWELLINGS & CEMETERIES (IN PLACE BEFORE 1966 ACT)
- PUBLIC BUILDINGS; IMPOUNDMENTS (PLUS 20 AC. FEET)
- BOUNDARY OF MINE
- POLITICAL SUBDIVISION BOUNDARIES
- SUBSIDENCE CONTROL PLAN BOUNDARY
- PERMIT BOUNDARY
- FEATURE IDENTIFICATION NO.