



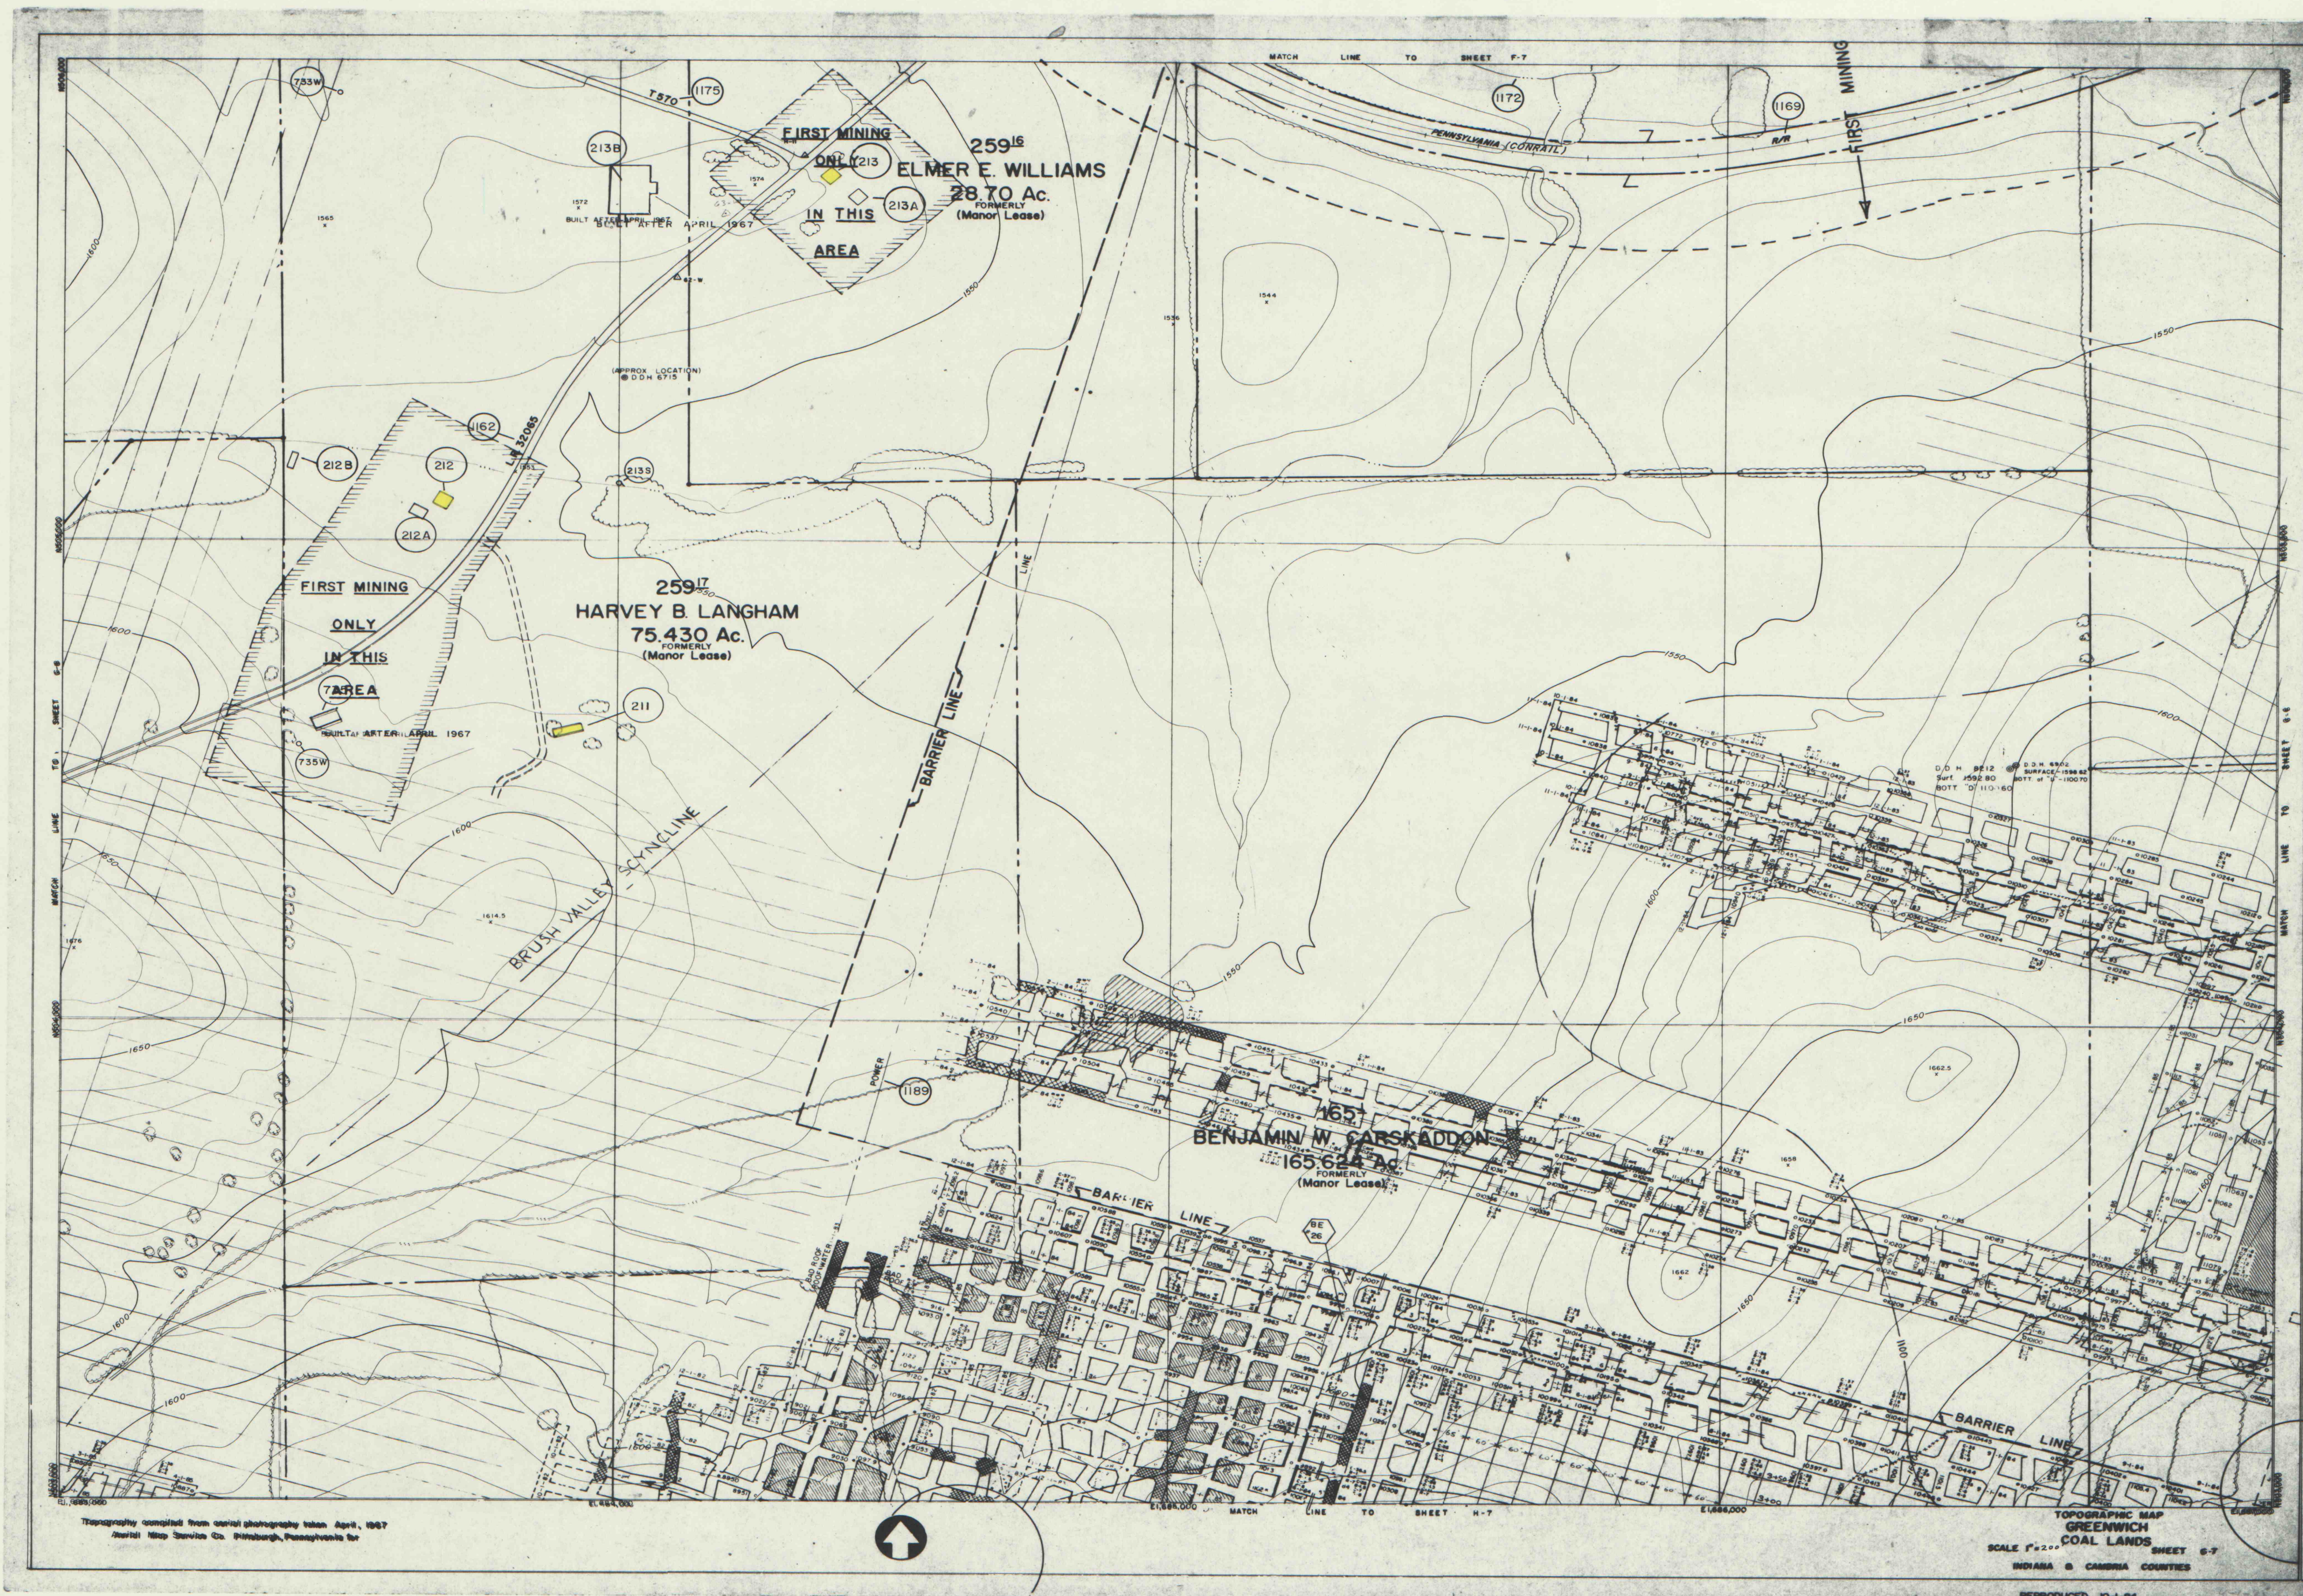

## EXHIBIT "A"

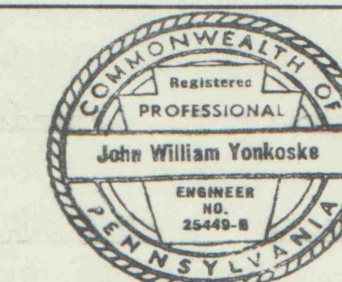

*John W. Yonkoske*  
**GREENWICH COLLIERIES**  
**NO'S 1 AND 2 MINES**  
**DIV. OF PENNSYLVANIA MINES CORP.**

GREEN & MONTGOMERY TWPS. INDIANA COUNTY, PA.  
SCALE 1"=200' SURVEY DATE 10-1-83  
(REVISED - JULY 1985)  
PERIOD COVERED 10-1-83 THRU 1990

DWELLINGS & CEMETERIES (IN PLACE BEFORE 1966 ACT) ■  
PUBLIC BUILDINGS; IMPOUNDMENTS (PLUS 20 AC. FEET) ■  
BOUNDARY OF MINE ■  
POLITICAL SUBDIVISION BOUNDARIES ■  
SUBSIDENCE CONTROL PLAN BOUNDARY ■  
PERMIT BOUNDARY ■  
FEATURE IDENTIFICATION NO. 1