




Topography compiled from aerial photography taken April, 1967
Aerial Map Service Co. Pittsburgh, Pennsylvania for

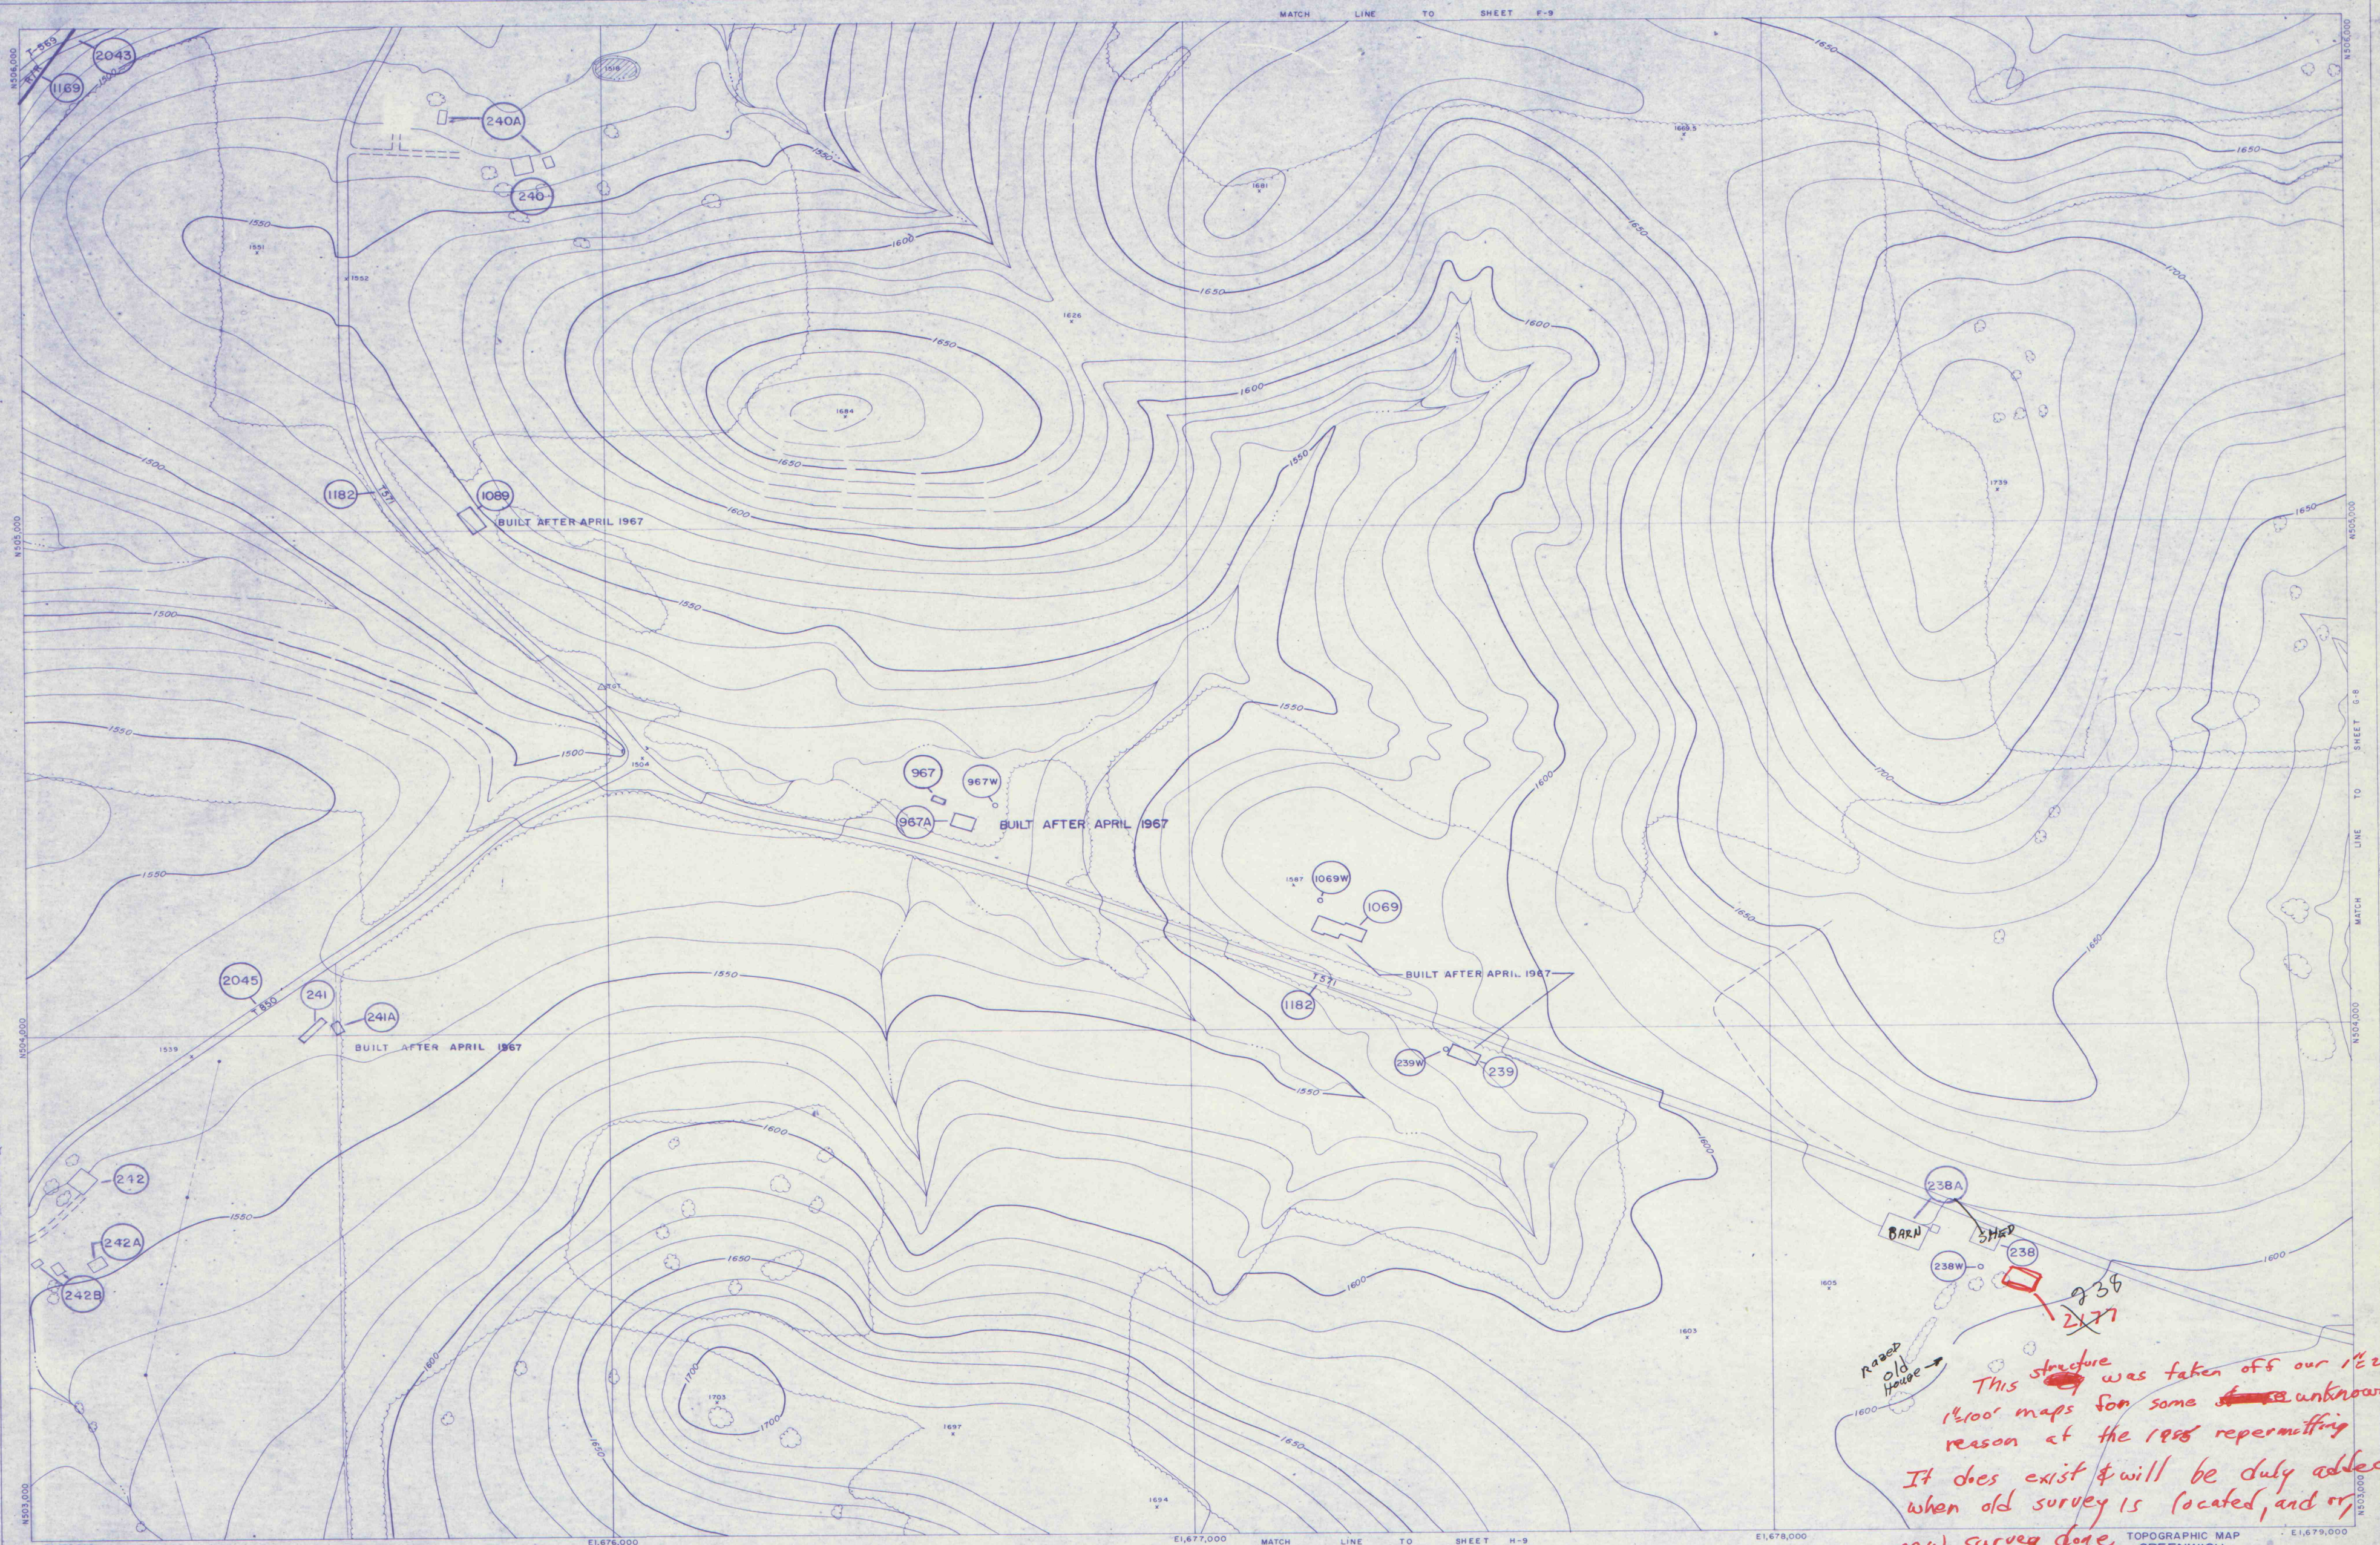

This structure was taken off our 18200 & 18100 maps for some ~~of~~ unknown reason at the 1958 repermitting. It does exist & will be duly added when old survey is located, and/or, new survey done.

TOPOGRAPHIC MAP
GREENWICH
COAL LANDS
SCALE 1"=200' SHEET G-9
INDIANA & CAMBRIA COUNTIES