


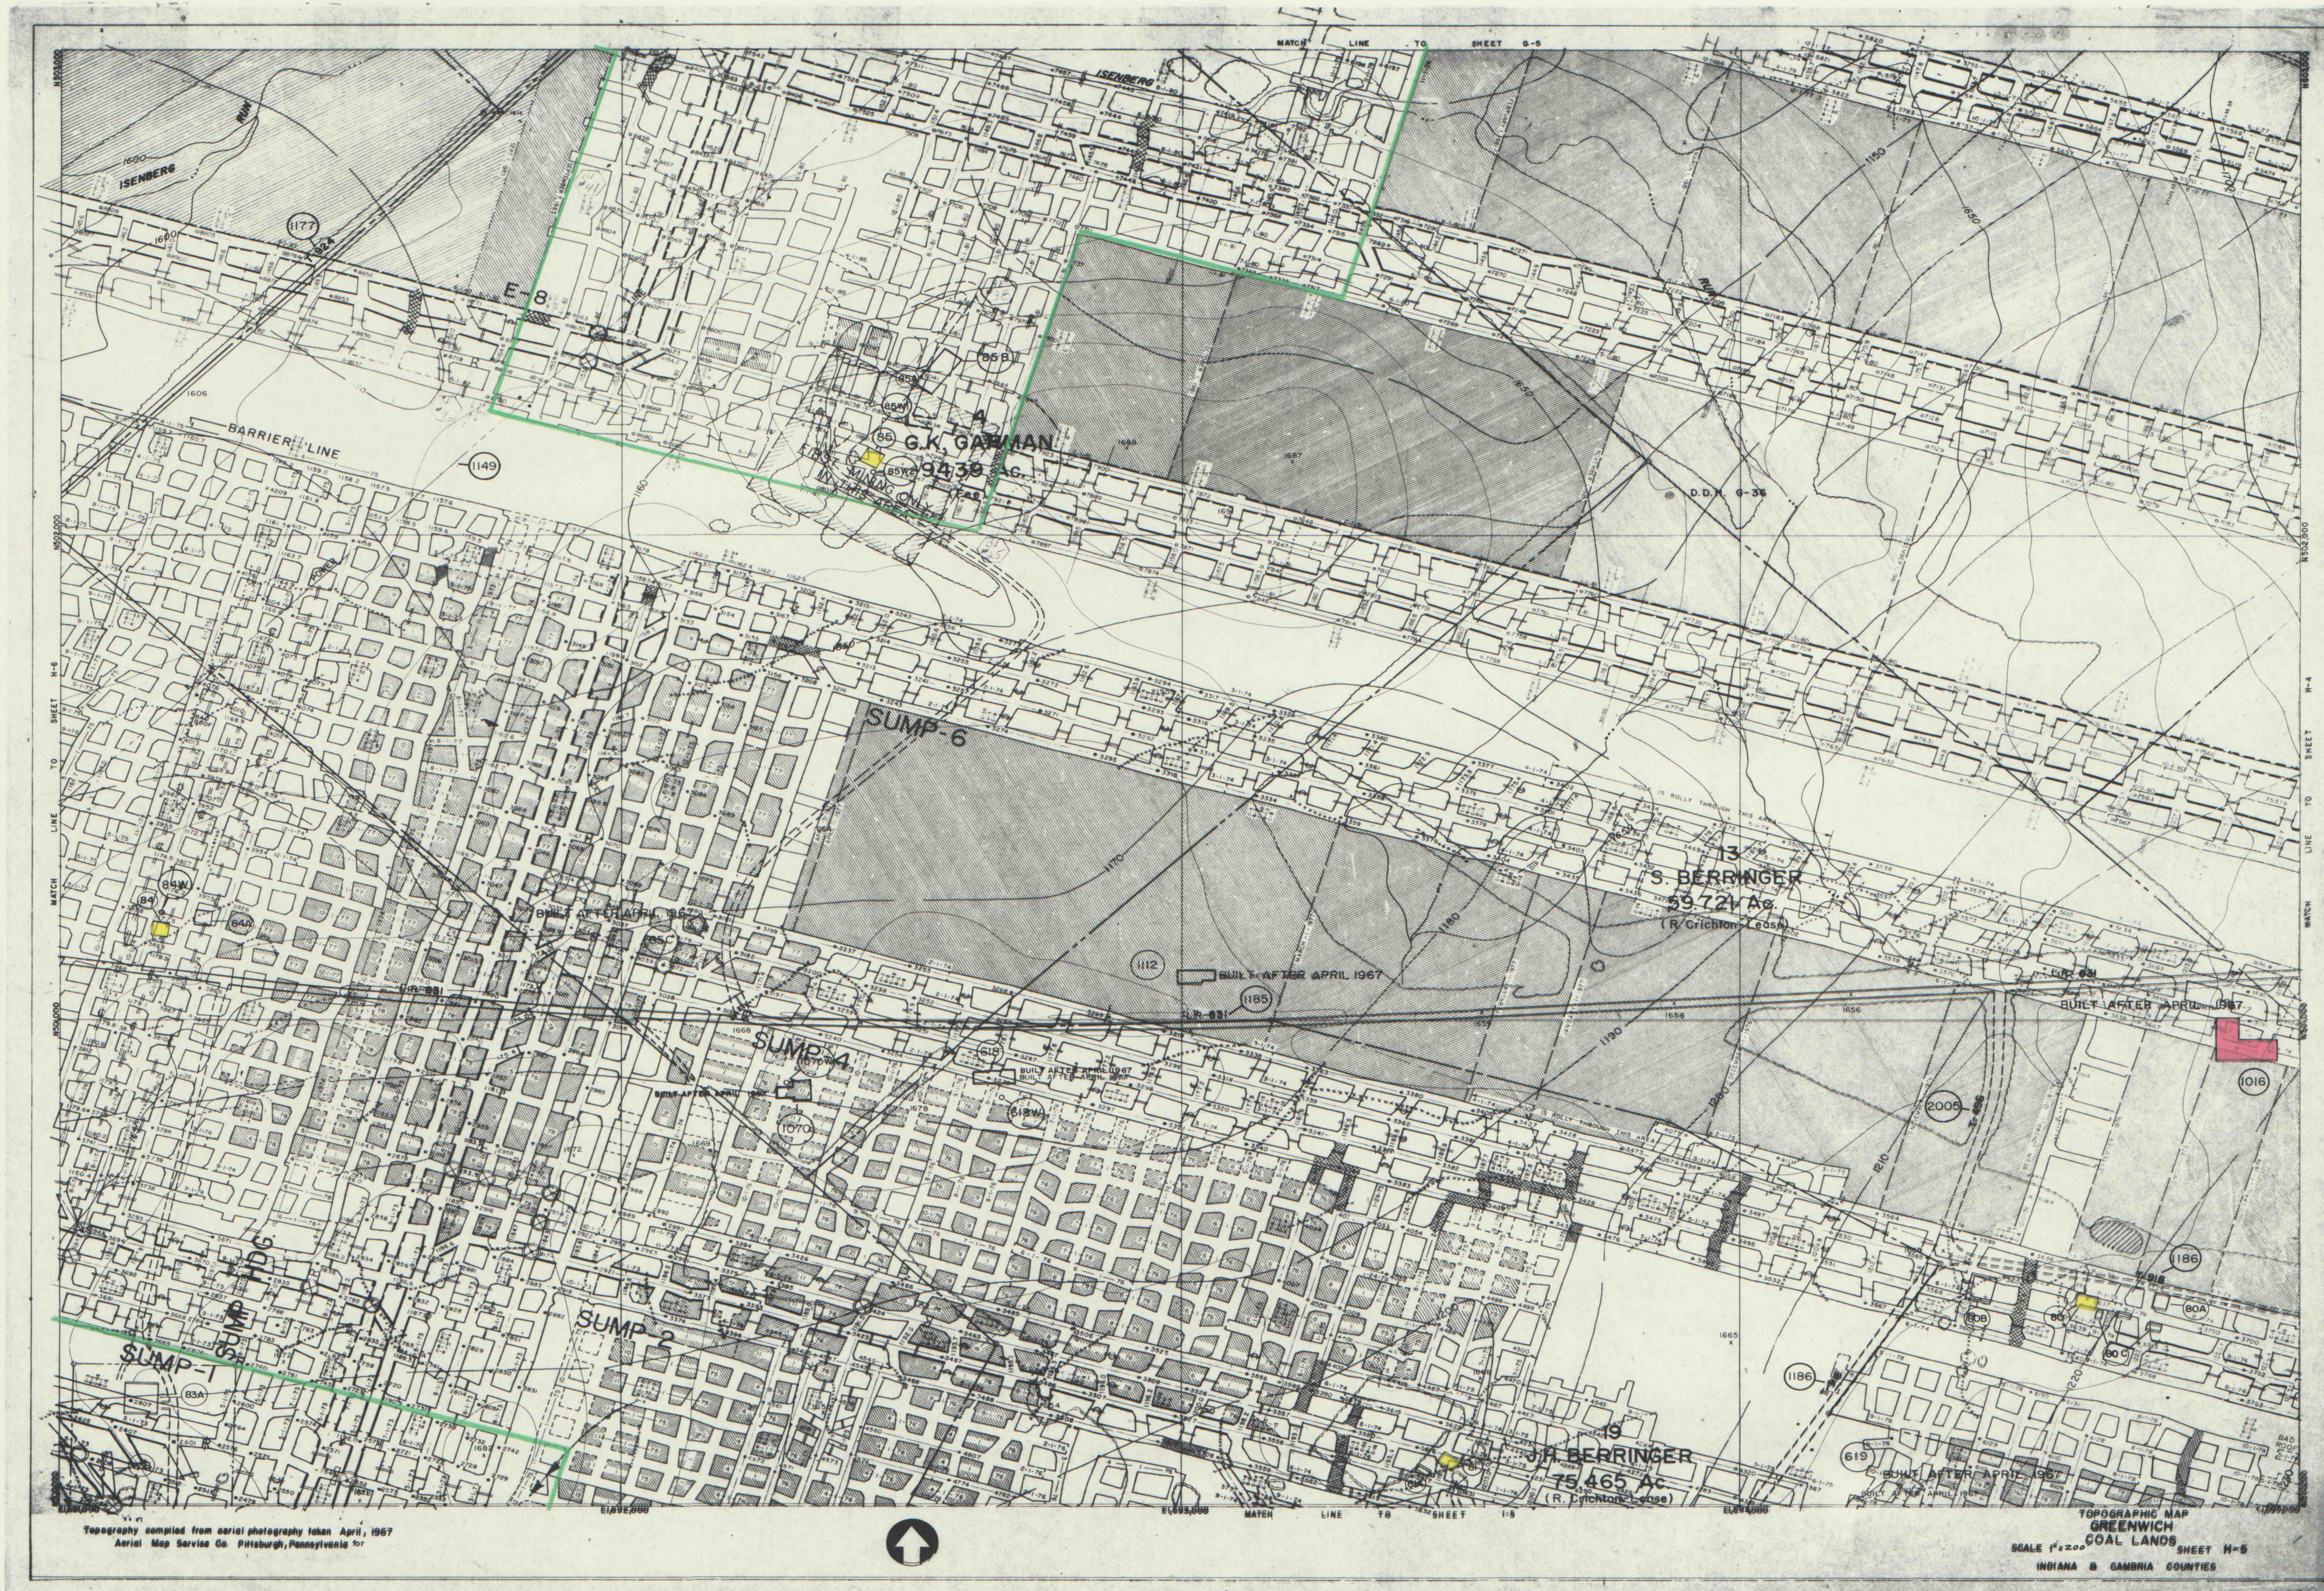


EXHIBIT "A"

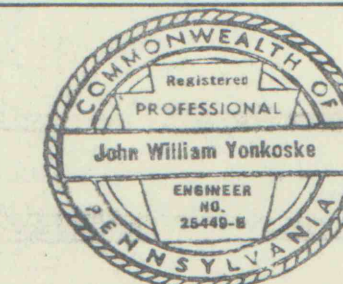

John W. Yonkoski

GREENWICH COLLIERIES NO'S 1 AND 2 MINES DIV. OF PENNSYLVANIA MINES CORP.

GREEN & MONTGOMERY TWPS. INDIANA COUNTY, PA.

SCALE 1"=200' SURVEY DATE 10-1-83 (REVISED JULY 1985)

PERIOD COVERED 10-1-83 THRU 1990

DWELLINGS & CEMETERIES (IN PLACE BEFORE 1966 ACT) ■

PUBLIC BUILDINGS; IMPOUNDMENTS (PLUS 20 AC. FEET) ■

BOUNDARY OF MINE ■

POLITICAL SUBDIVISION BOUNDARIES ■

SUBSIDENCE CONTROL PLAN BOUNDARY ■

PERMIT BOUNDARY ■

FEATURE IDENTIFICATION NO. 1