


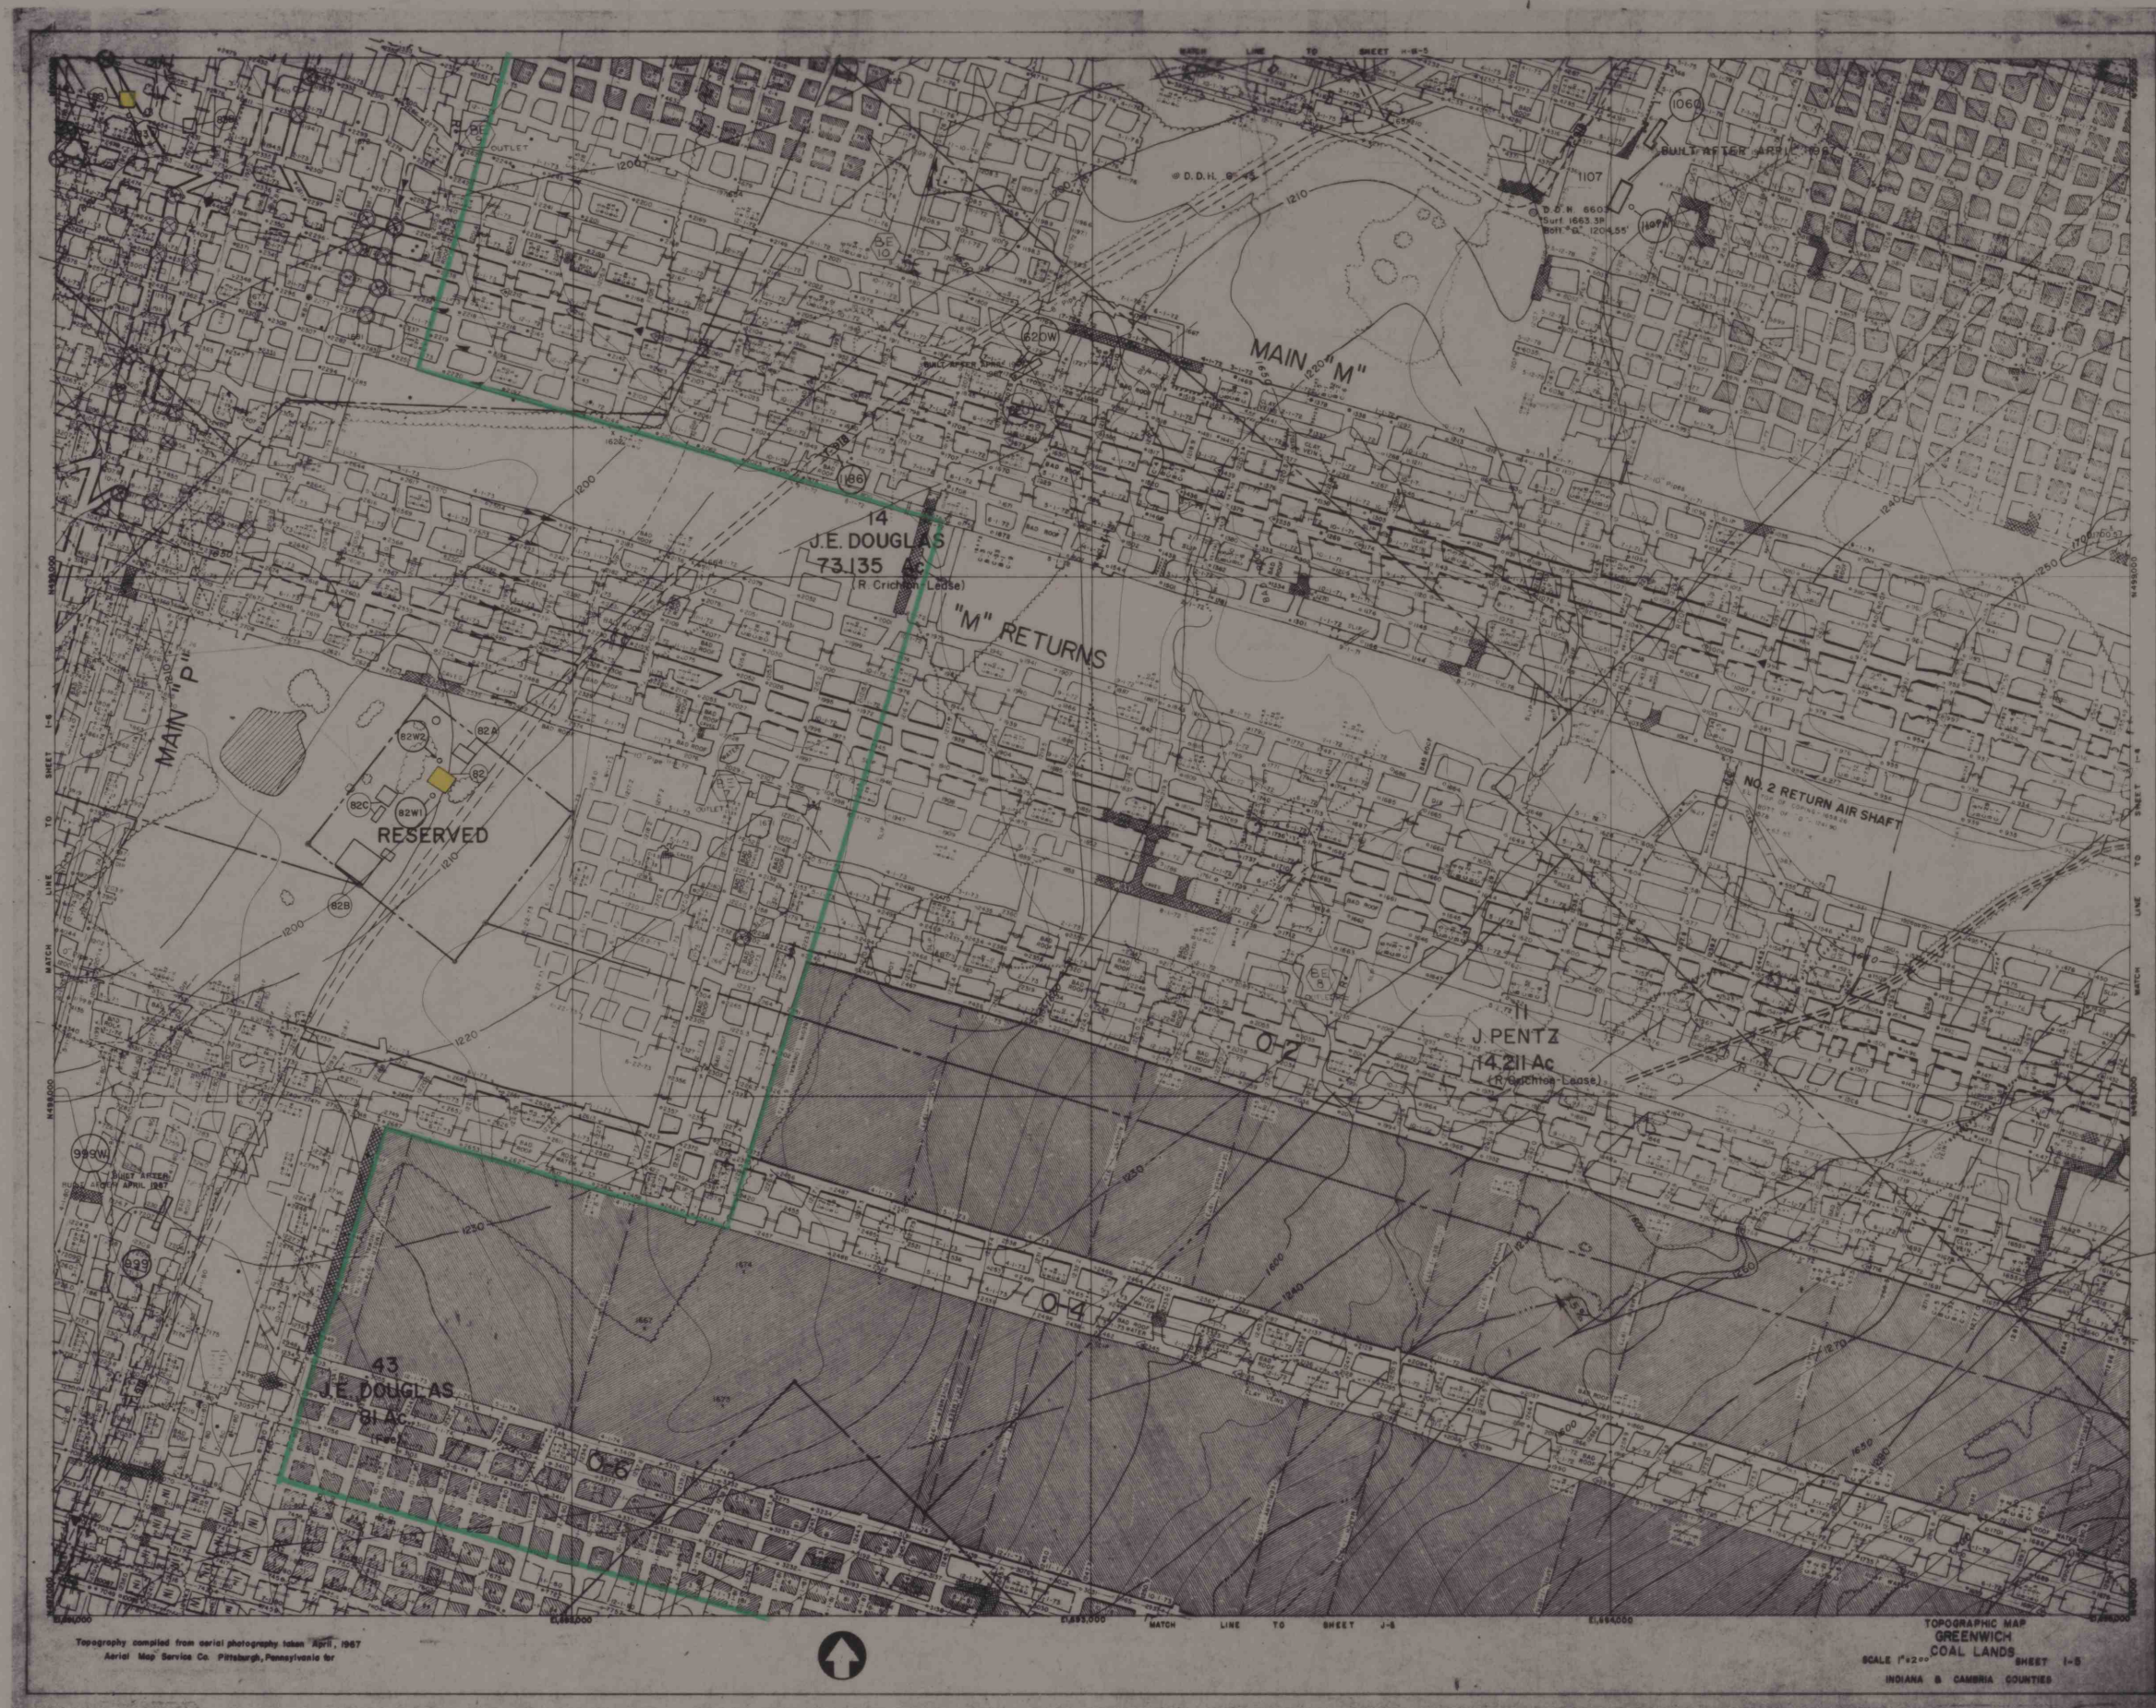


EXHIBIT "A"

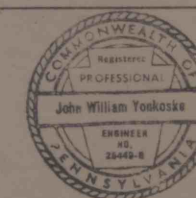

John W. Yankoske

GREENWICH COLLIERIES

NO'S 1 AND 2 MINES

DIV. OF PENNSYLVANIA MINES CORP.

GREEN & MONTGOMERY TWPS. INDIANA COUNTY, PA.

SCALE 1"=200' SURVEY DATE 10-1-83

PERIOD COVERED 10-1-83 THRU 1990 (REVISED JULY 1985)

- DWELLINGS & CEMETERIES (IN PLACE BEFORE 1966 ACT) ■
- PUBLIC BUILDINGS; IMPOUNDMENTS (PLUS 20 AC. FEET) ■
- BOUNDARY OF MINE ■
- POLITICAL SUBDIVISION BOUNDARIES ■
- SUBSIDENCE CONTROL PLAN BOUNDARY ■
- PERMIT BOUNDARY ■
- FEATURE IDENTIFICATION NO. 1