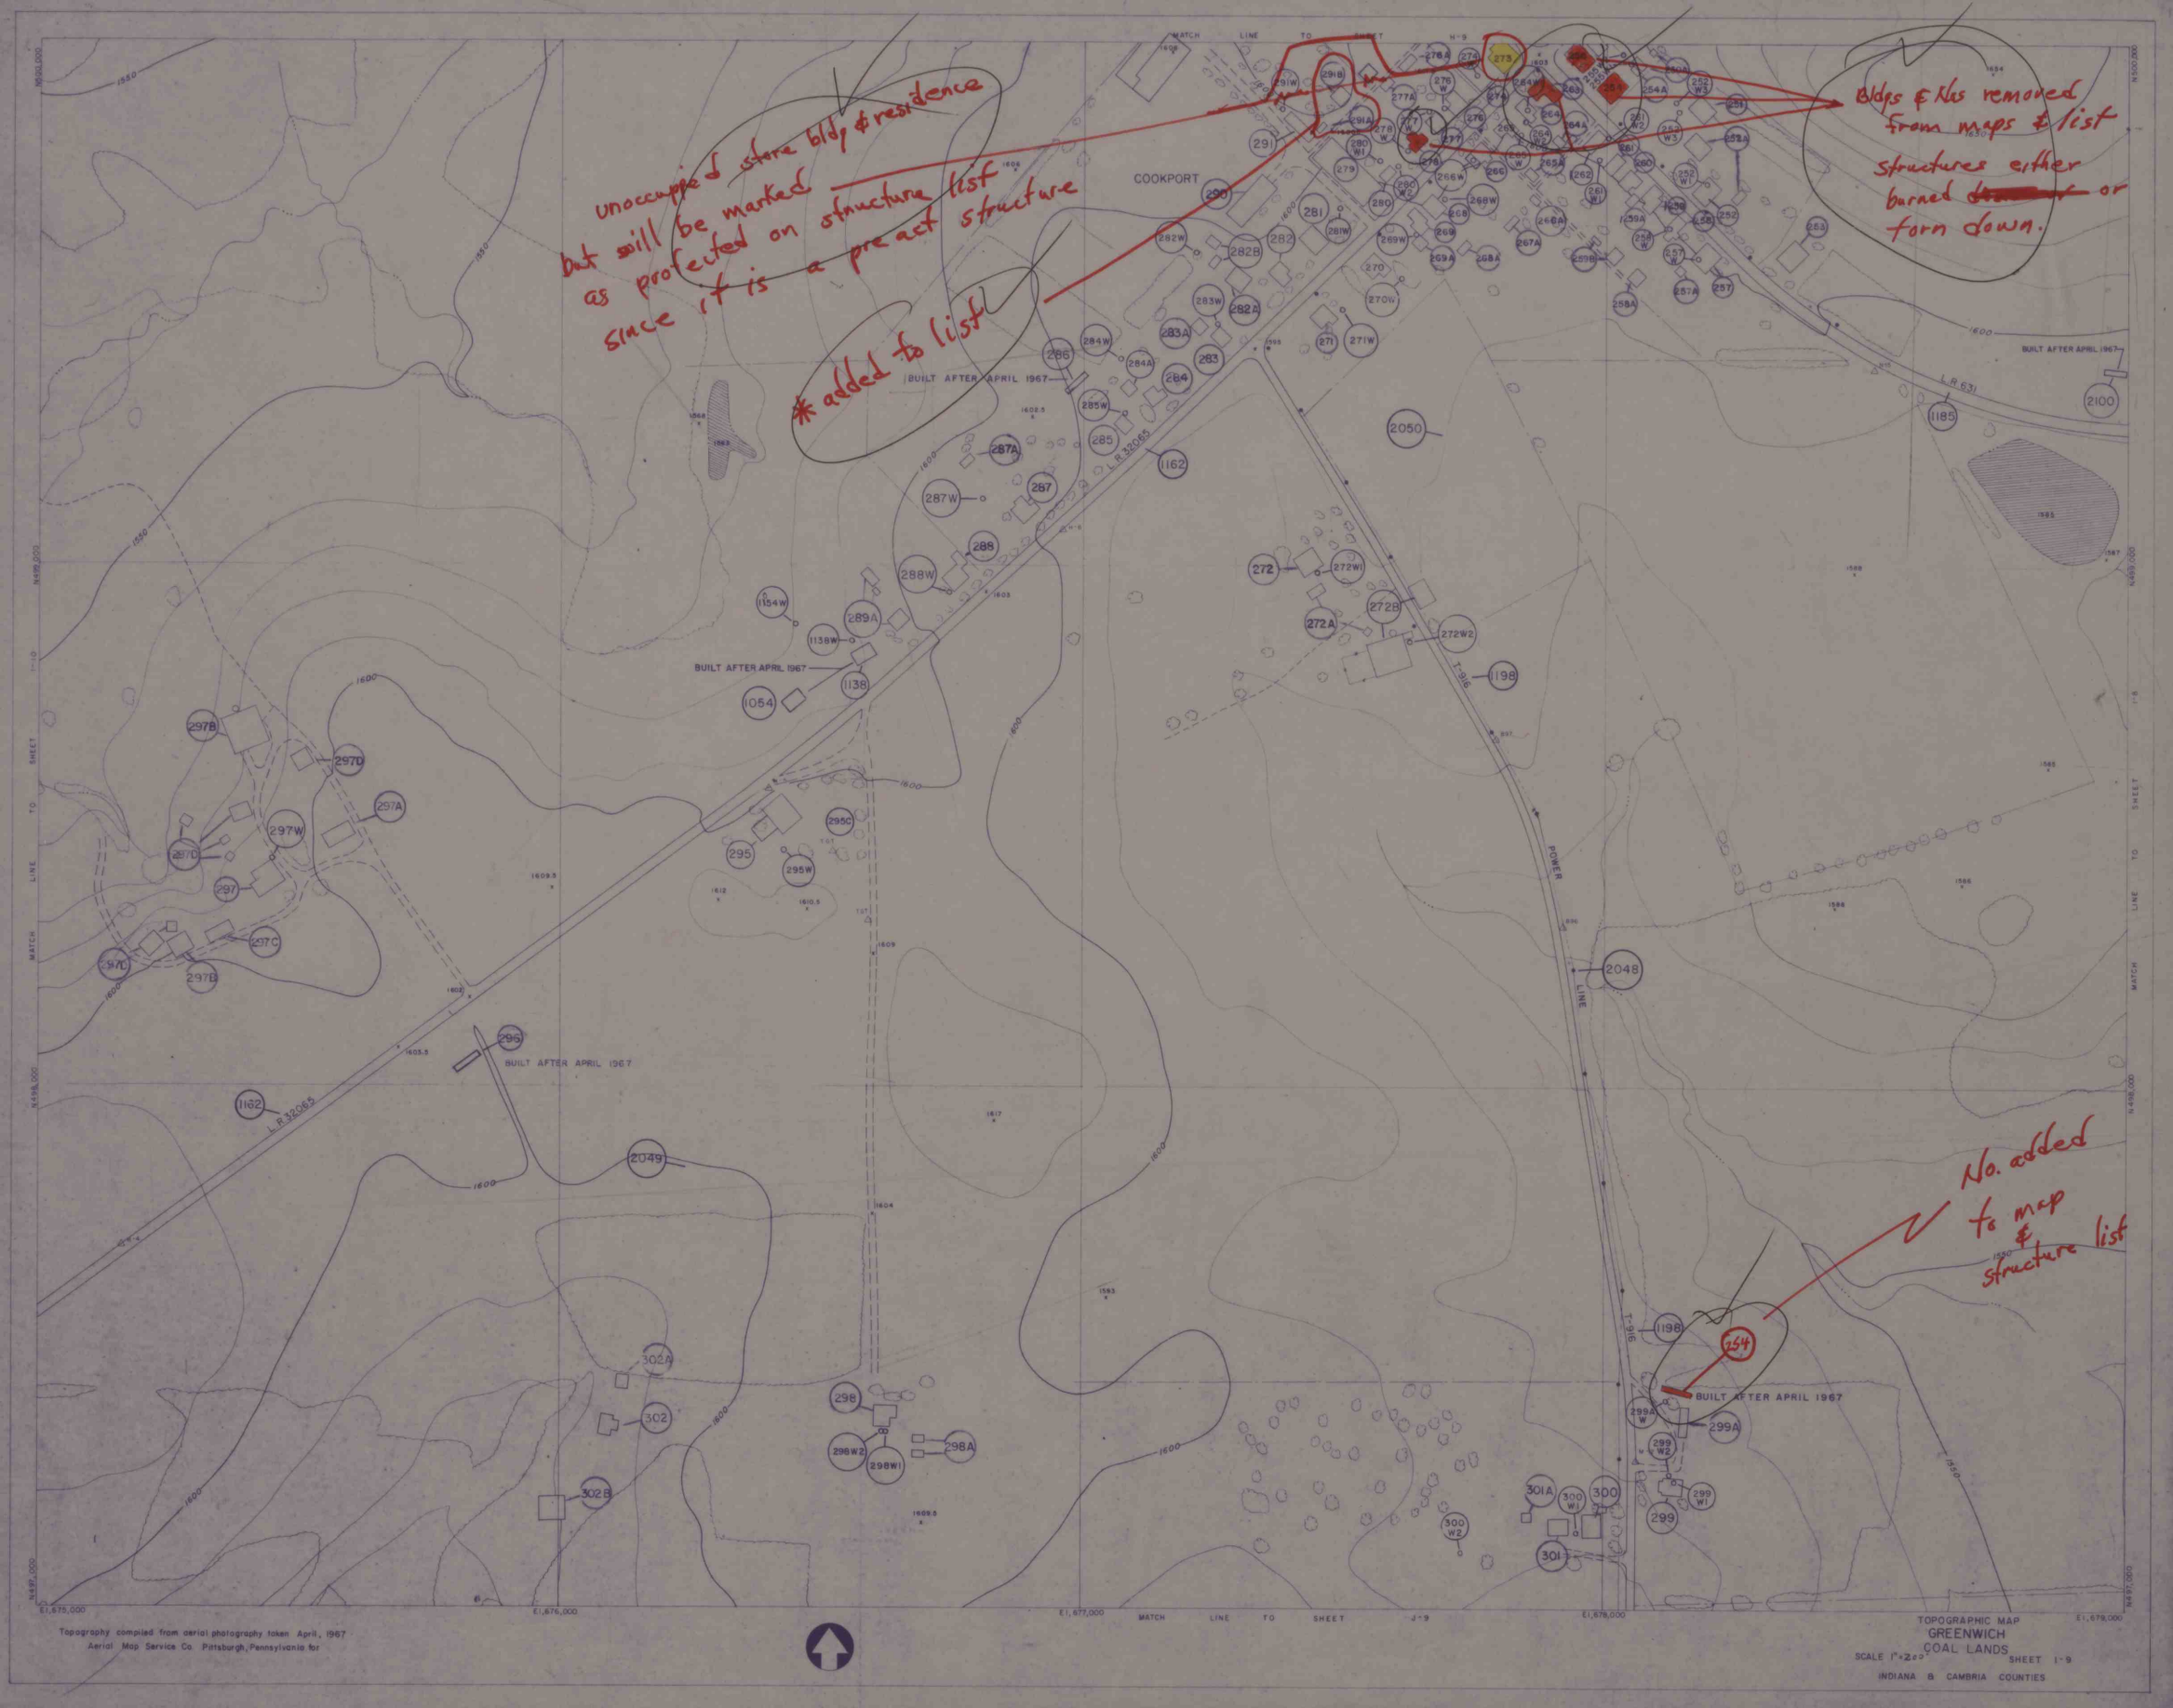
MATCH LINE TO SHEET H-9
COOKPORT
BUILT AFTER APRIL 1967
L.R. 32065
L.R. 631
T-916
POWER LINE
Unoccupied store bldg & residence but will be marked as protected on structure list since it is a pre act structure
* added to list
Bldgs & No's removed from maps & list structures either burned ~~down~~ or torn down.
No. added to map & structure list
Topography compiled from aerial photography taken April, 1967
Aerial Map Service Co. Pittsburgh, Pennsylvania for
TOPOGRAPHIC MAP
GREENWICH
COAL LANDS
SCALE 1"=200'
SHEET I-9
INDIANA & CAMBRIA COUNTIES