





Topography derived from aerial photography taken April, 1967
Aerial Map Service Co. Pittsburgh, Pennsylvania 152

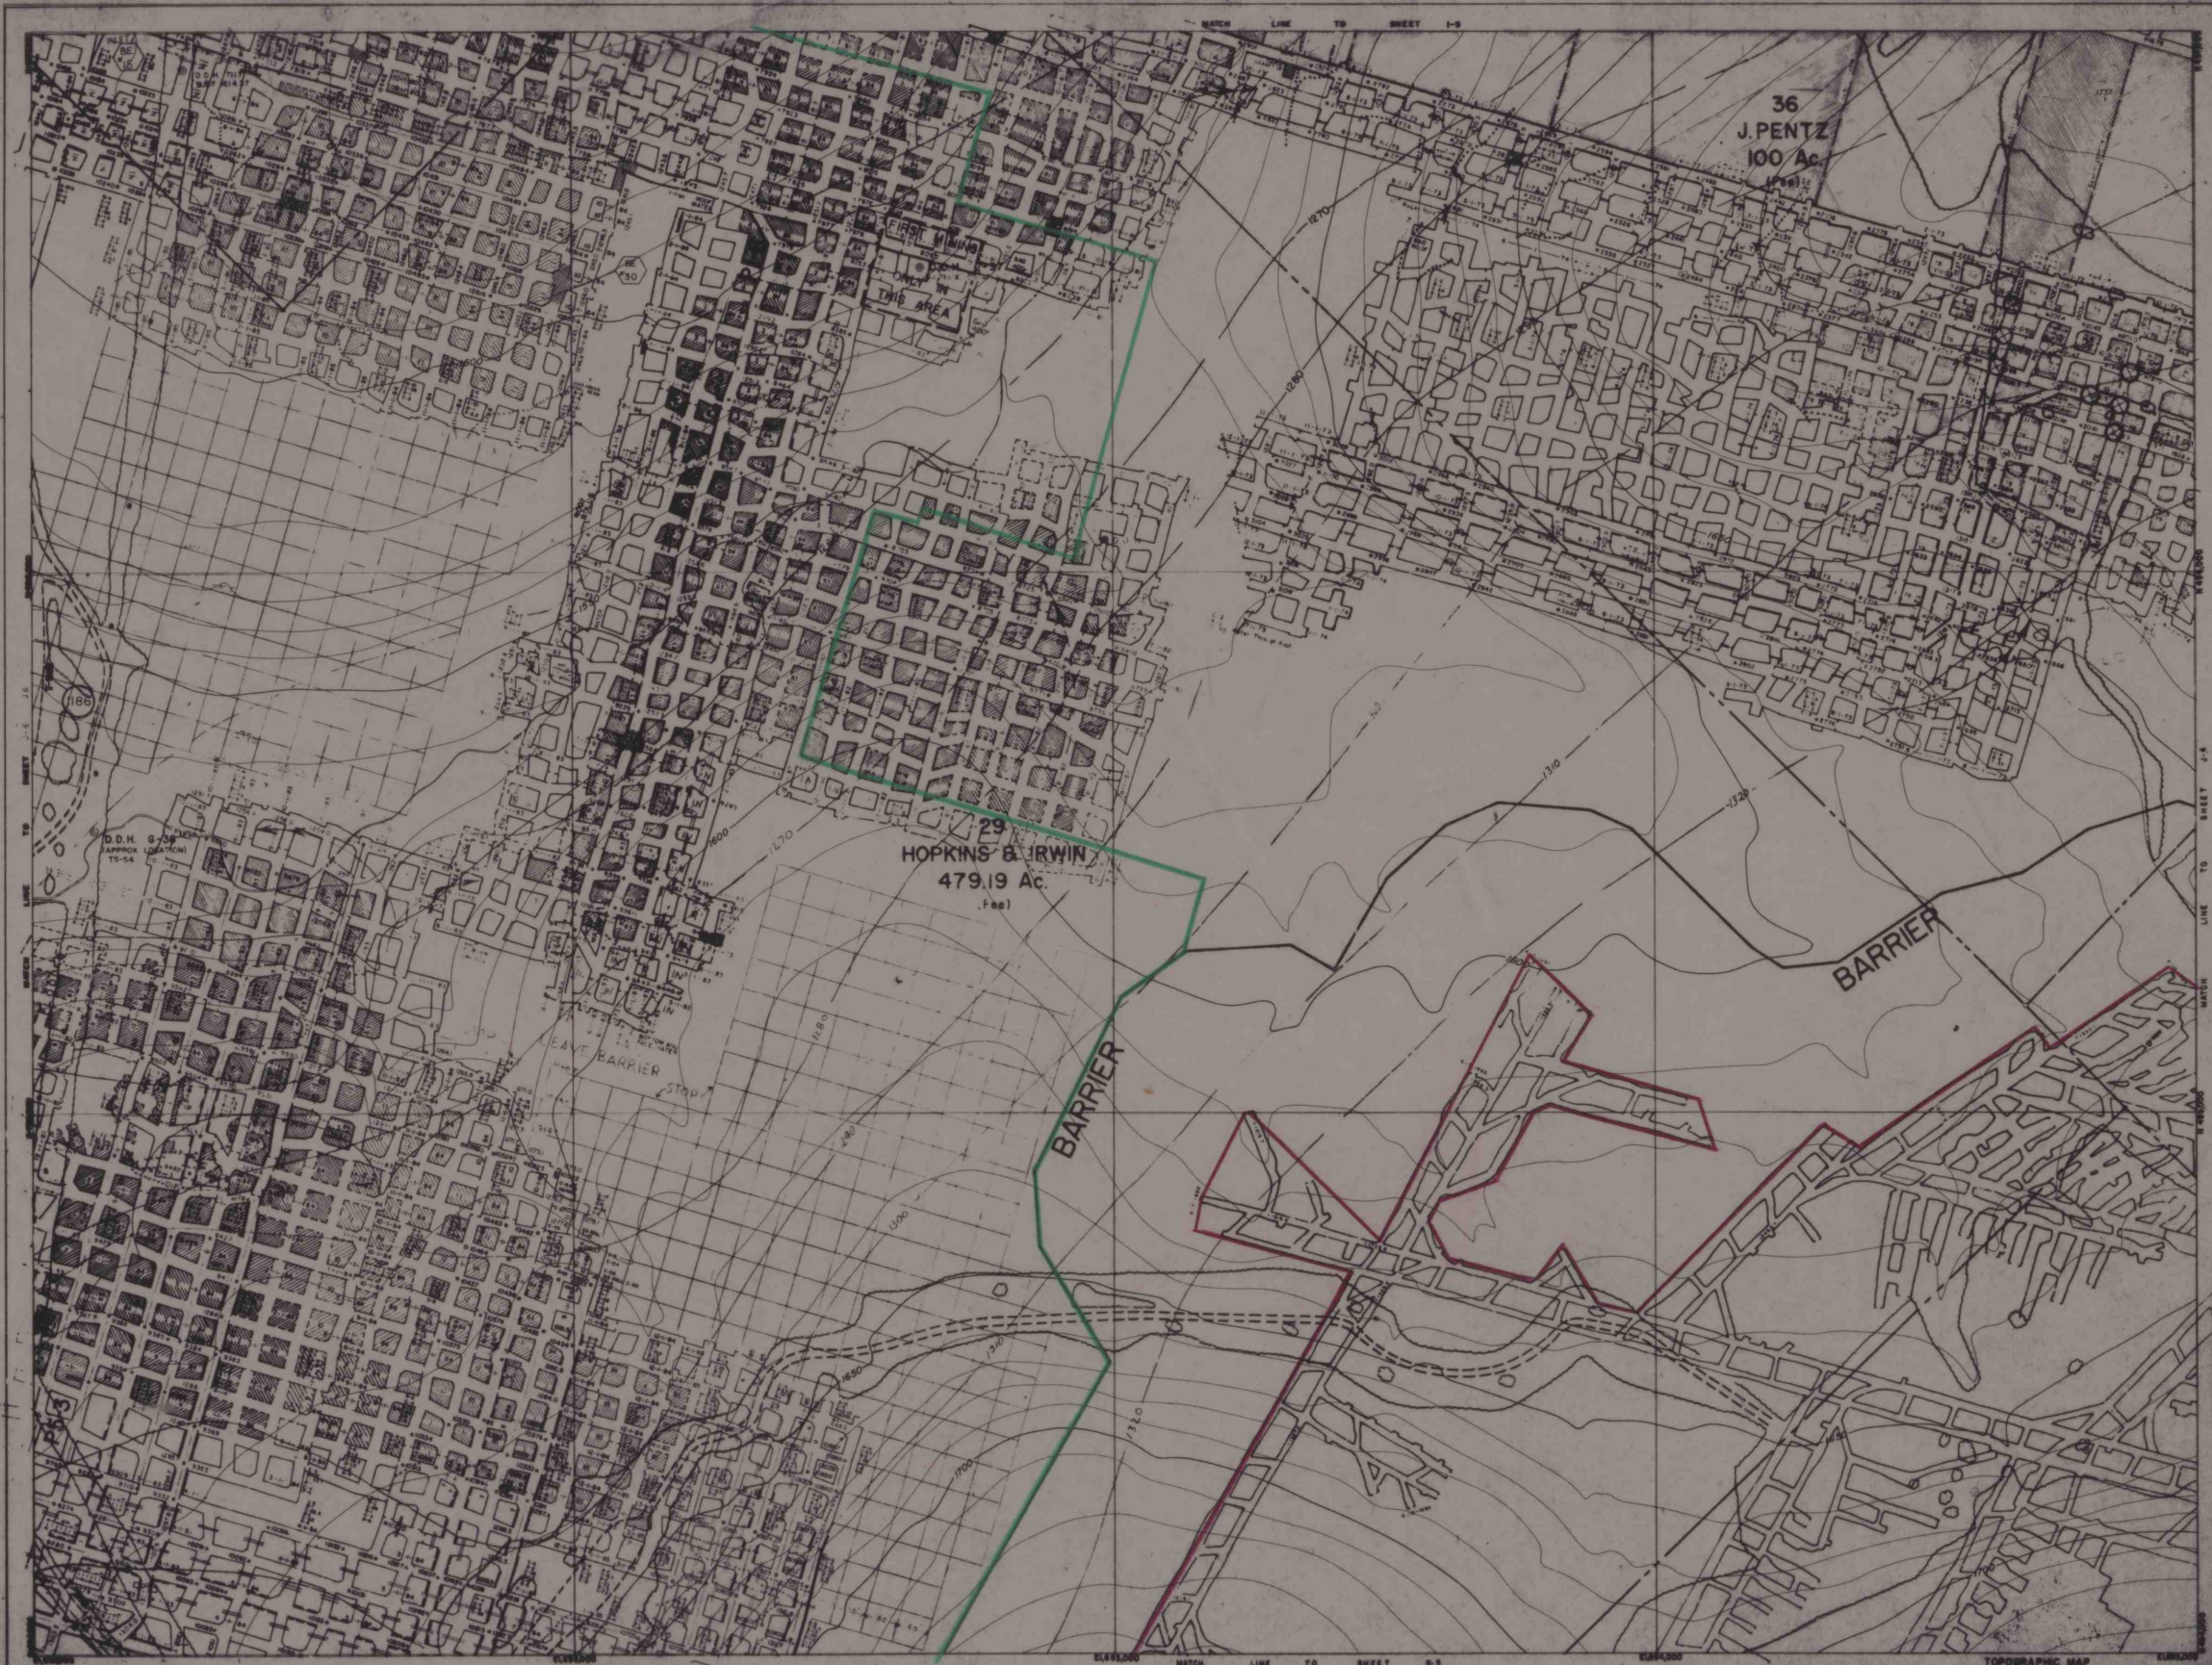

TOPOGRAPHIC MAP
GREENWICH COAL LANDS
SCALE 1"=200'
INDIANA & CAMBRIA COUNTIES
SHEET 4-B
DESIGNED 7-1-64

EXHIBIT "A"

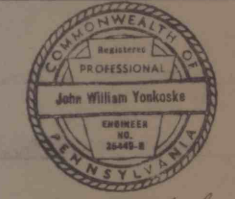

GREENWICH COLLIERIES NO'S 1 AND 2 MINES DIV. OF PENNSYLVANIA MINES CORP.

GREEN & MONTGOMERY TOWNSHIPS, INDIANA COUNTY, PA.
SCALE 1"=200' SURVEY DATE 10-1-83
PERIOD COVERED 10-1-83 THRU 1990
(REVISED JULY 1985)

- DWELLINGS & CEMETERIES (IN PLACE BEFORE 1966 ACT) ■
- PUBLIC BUILDINGS; IMPOUNDMENTS (PLUS 20 AC. FEET) ■
- BOUNDARY OF MINE ■
- POLITICAL SUBDIVISION BOUNDARIES ■
- SUBSIDENCE CONTROL PLAN BOUNDARY ■
- PERMIT BOUNDARY ■
- FEATURE IDENTIFICATION NO. 1