


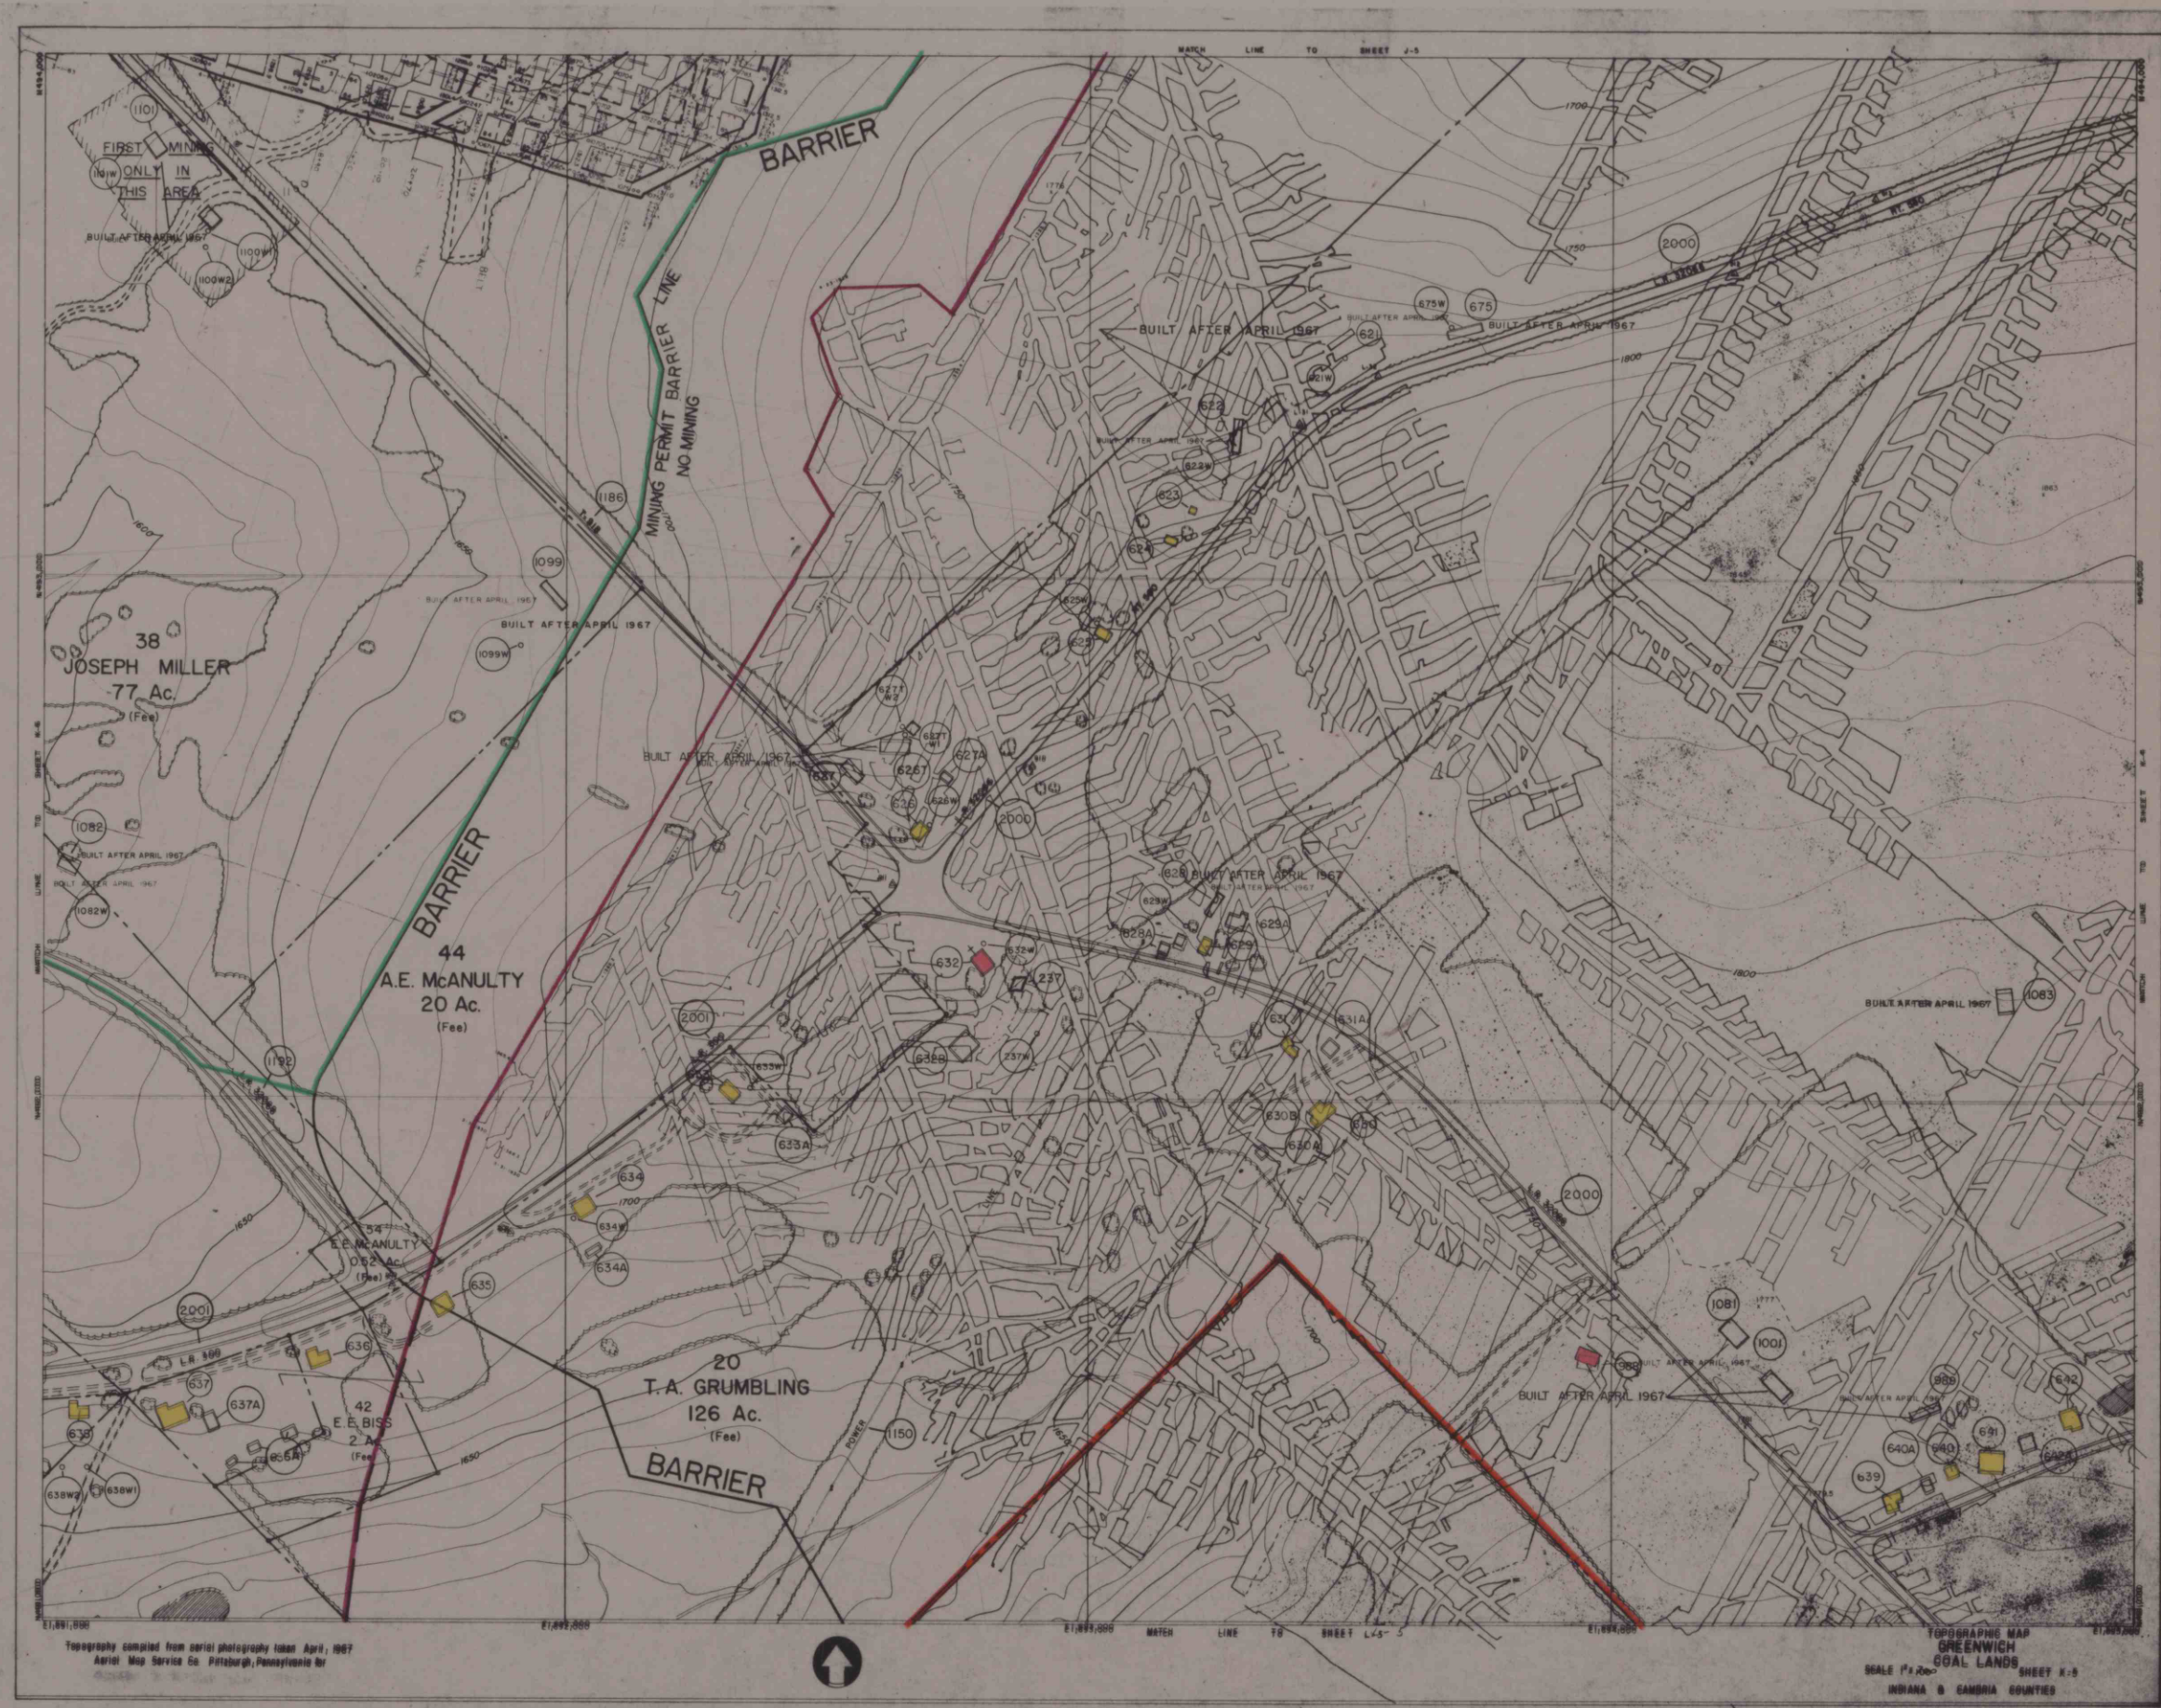


EXHIBIT "A"

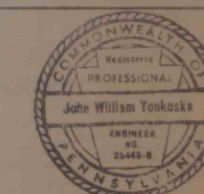

GREENWICH COLLIERIES NO'S 1 AND 2 MINES

DIV. OF PENNSYLVANIA MINES CORP.

GREEN & MONTGOMERY TOWNSHIPS, INDIANA COUNTY, PA.

SCALE 1"=200' SURVEY DATE 10-1-83

PERIOD COVERED 10-1-83 THRU 1990 (REVISED JULY 1985)

DWELLINGS & CEMETERIES (IN PLACE BEFORE 1966 ACT)

PUBLIC BUILDINGS; IMPOUNDMENTS (PLUS 20 AC. FEET)

BOUNDARY OF MINE

POLITICAL SUBDIVISION BOUNDARIES

SUBSIDENCE CONTROL PLAN BOUNDARY

PERMIT BOUNDARY

FEATURE IDENTIFICATION NO.

1