


10-85921

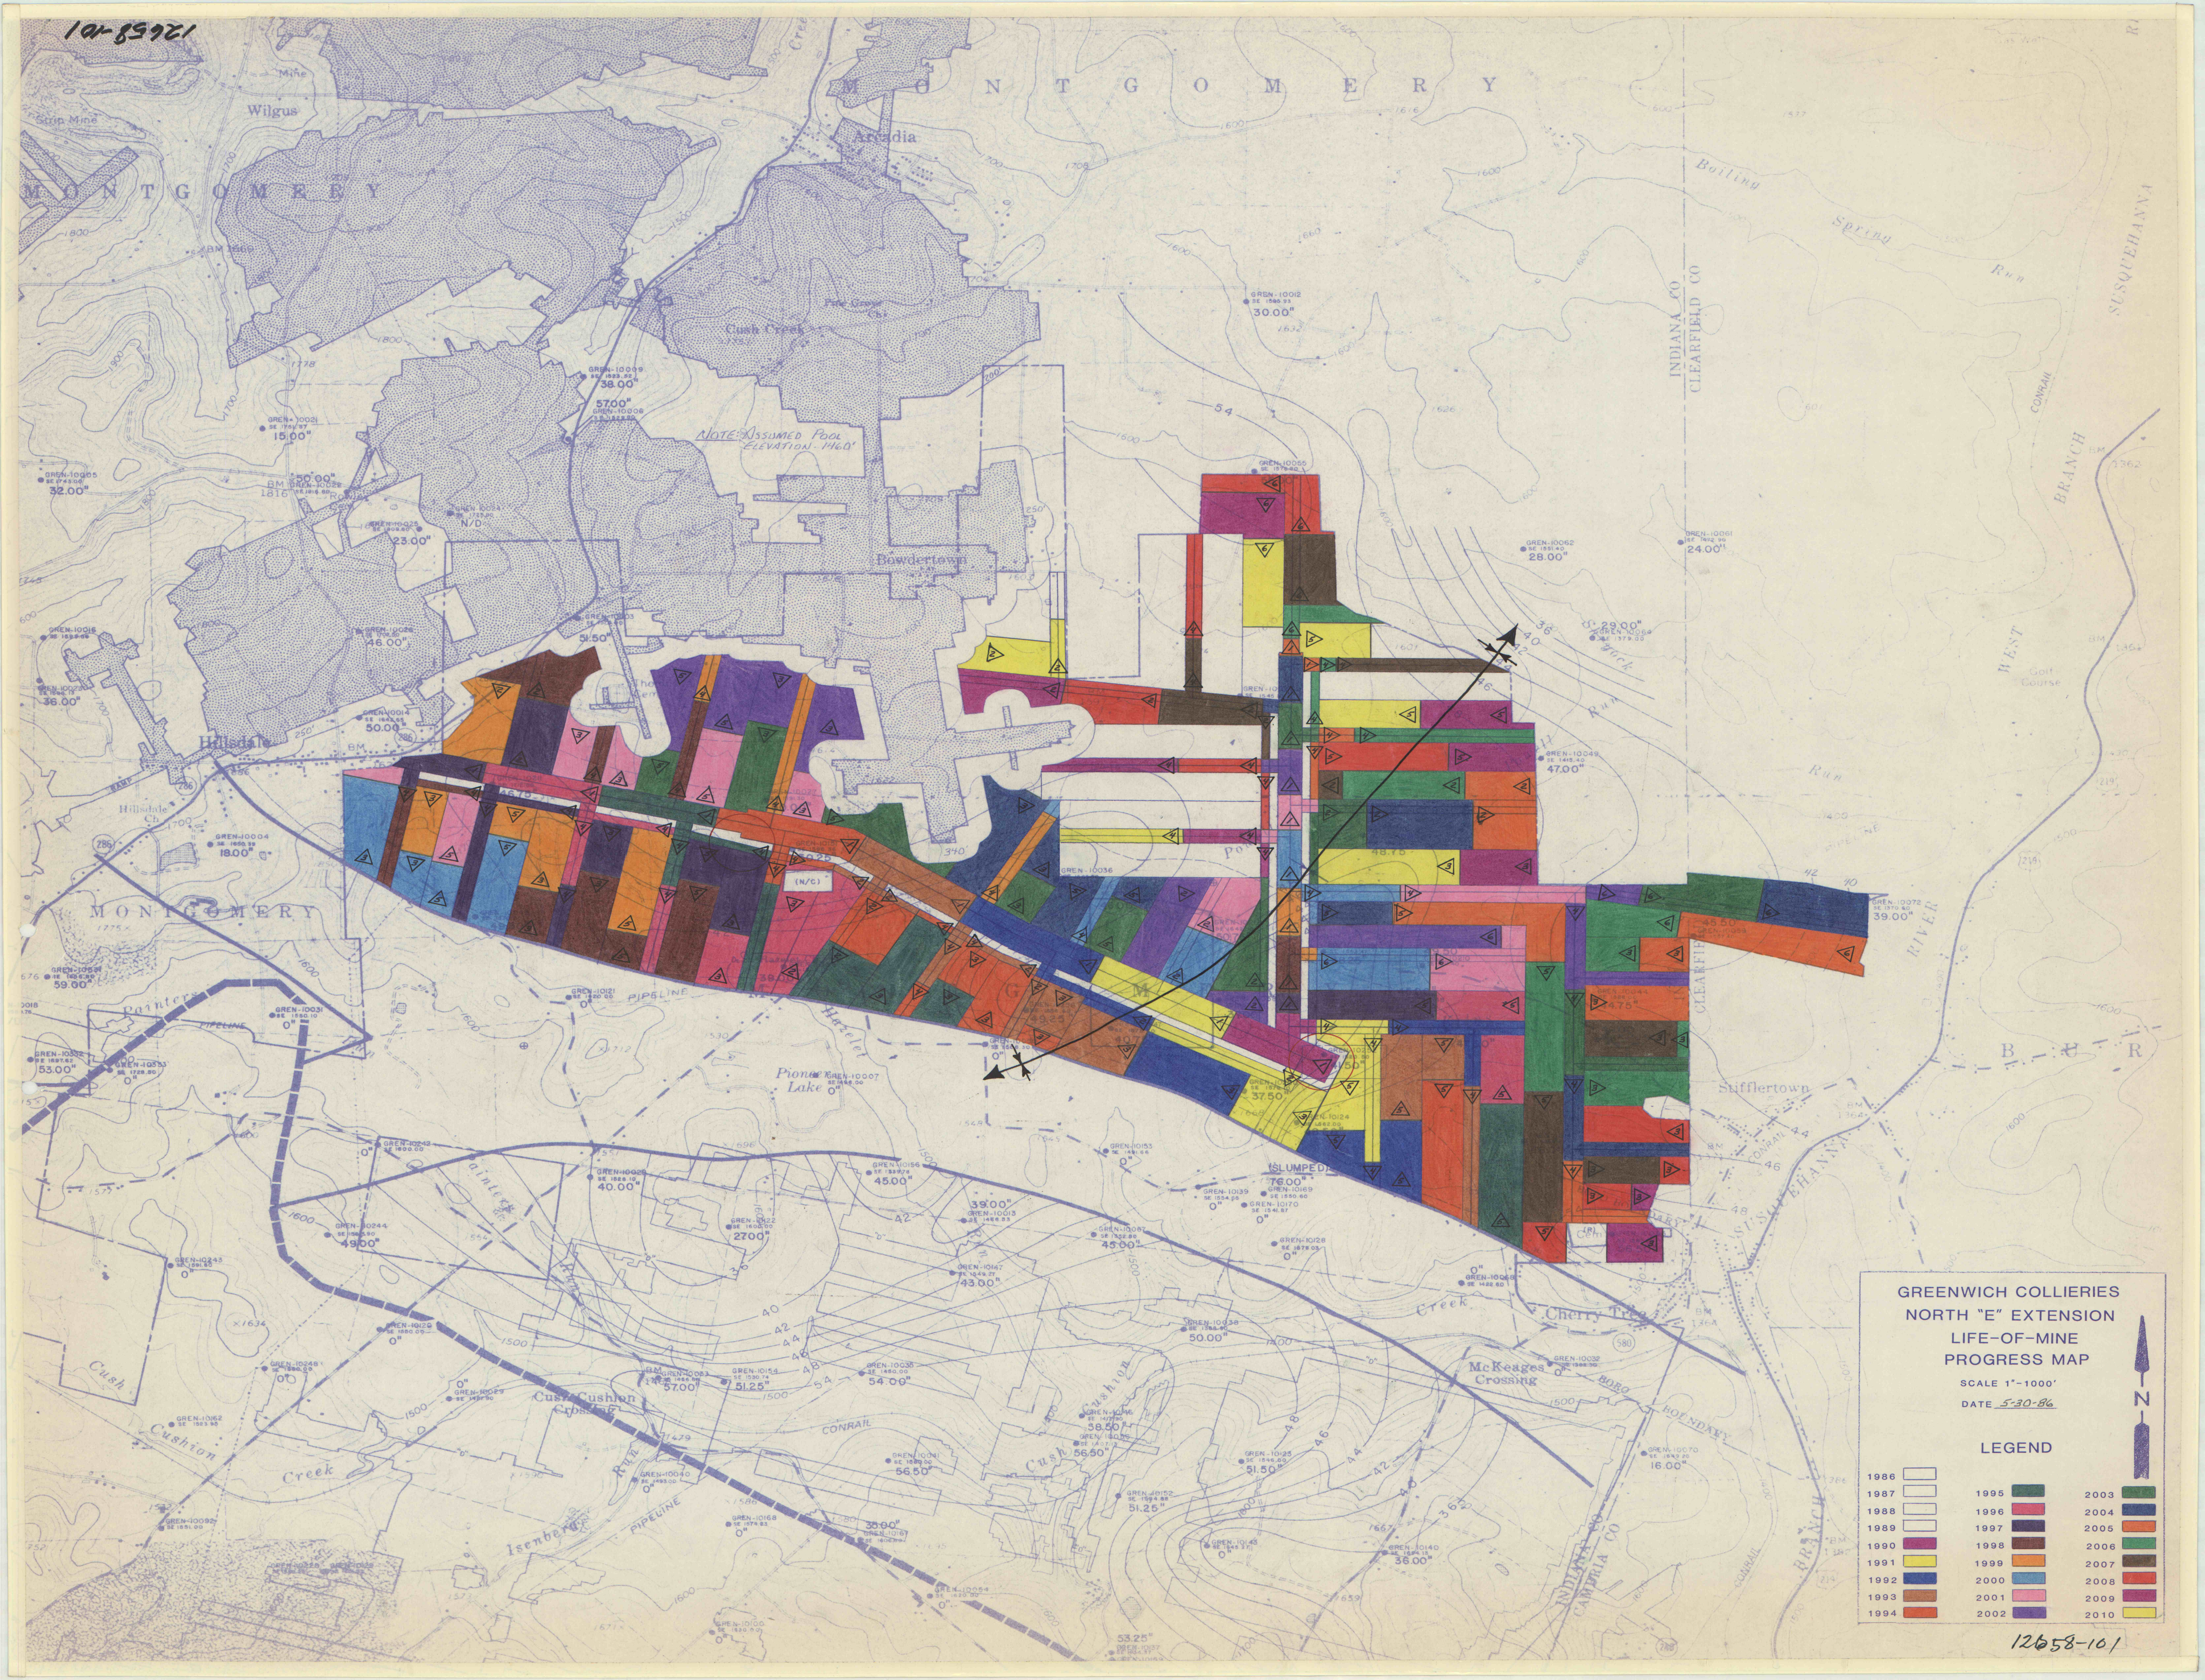

**GREENWICH COLLIERIES
NORTH "E" EXTENSION
LIFE-OF-MINE
PROGRESS MAP**

SCALE 1"=1000'
DATE 5-30-86

LEGEND

1986	1995	2003
1987	1996	2004
1988	1997	2005
1989	1998	2006
1990	1999	2007
1991	2000	2008
1992	2001	2009
1993	2002	2010

12658-101