


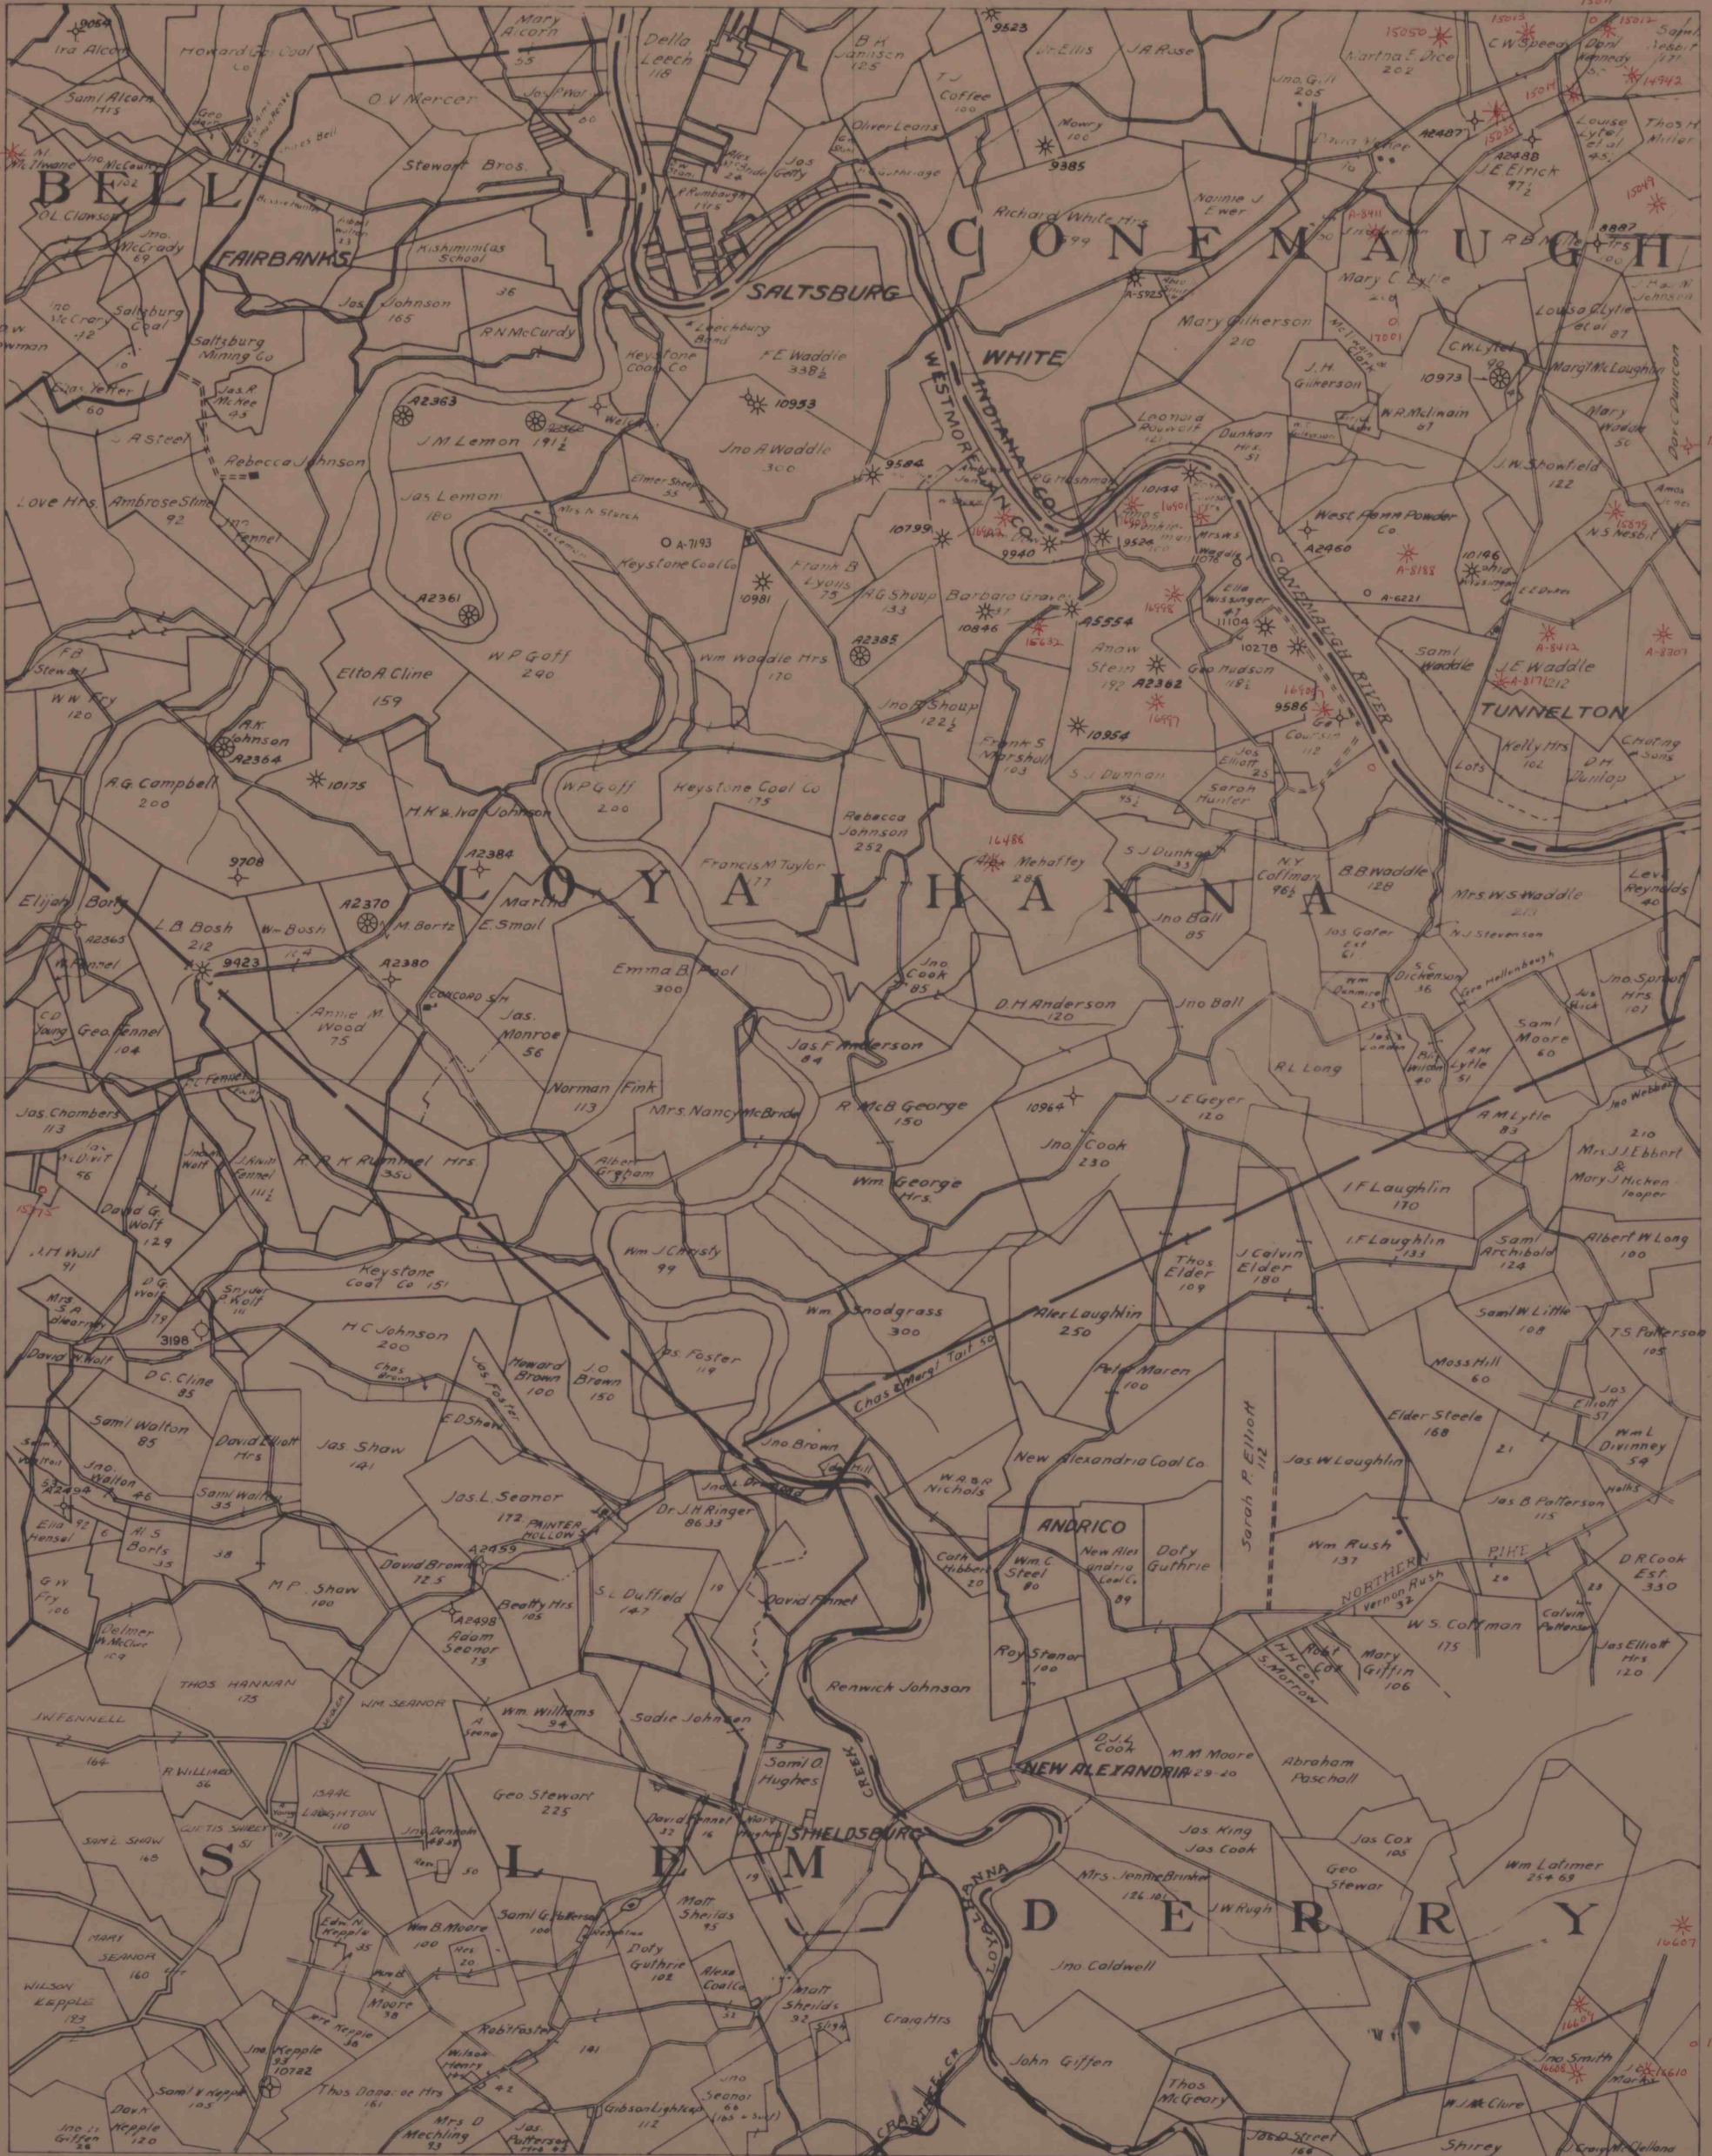

SCALE 1"=2000'