


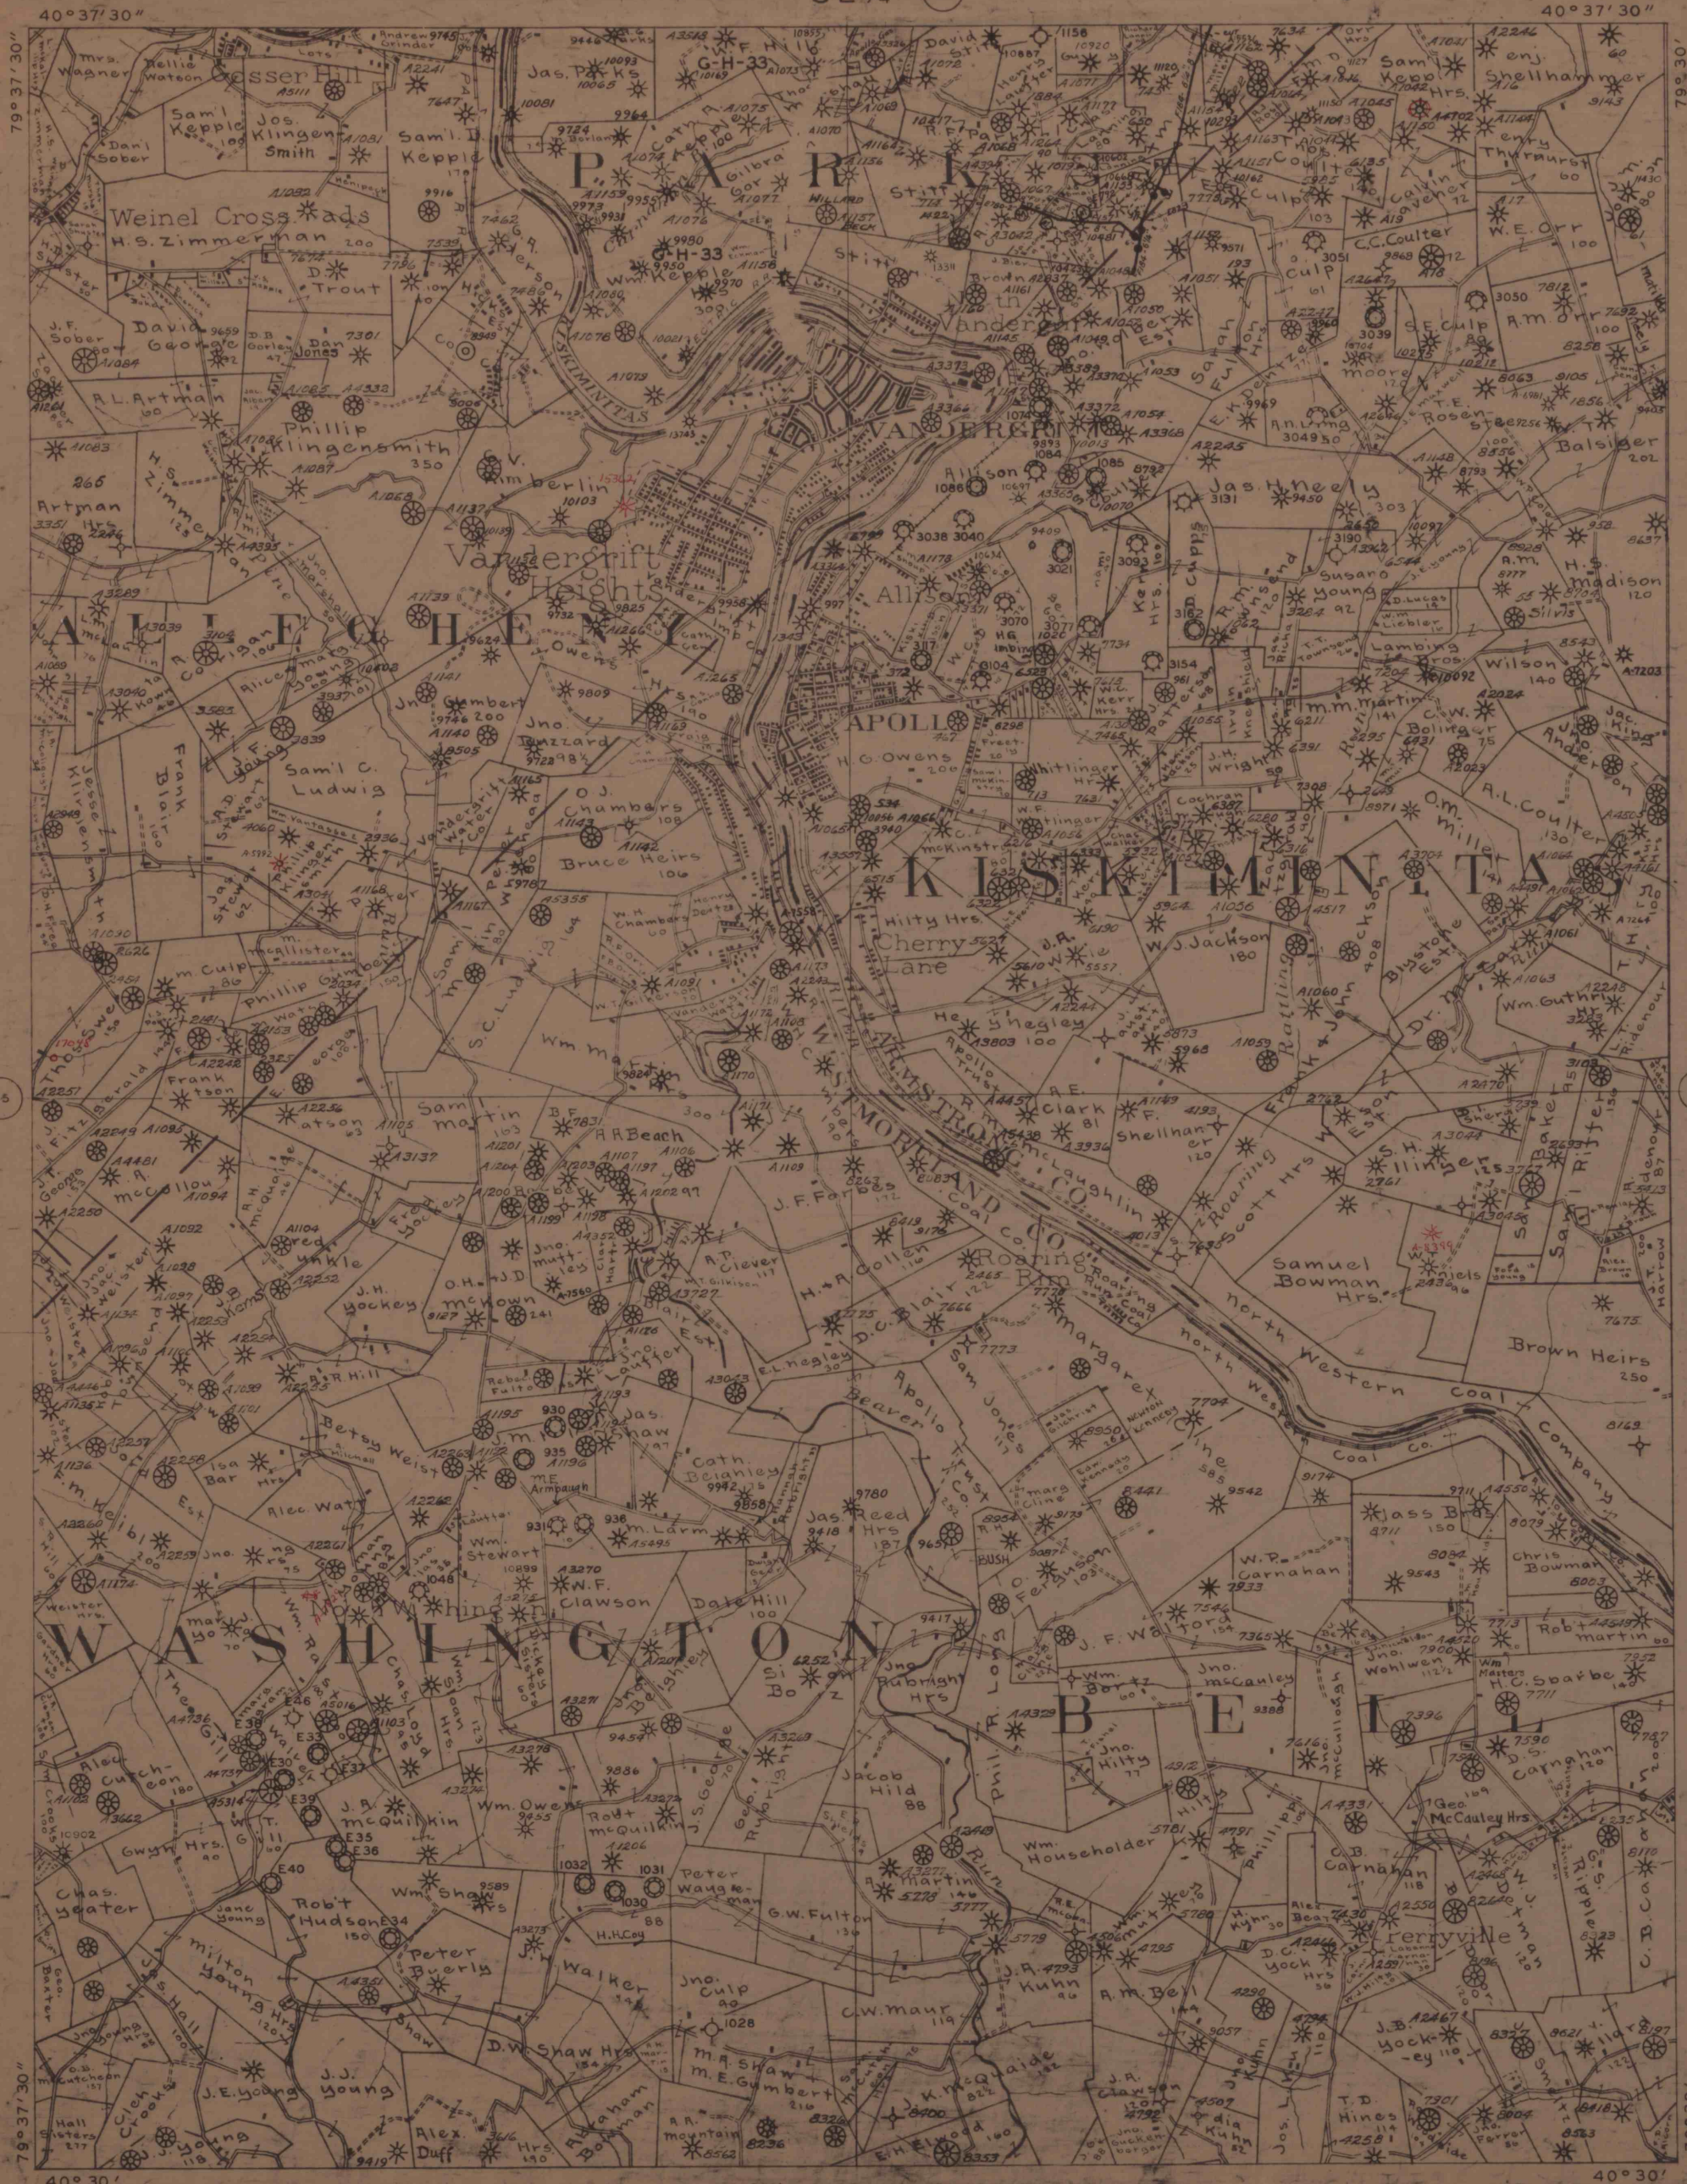

SCALE 1" = 2000'