


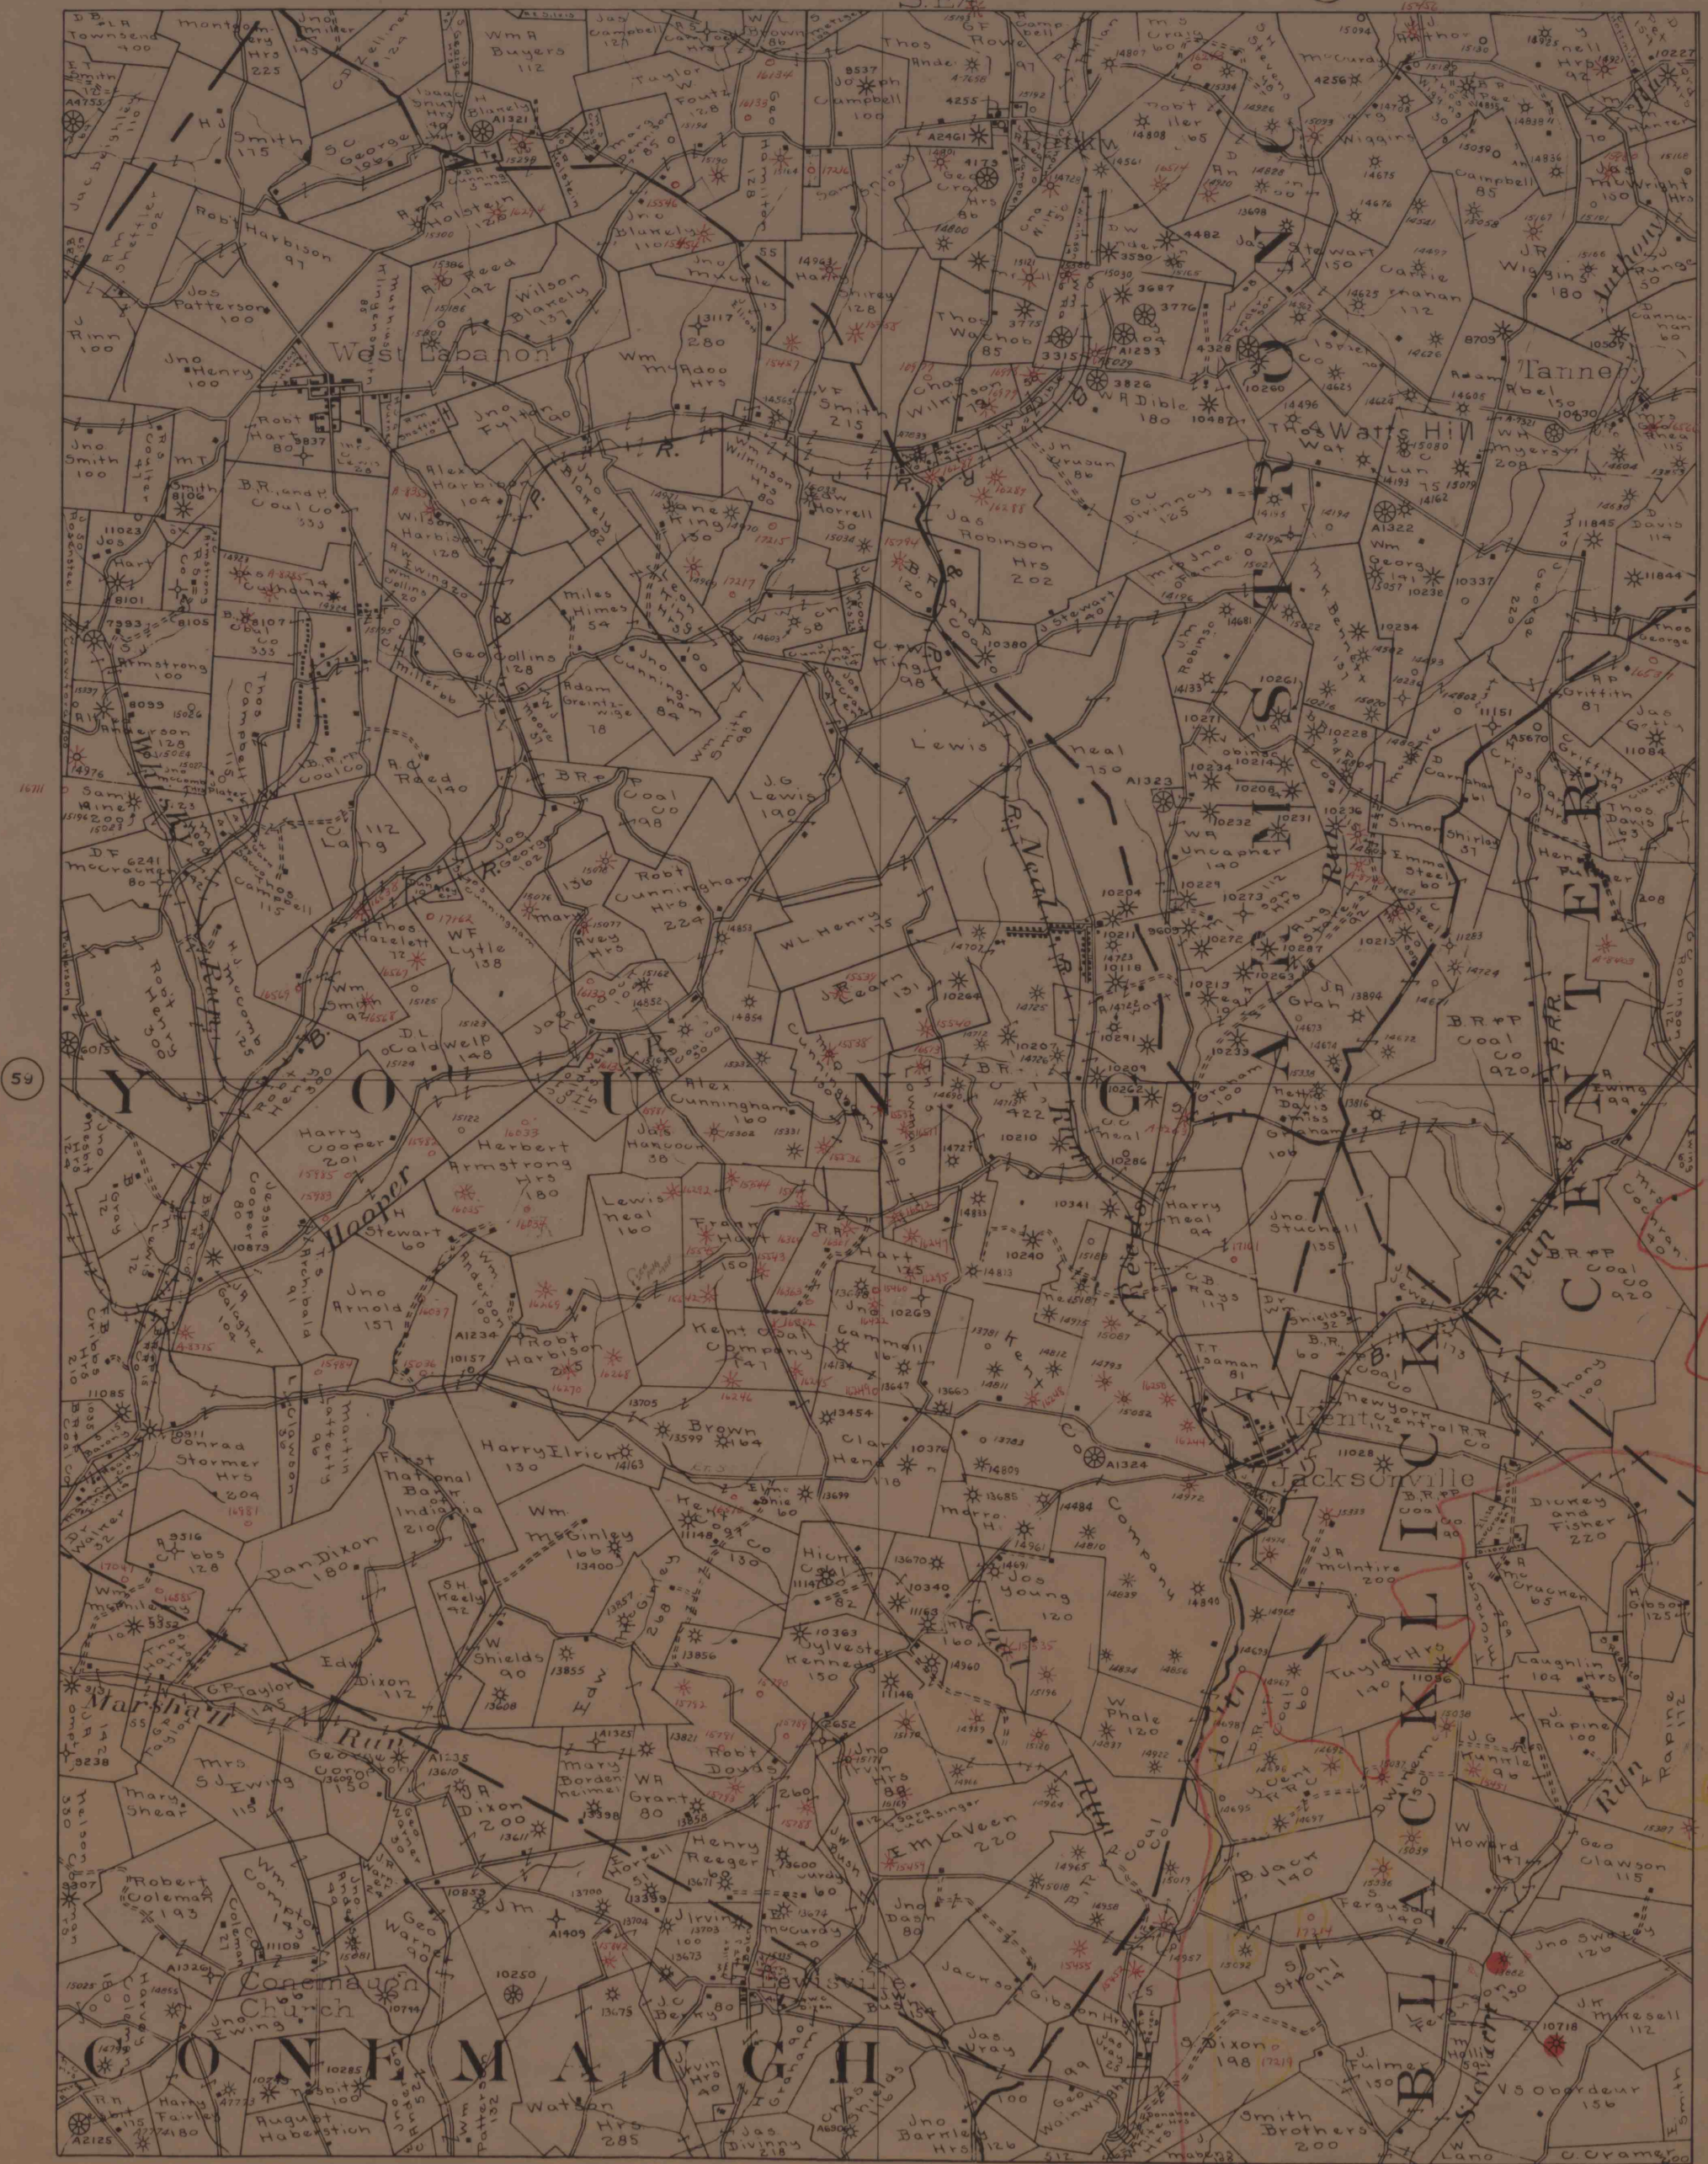

E.W. McCrary
MARIETTA, OHIO.

Scale 1 in = 2000 ft.

DEC. 1912

ELDERS RIDGE S.E. 60