

PENNSYLVANIA
RURAL VALLEY QUADRANGLE


79

79

SW 1/4

40°52'30"

40°52'30"

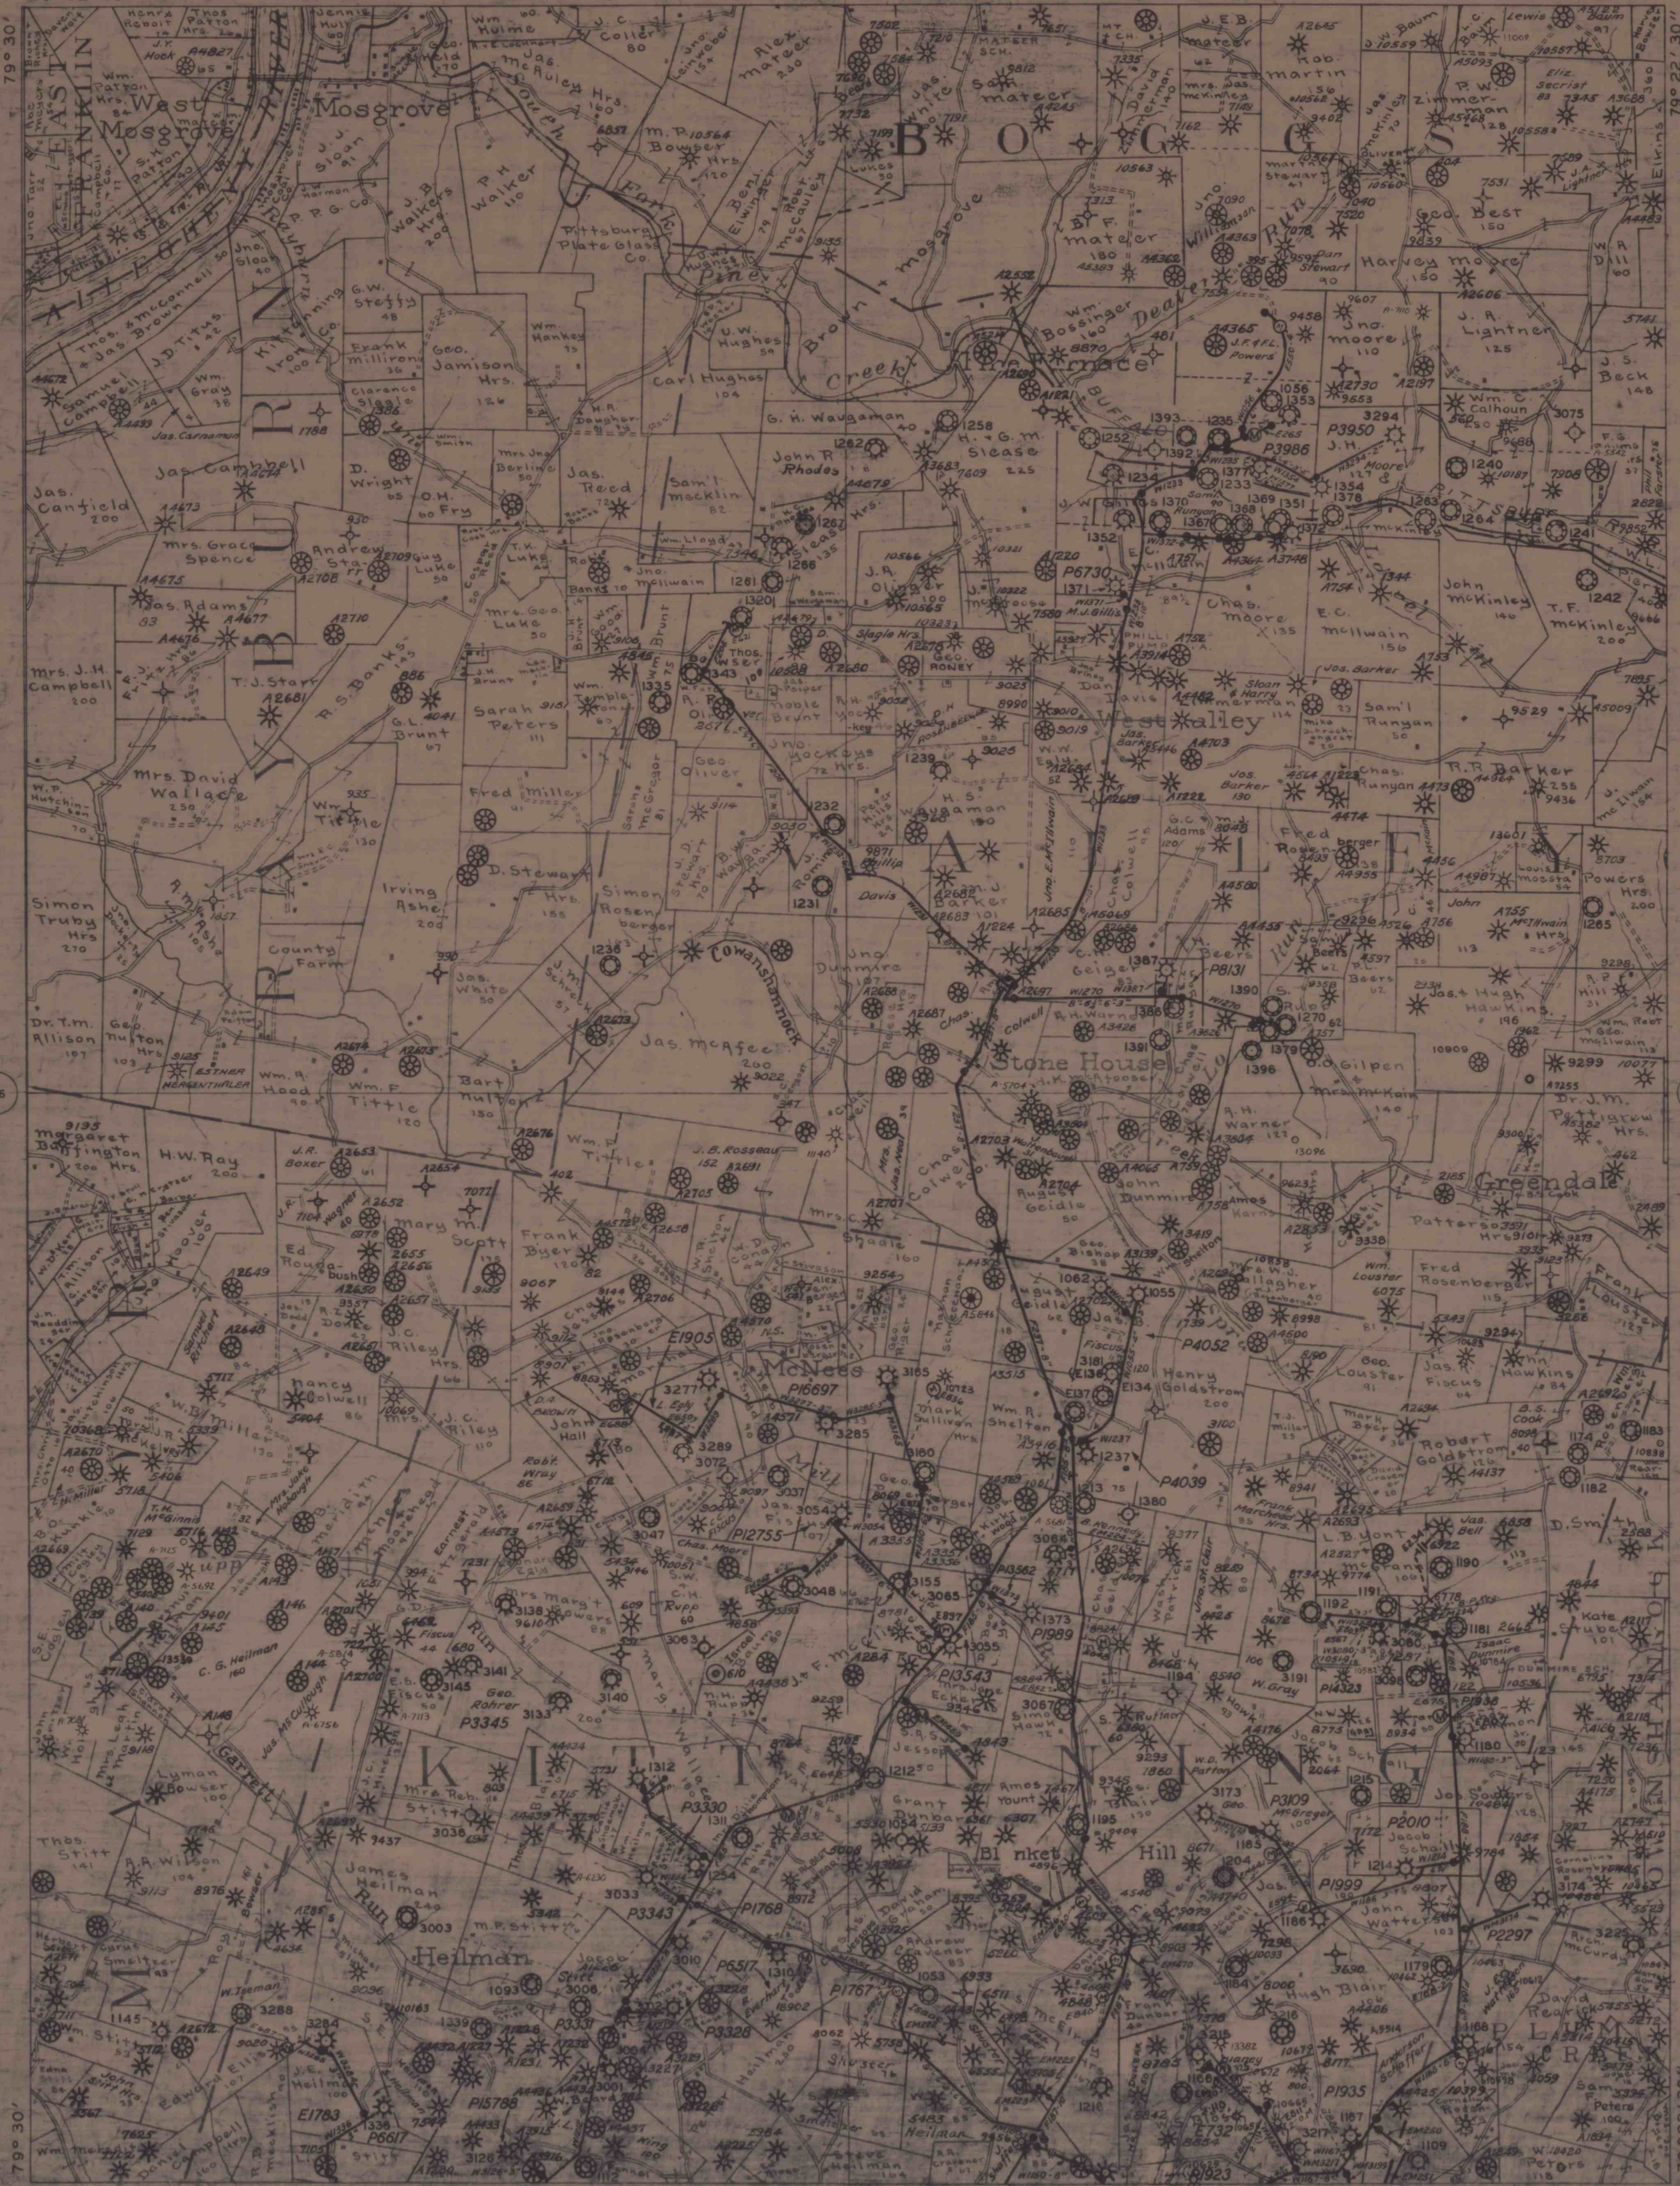

SCALE 1" = 2000'

RURAL VALLEY SW 79