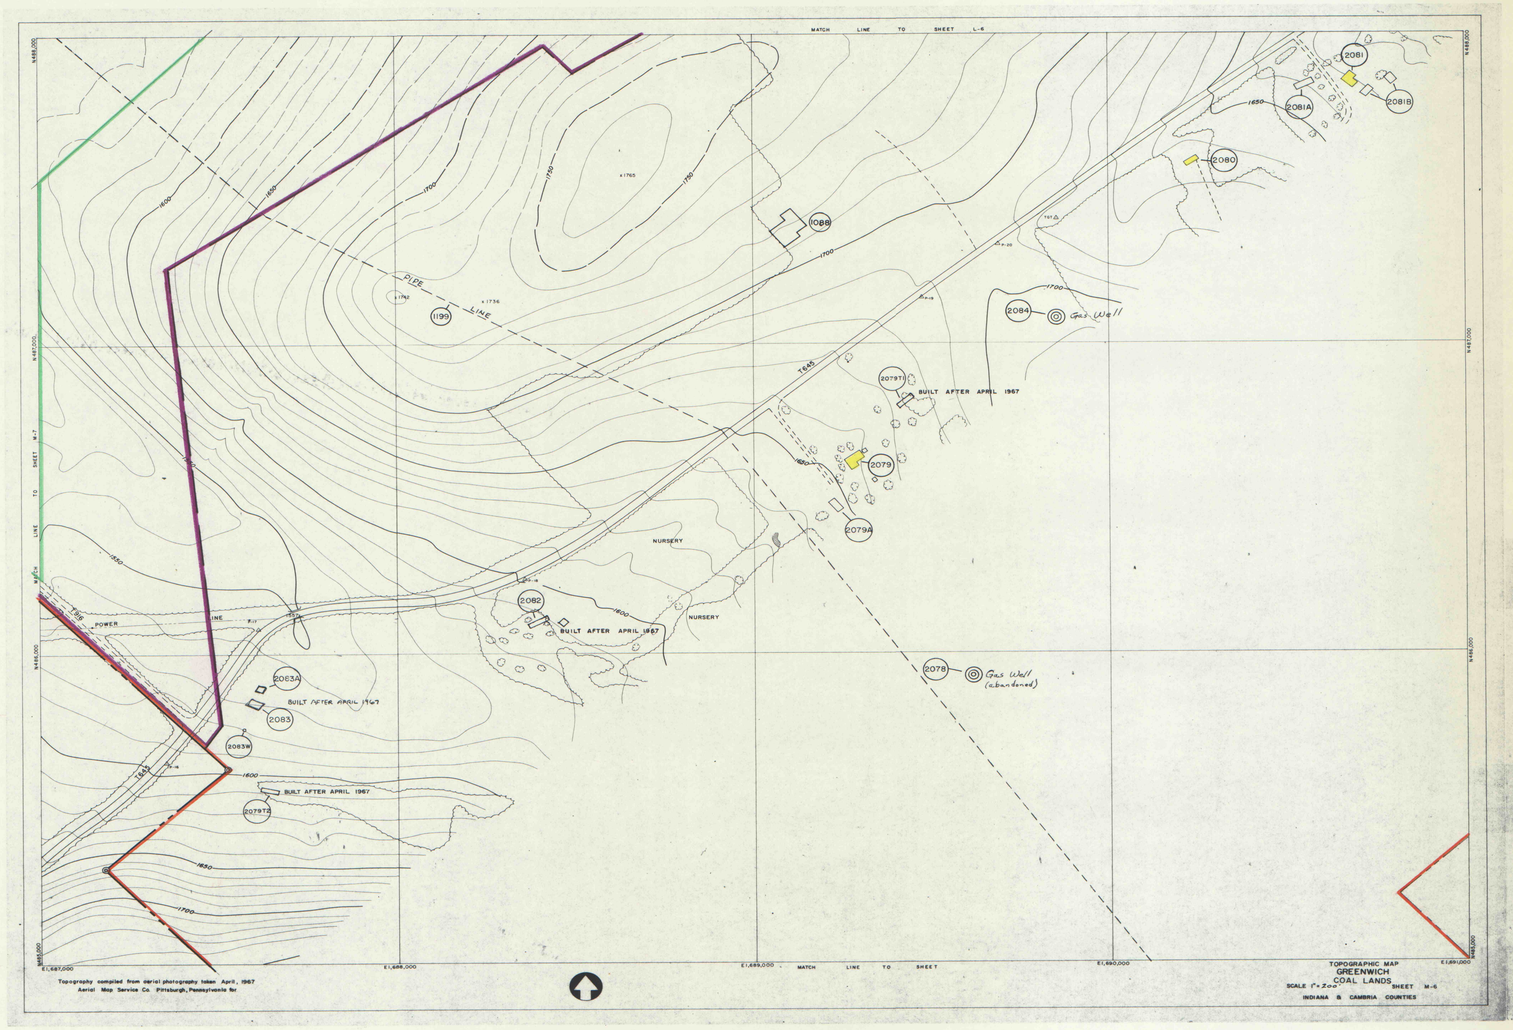

EXHIBIT "A"

COMMONWEALTH OF PENNSYLVANIA
REGISTERED PROFESSIONAL
John William Yankoske
ENGINEER
26455-E

John W. Yankoske

GREENWICH COLLIERIES
NO'S 1 AND 2 MINES
DIV. OF PENNSYLVANIA MINES CORP.

GREEN & MONTGOMERY TWPS. INDIANA COUNTY, PA.

SCALE 1"=200' SURVEY DATE 10-1-83 (REVISED- JULY 1985)

PERIOD COVERED ——— 10-1-83 THRU 1990

DWELLINGS & CEMETERIES (IN PLACE BEFORE 1966 ACT)

PUBLIC BUILDINGS; IMPOUNDMENTS (PLUS 20 AC. FEET)

BOUNDARY OF MINE

POLITICAL SUBDIVISION BOUNDARIES

SUBSIDENCE CONTROL PLAN BOUNDARY

PERMIT BOUNDARY

FEATURE IDENTIFICATION NO. (1)