


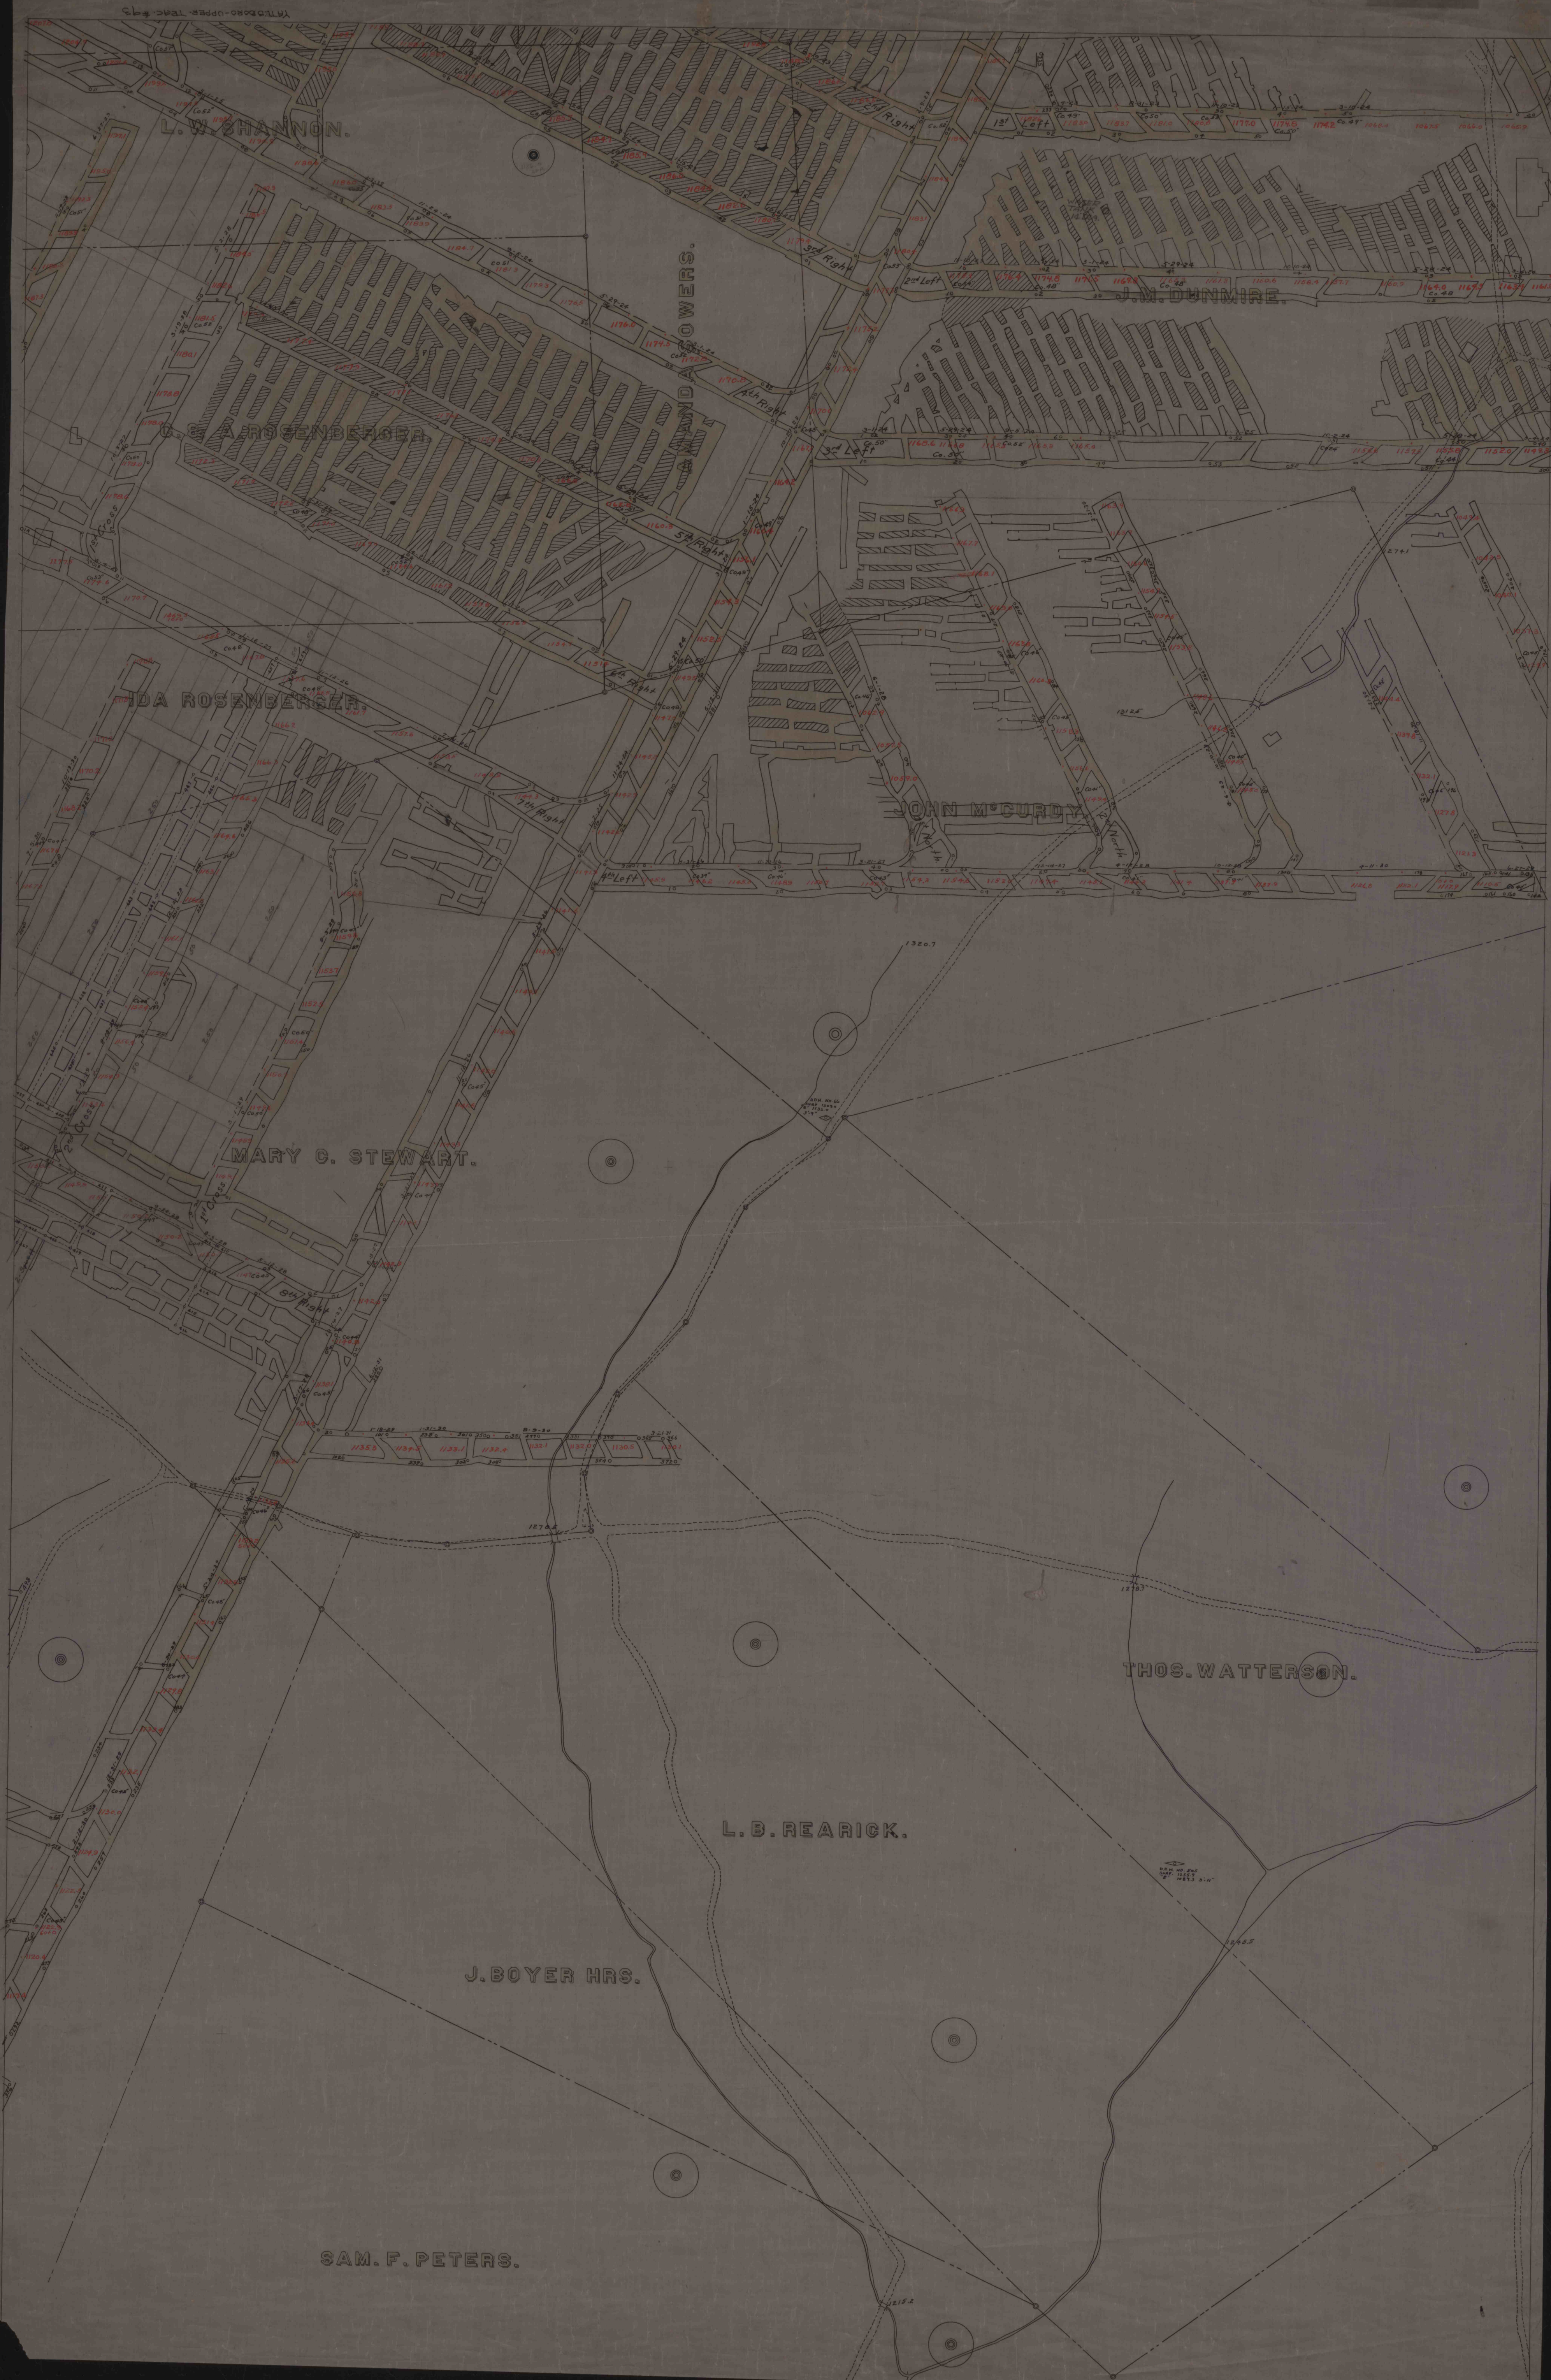

L. W. SHANNON.

J. BOYER HRS.

MARY C. STEWART.

L. B. REARICK.

THOS. WATTERSON.

SAM. F. PETERS.

DAVID LOWERS.

JOHN M. GURDY.