


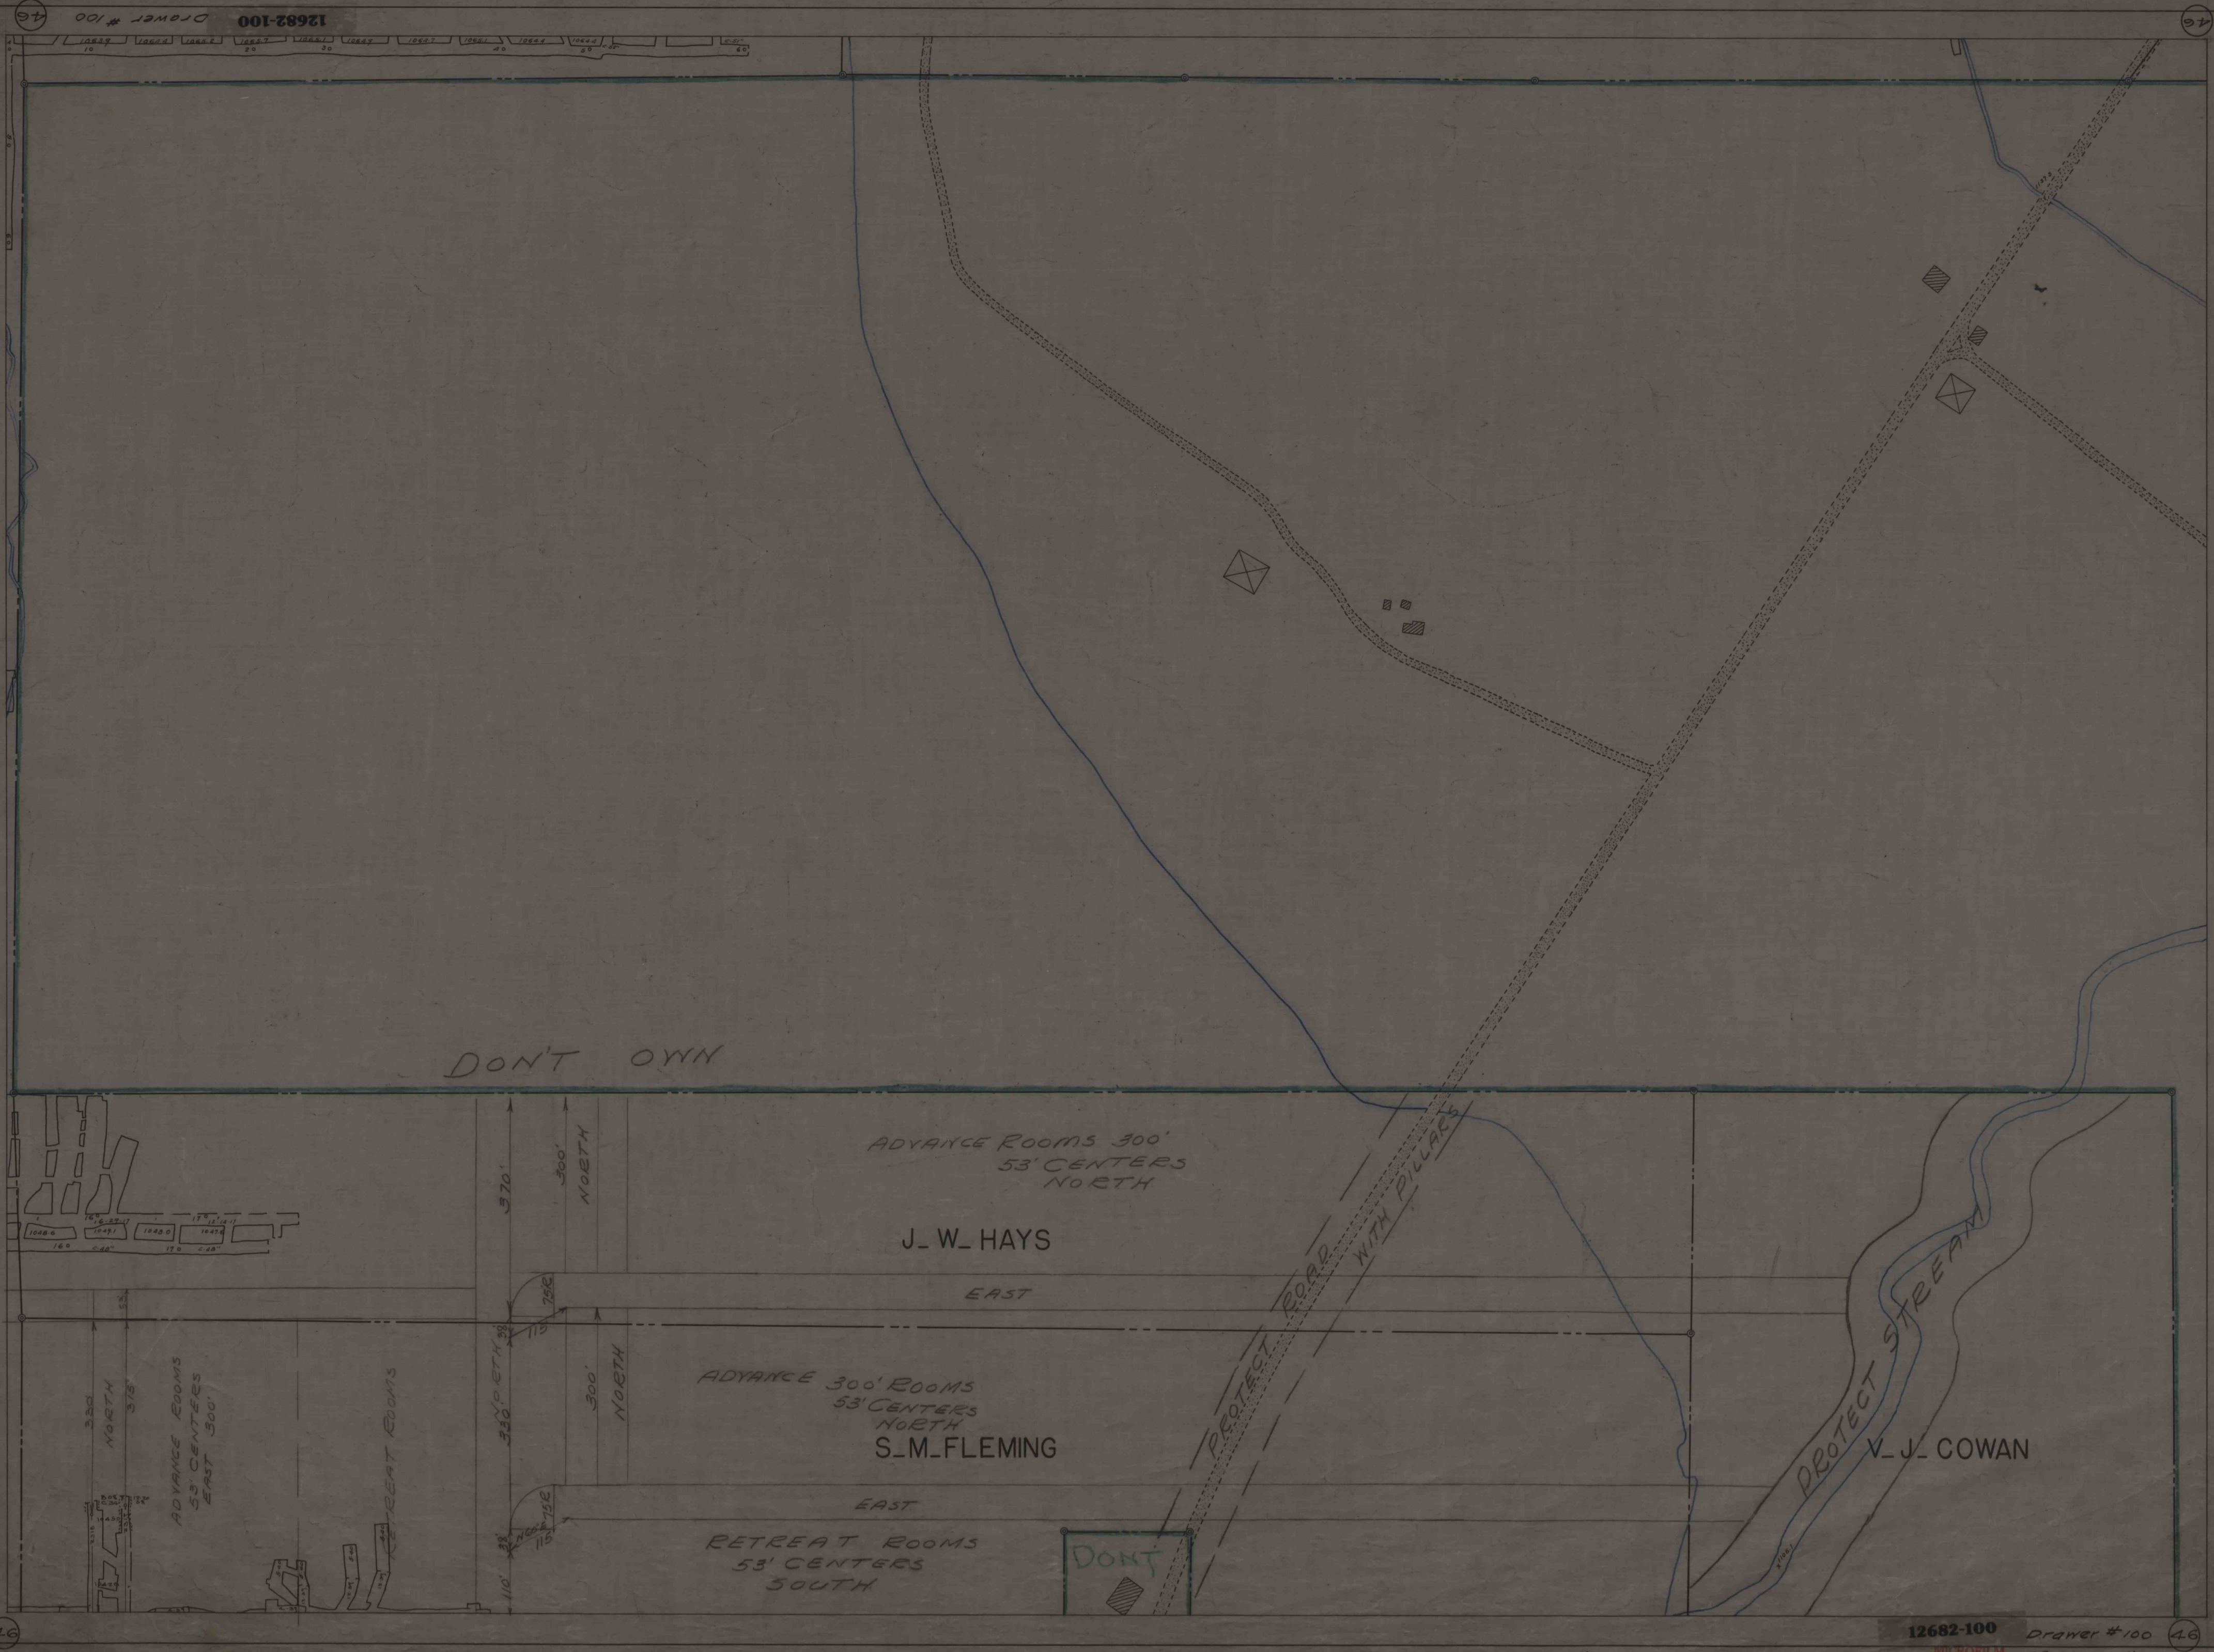

46

12682-100
Drawer #100

46

46

12682-100
MICROFILM
03 22 D-9 46 100

H.C. - D-9

Drawer #100
03 22 D-9 46 100