


37

12682-100
DRAWER #100

37

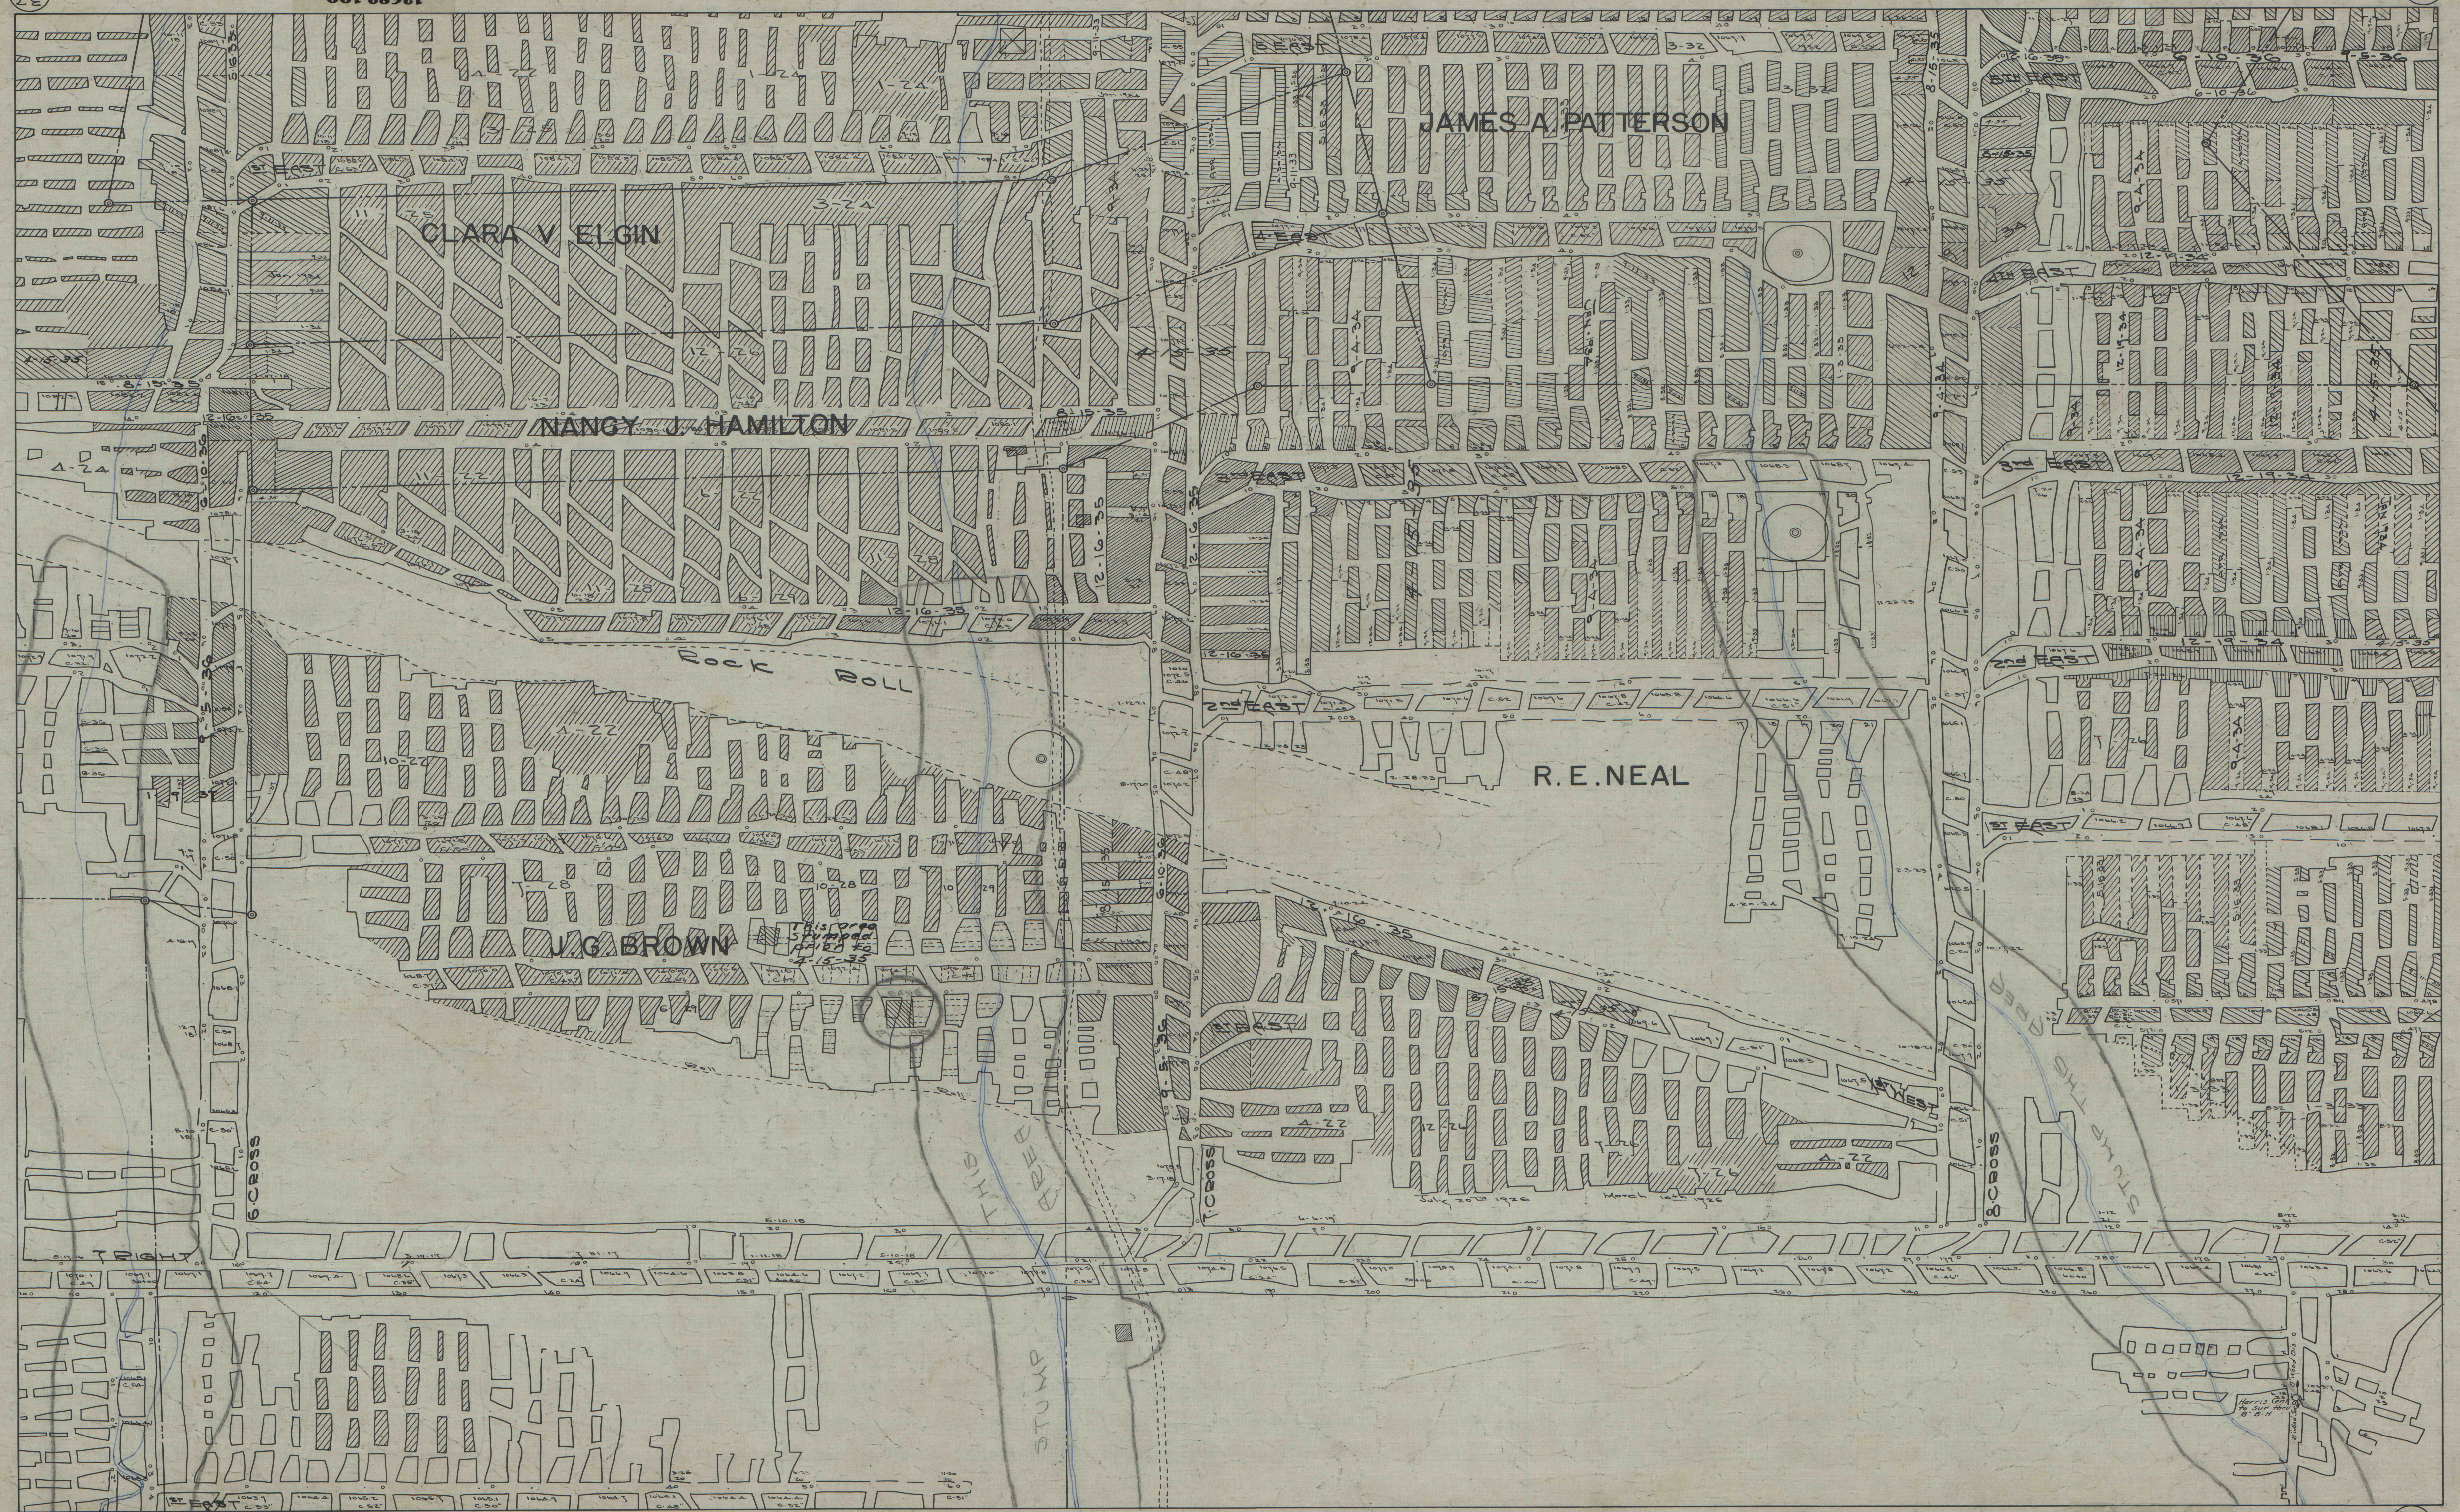

37

H.C.-D-9

12682-100
MICROFILM
Drawer #100
03 22 D-9 37 100

37