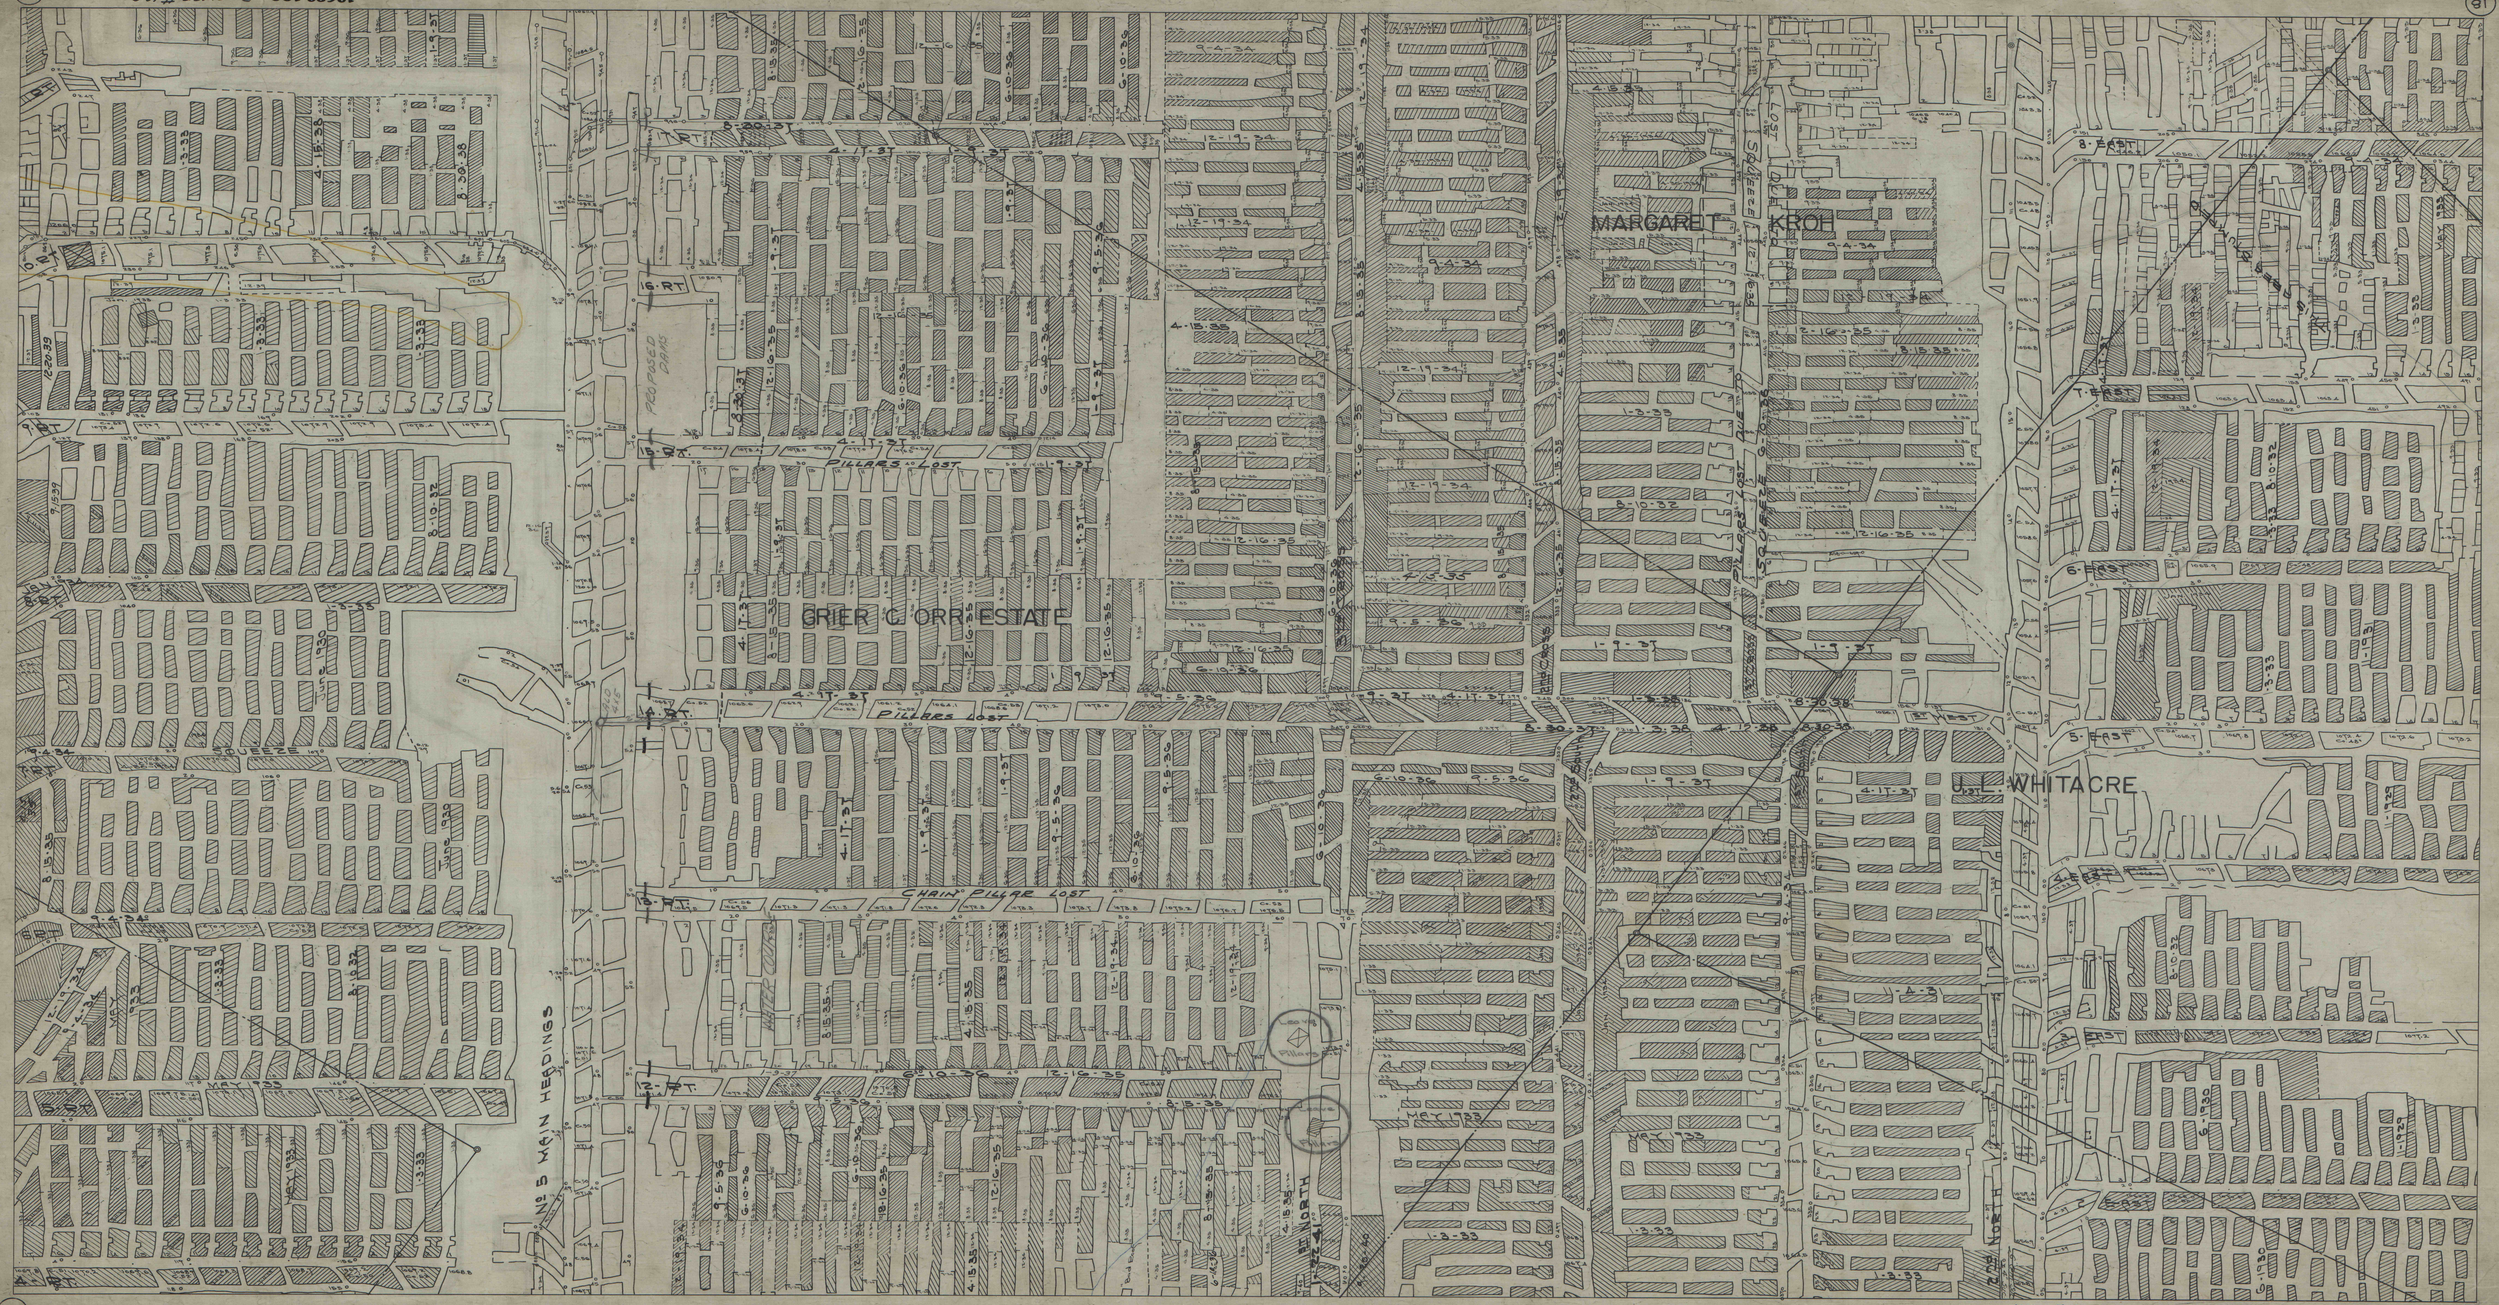

18
12682-100 Drawer #100
GRIER C. ORR ESTATE
MARGARET KROH
J. L. WHITACRE
No 5 MAIN HEADINGS
PROPOSED DAMS
PILLARS LOST
CHAIN PILLAR LOST
WATER COURSE
SQUEEZE
Leave Pillars
Leave Pillars
Bad Roof
OLD 4X5
16-RT.
15-RT.
14-RT.
13-RT.
12-RT.
17-RT.
10-RT.
9-RT.
8-RT.
7-RT.
6-RT.
5-RT.
4-RT.
8-EAST
7-EAST
6-EAST
5-EAST
4-EAST
3-EAST
2-EAST
1ST WEST
1ST NORTH
2ND NORTH
1ST SOUTH
2ND SOUTH
2ND CROSS
1ST CROSS
SQUEEZE
PILLARS LOST
June 1930
MAY 1933
JAN. 1934
6-1930
1-1929
1-1931
12-20-39
9-15-39
1-22-41
4-20-40
8-30-38
1-3-38
4-15-38
1-9-37
18

H.C.-D-6

Drawer #100

12682-100

MICROFILM 03 22 D-6 18 100