


12682-100 TRACING 103
39"

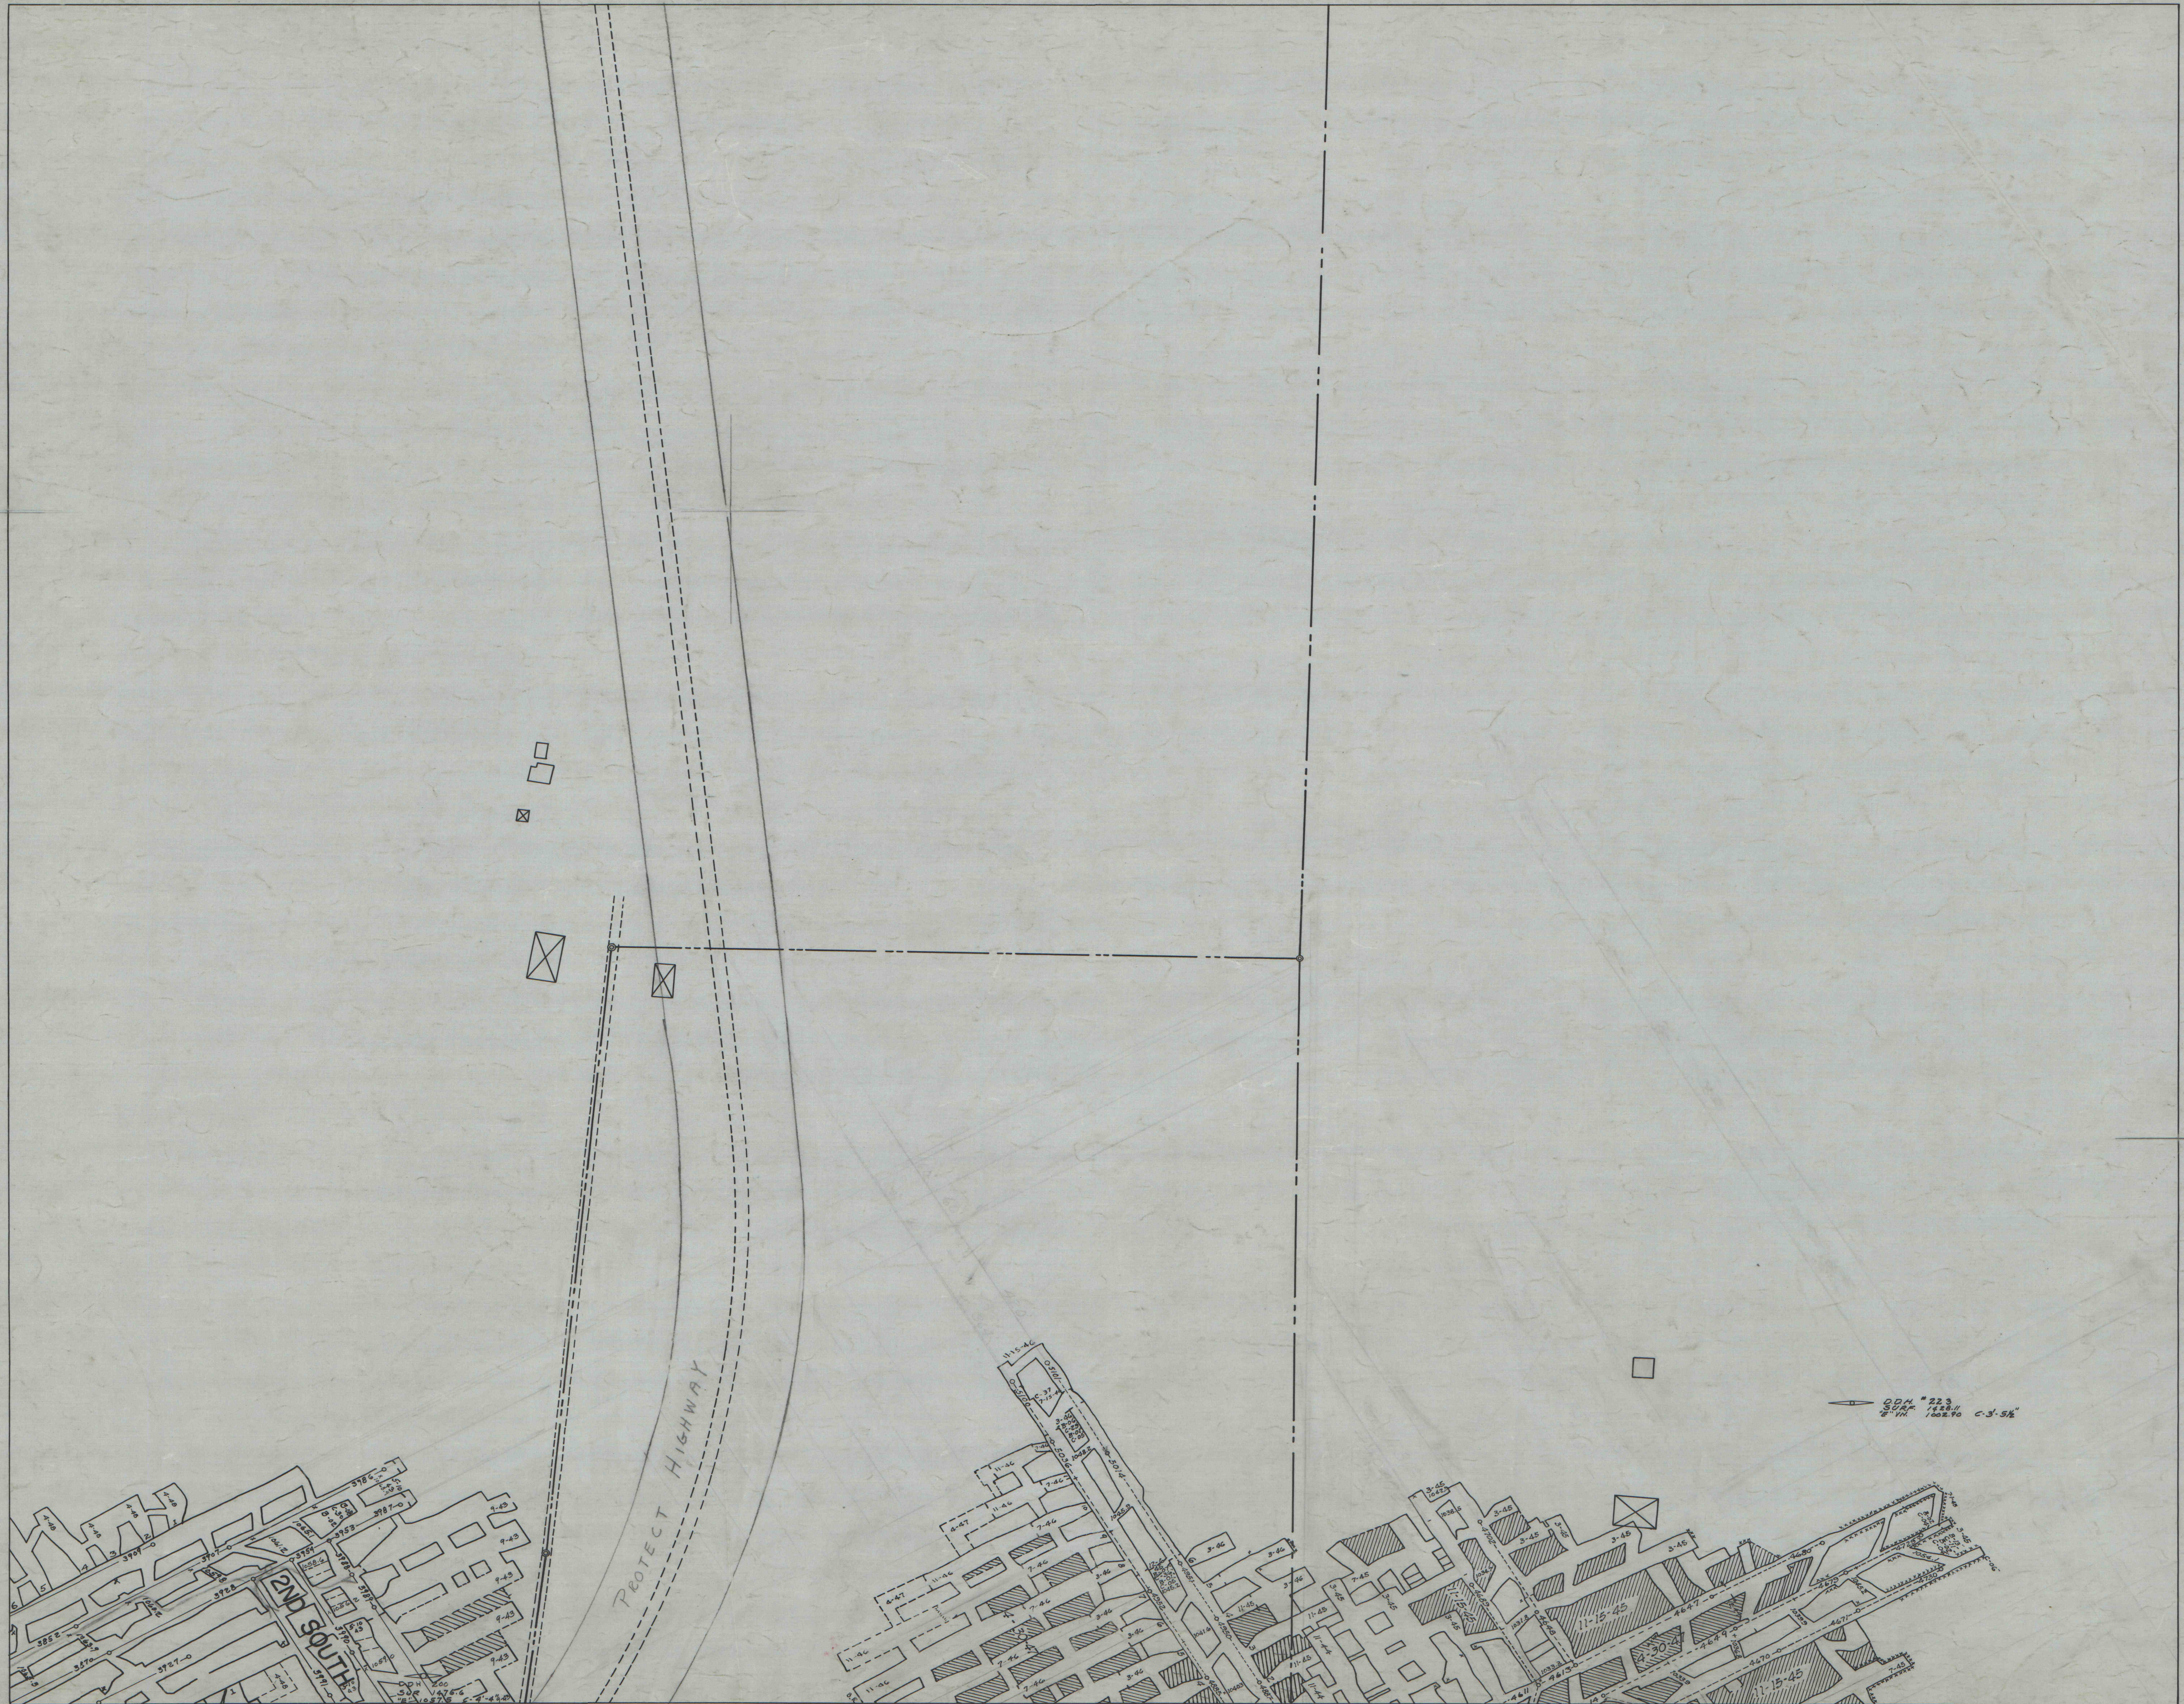

DBM #223
SURF 1123.11
8' 11" 1002.90 C-3-5 1/2