
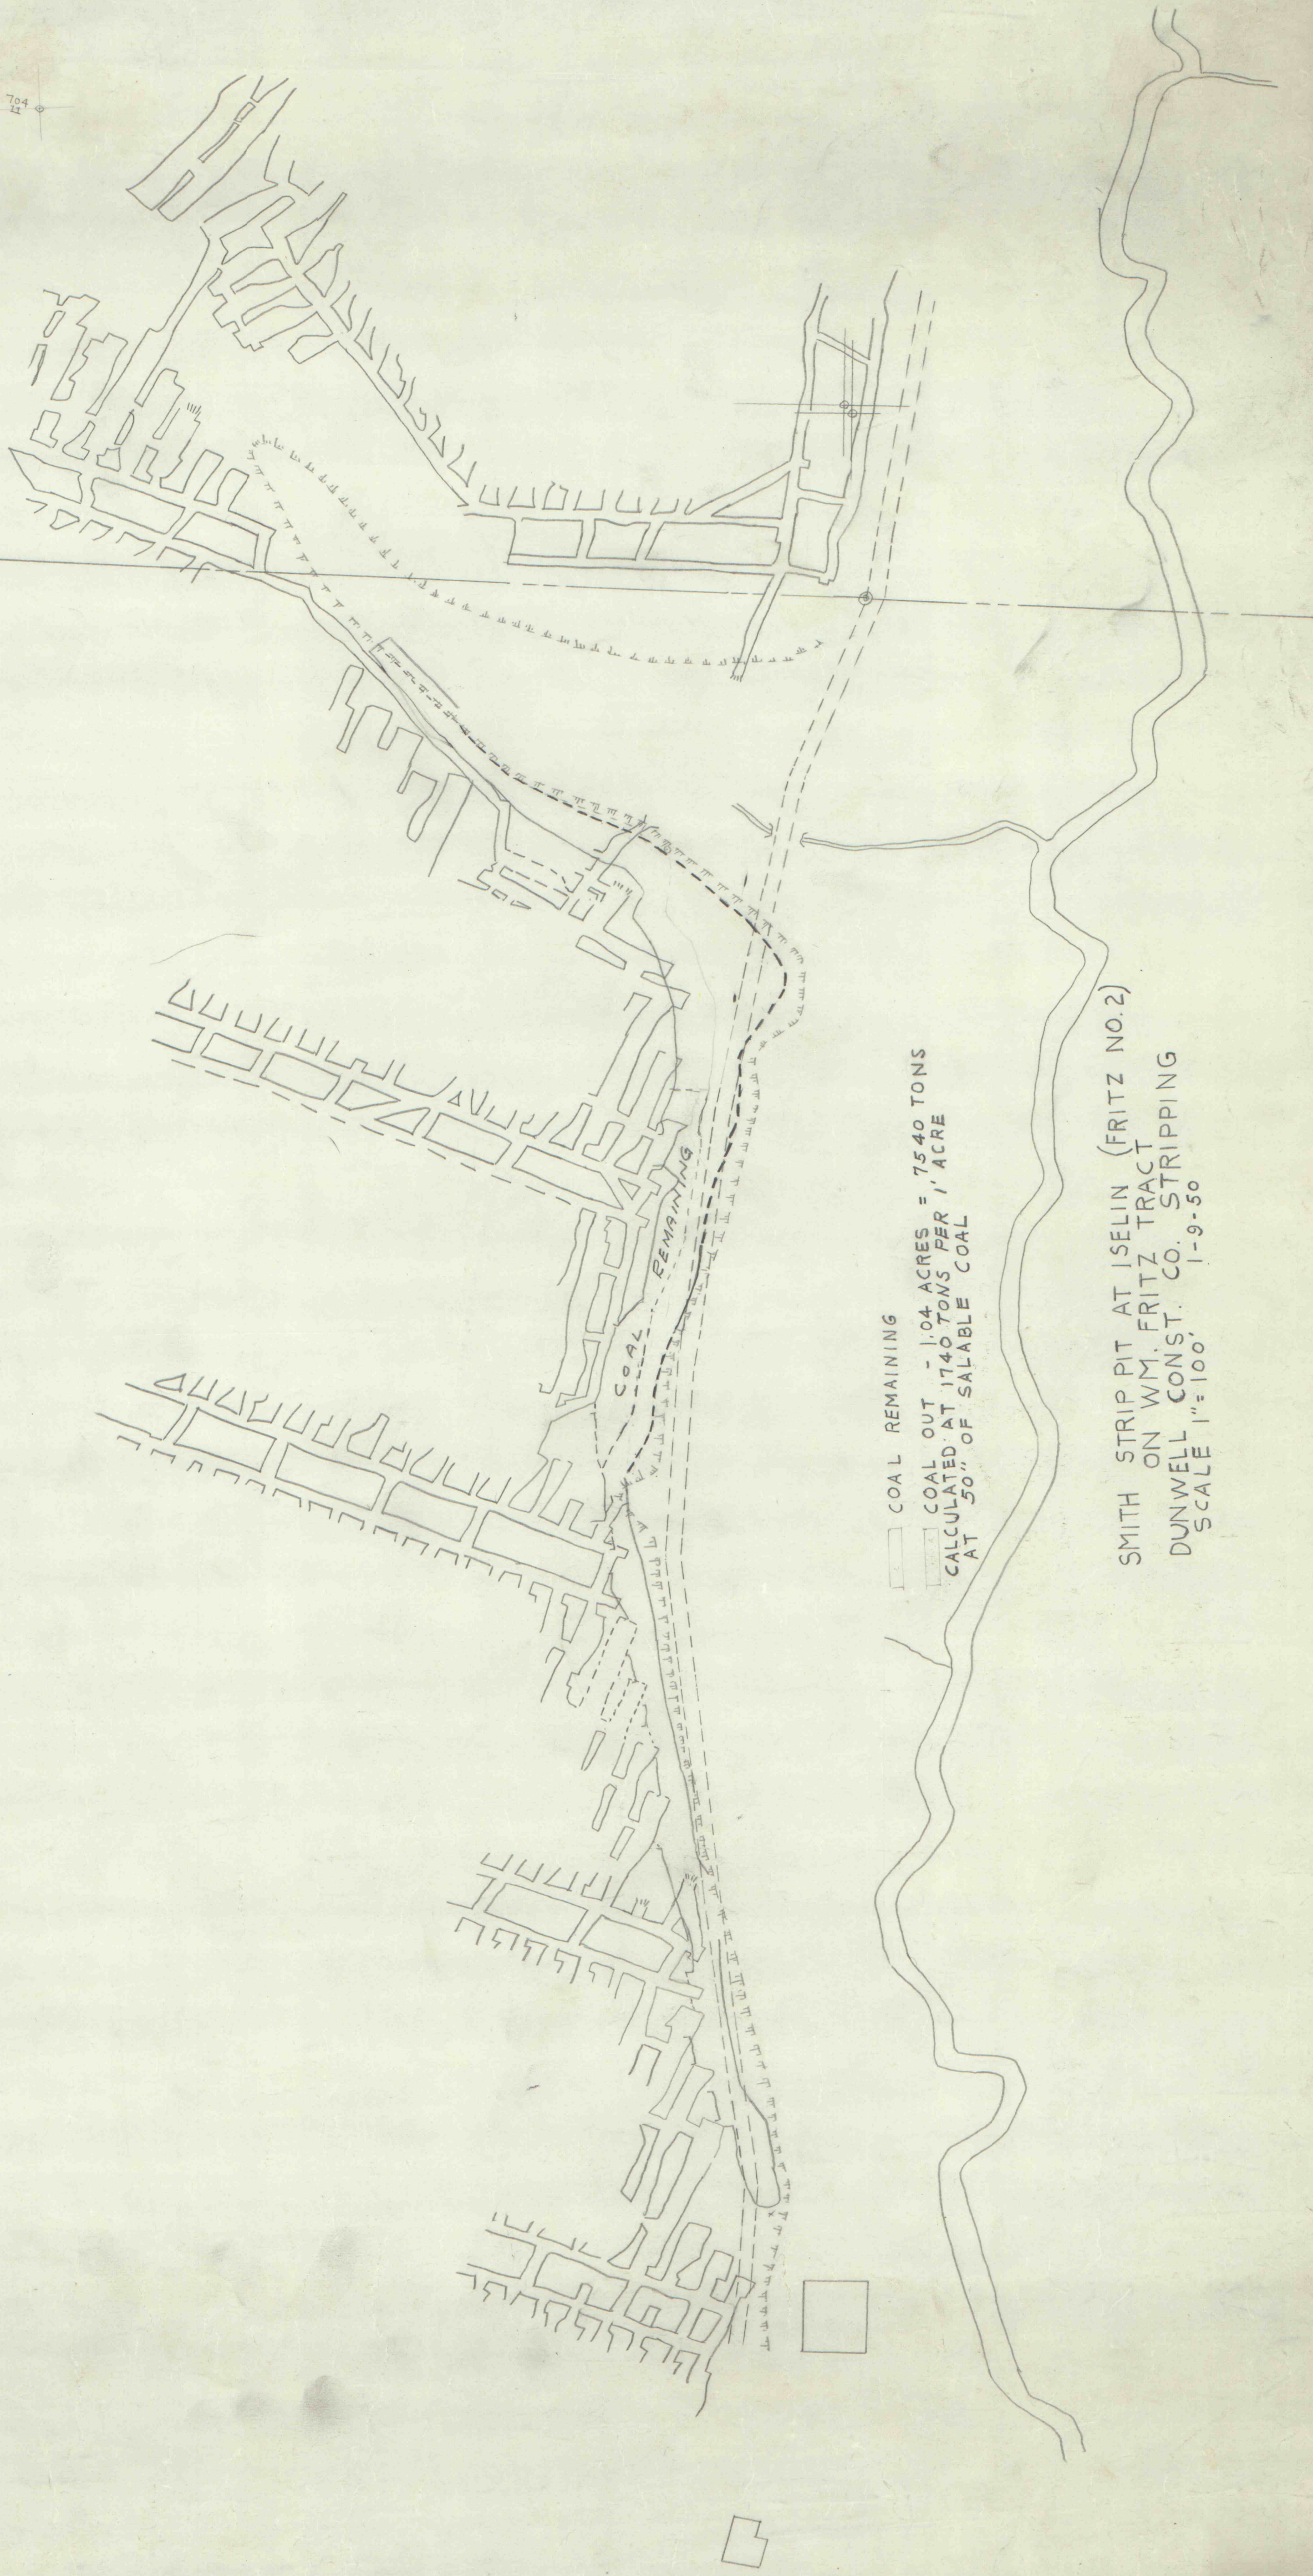


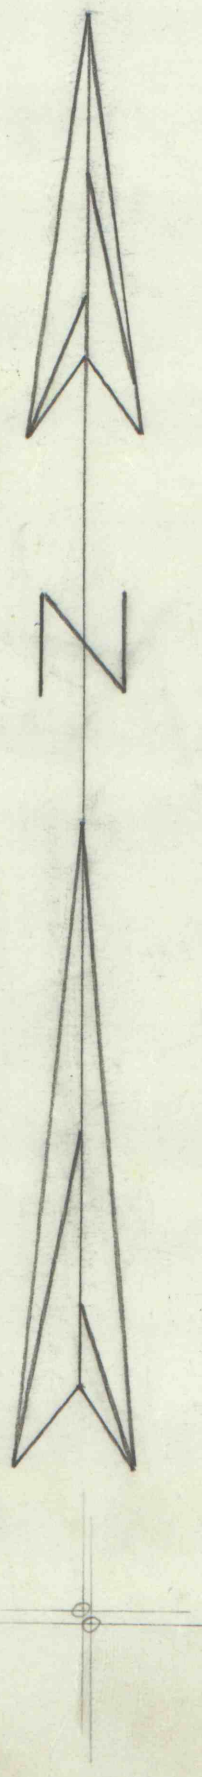

COAL REMAINING
COAL OUT - 104 ACRES = 7540 TONS
CALCULATED AT 1740 TONS PER 1' ACRE
AT 50" OF SALABLE COAL

SMITH STRIP PIT AT ISELIN (FRITZ NO.2)
ON WM. FRITZ TRACT
DUNWELL CONST. CO. STRIPPING
SCALE 1"=100' 1-9-50