10469-96

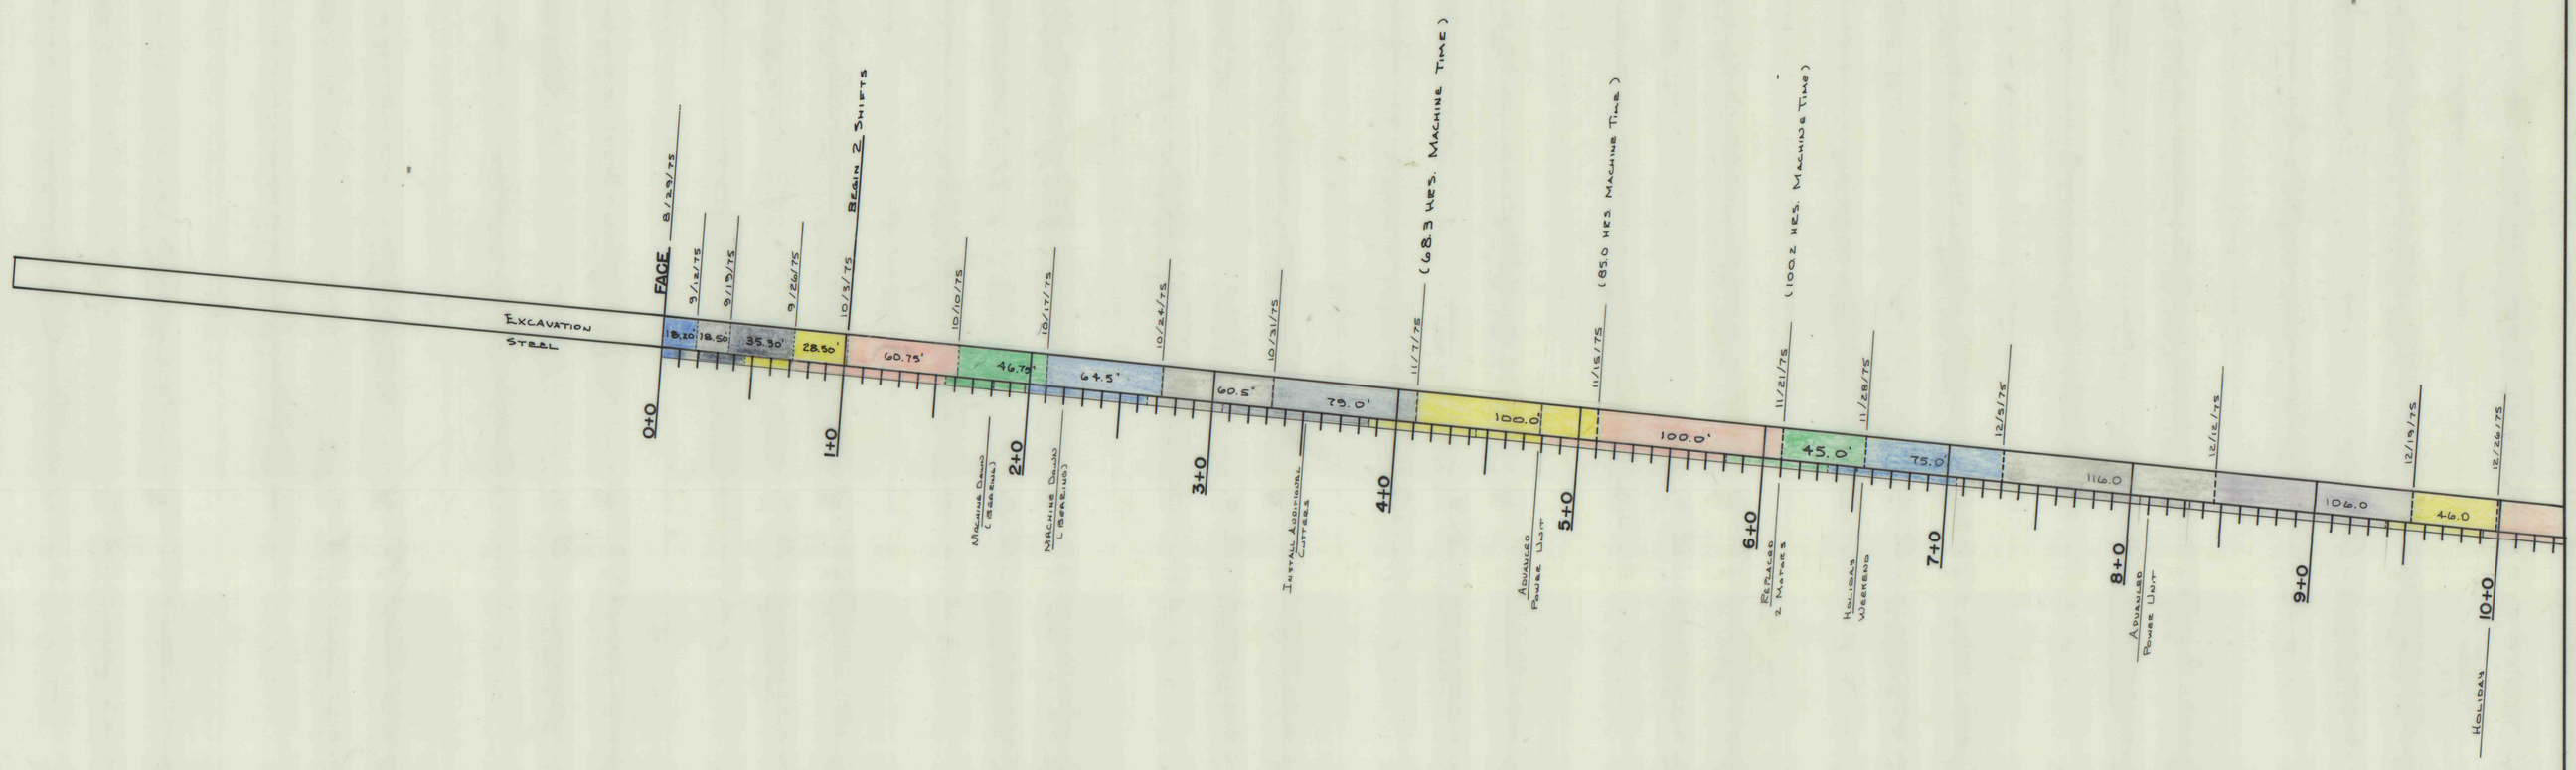


19 1193 HERCULENE A. B. B. SMITH CO., PGH., PA.

PR 9070-274

IMAPS #09152 10469-96