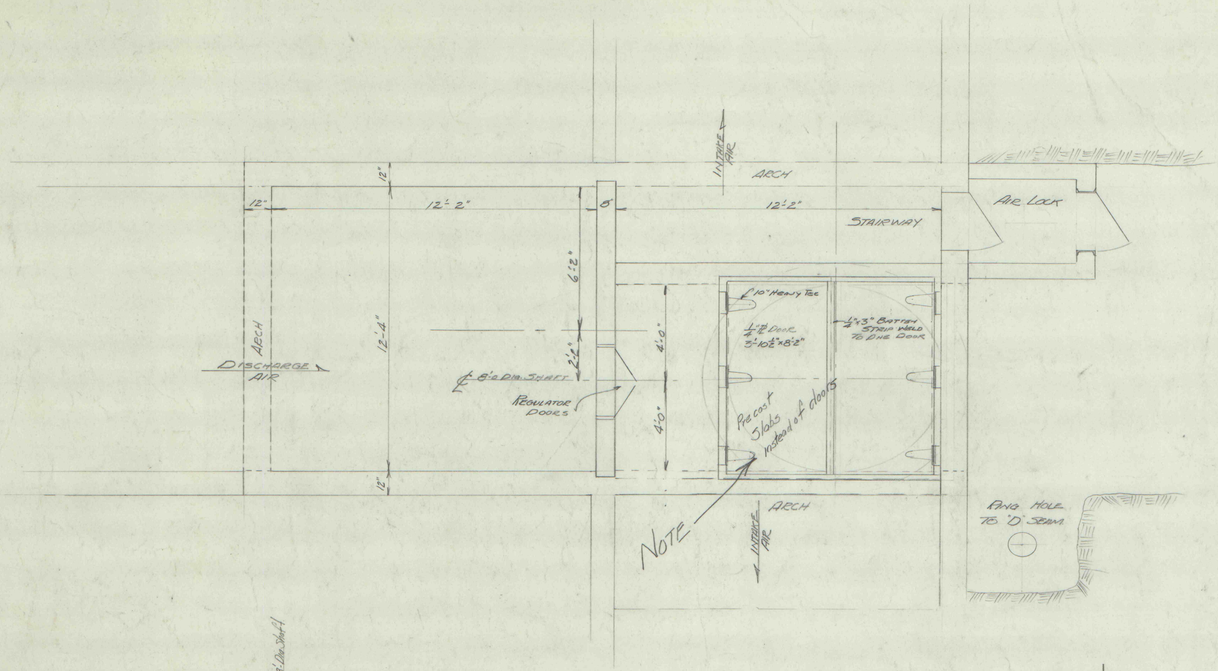

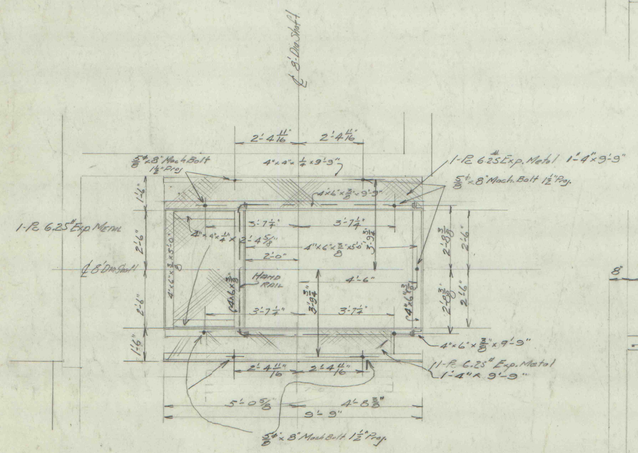

PLAN OF STEEL @ TOP OF SHAFT

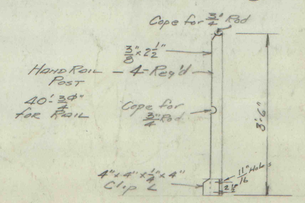

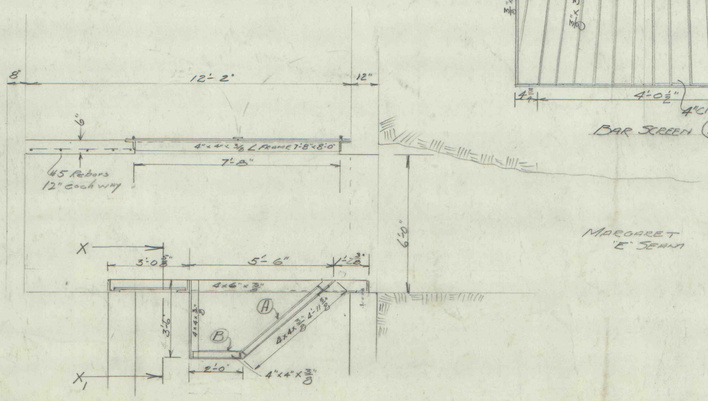

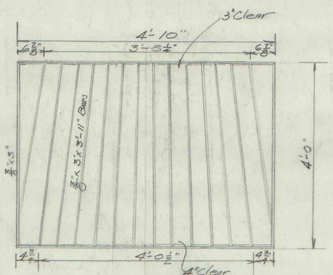

BAR SCREEN (A)

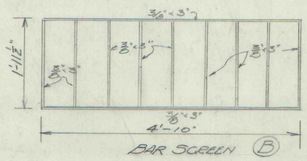

BAR SCREEN (B)

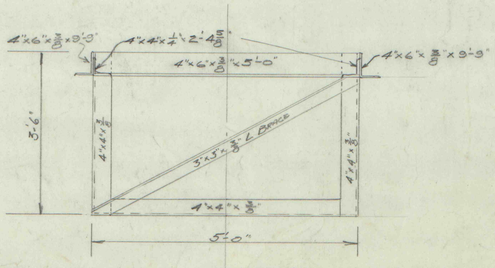

SECTION X-X1

ROCHESTER & PITTSBURGH COAL CO. ENGINEERING DEPT., INDIANA, PA.	
ENCLOSURE TOP OF 8'-0 DIA. SHAFT MARGARET TO JANE	
MADE BY Bill	SCALE 3/8"=1'-0"
TRACED BY	DATE 4-11-67
CHECKED BY	NO. M-459-M(1)

B. K. ELLIOTT CO., PGH., PA. REORDER A-23471

IMAP # 09165

9685-96