
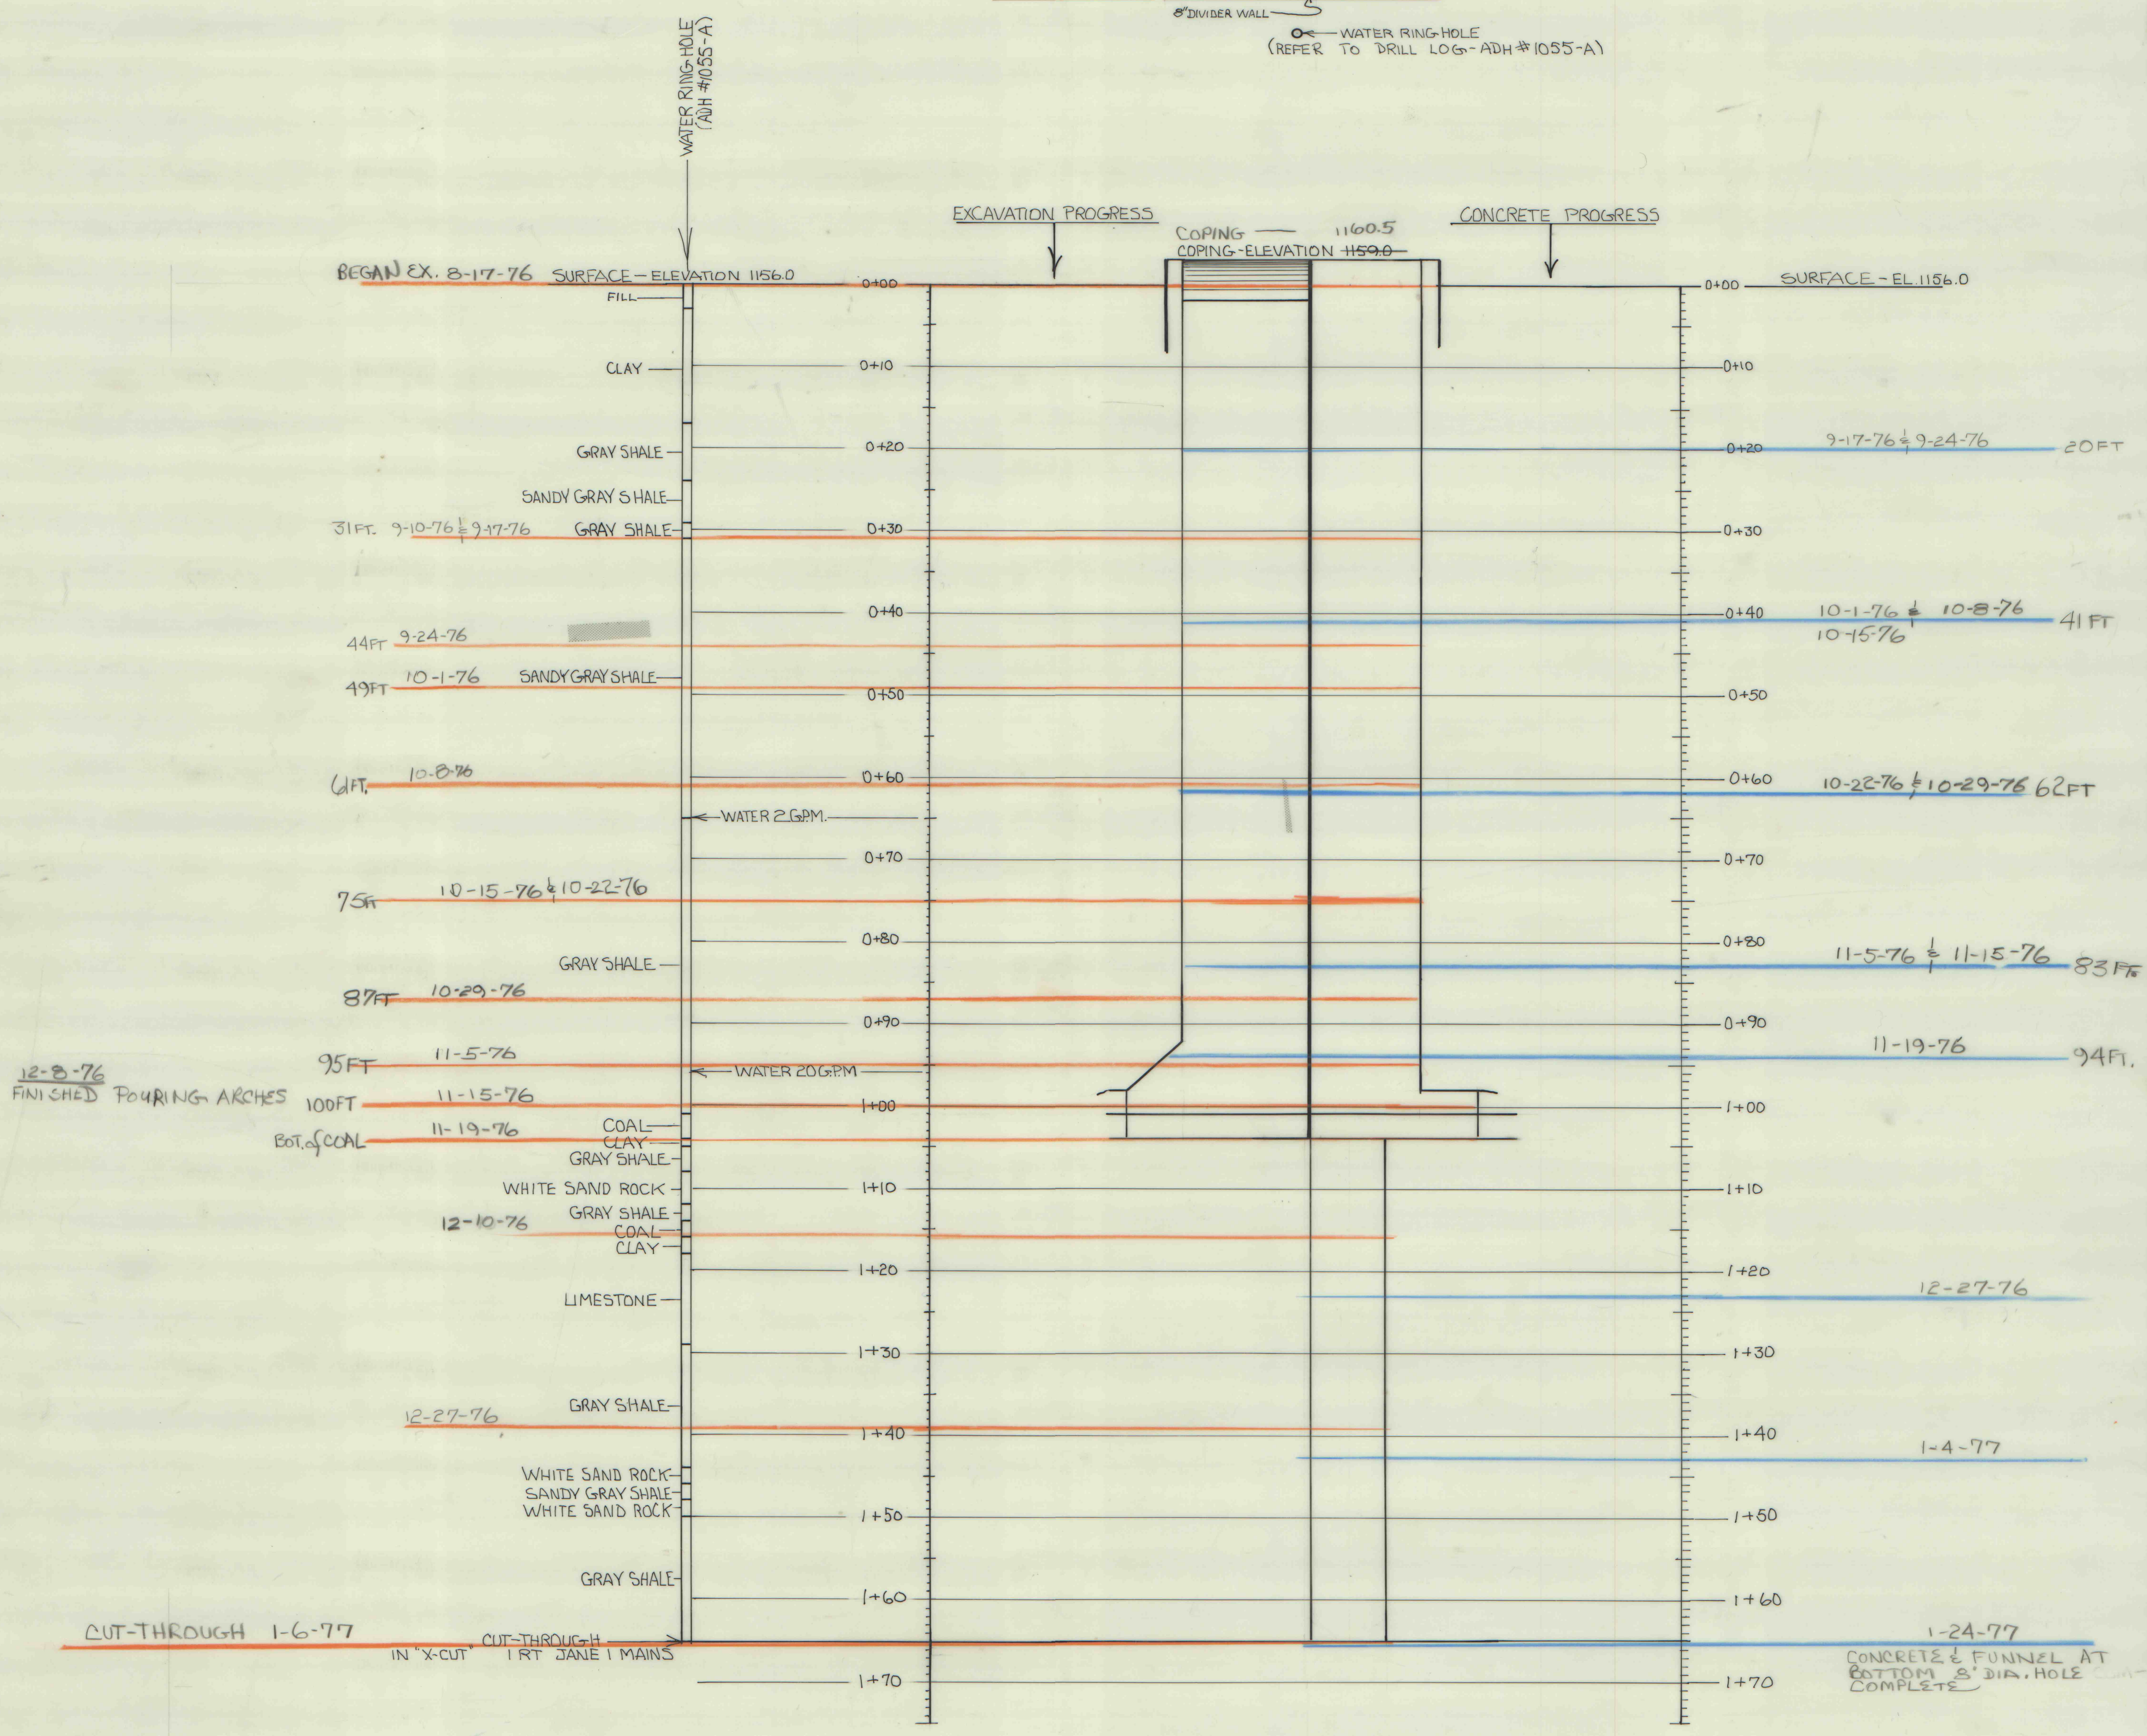


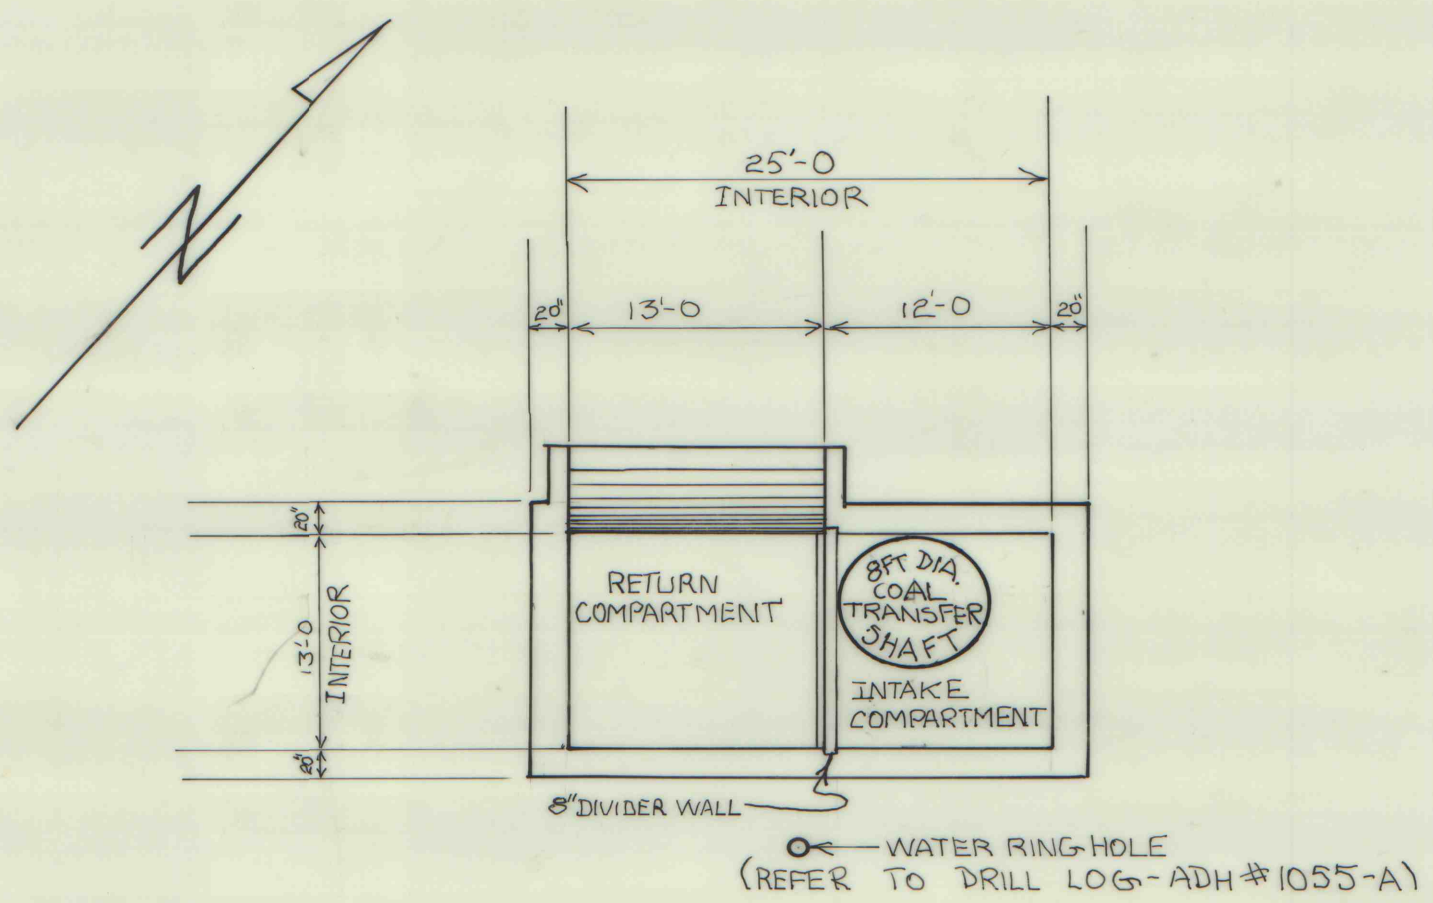

MADE BY SOT
 TRACED BY
 SCALE 1"=10FT
 DATE 8-10-76
 NO.

ROCHESTER & PITTSBURGH COAL CO.
 ENGINEERING DEPT., INDIANA, PA.
 PROGRESS FOR EMULE #4 -
 VENTILATION AND COAL
 HANDLING SHAFT

REVISED 9-22-76 TO SHOW SHAFT
 TRANSFER SHAFT TANGENT TO
 MAIN SHAFT

10374-92