


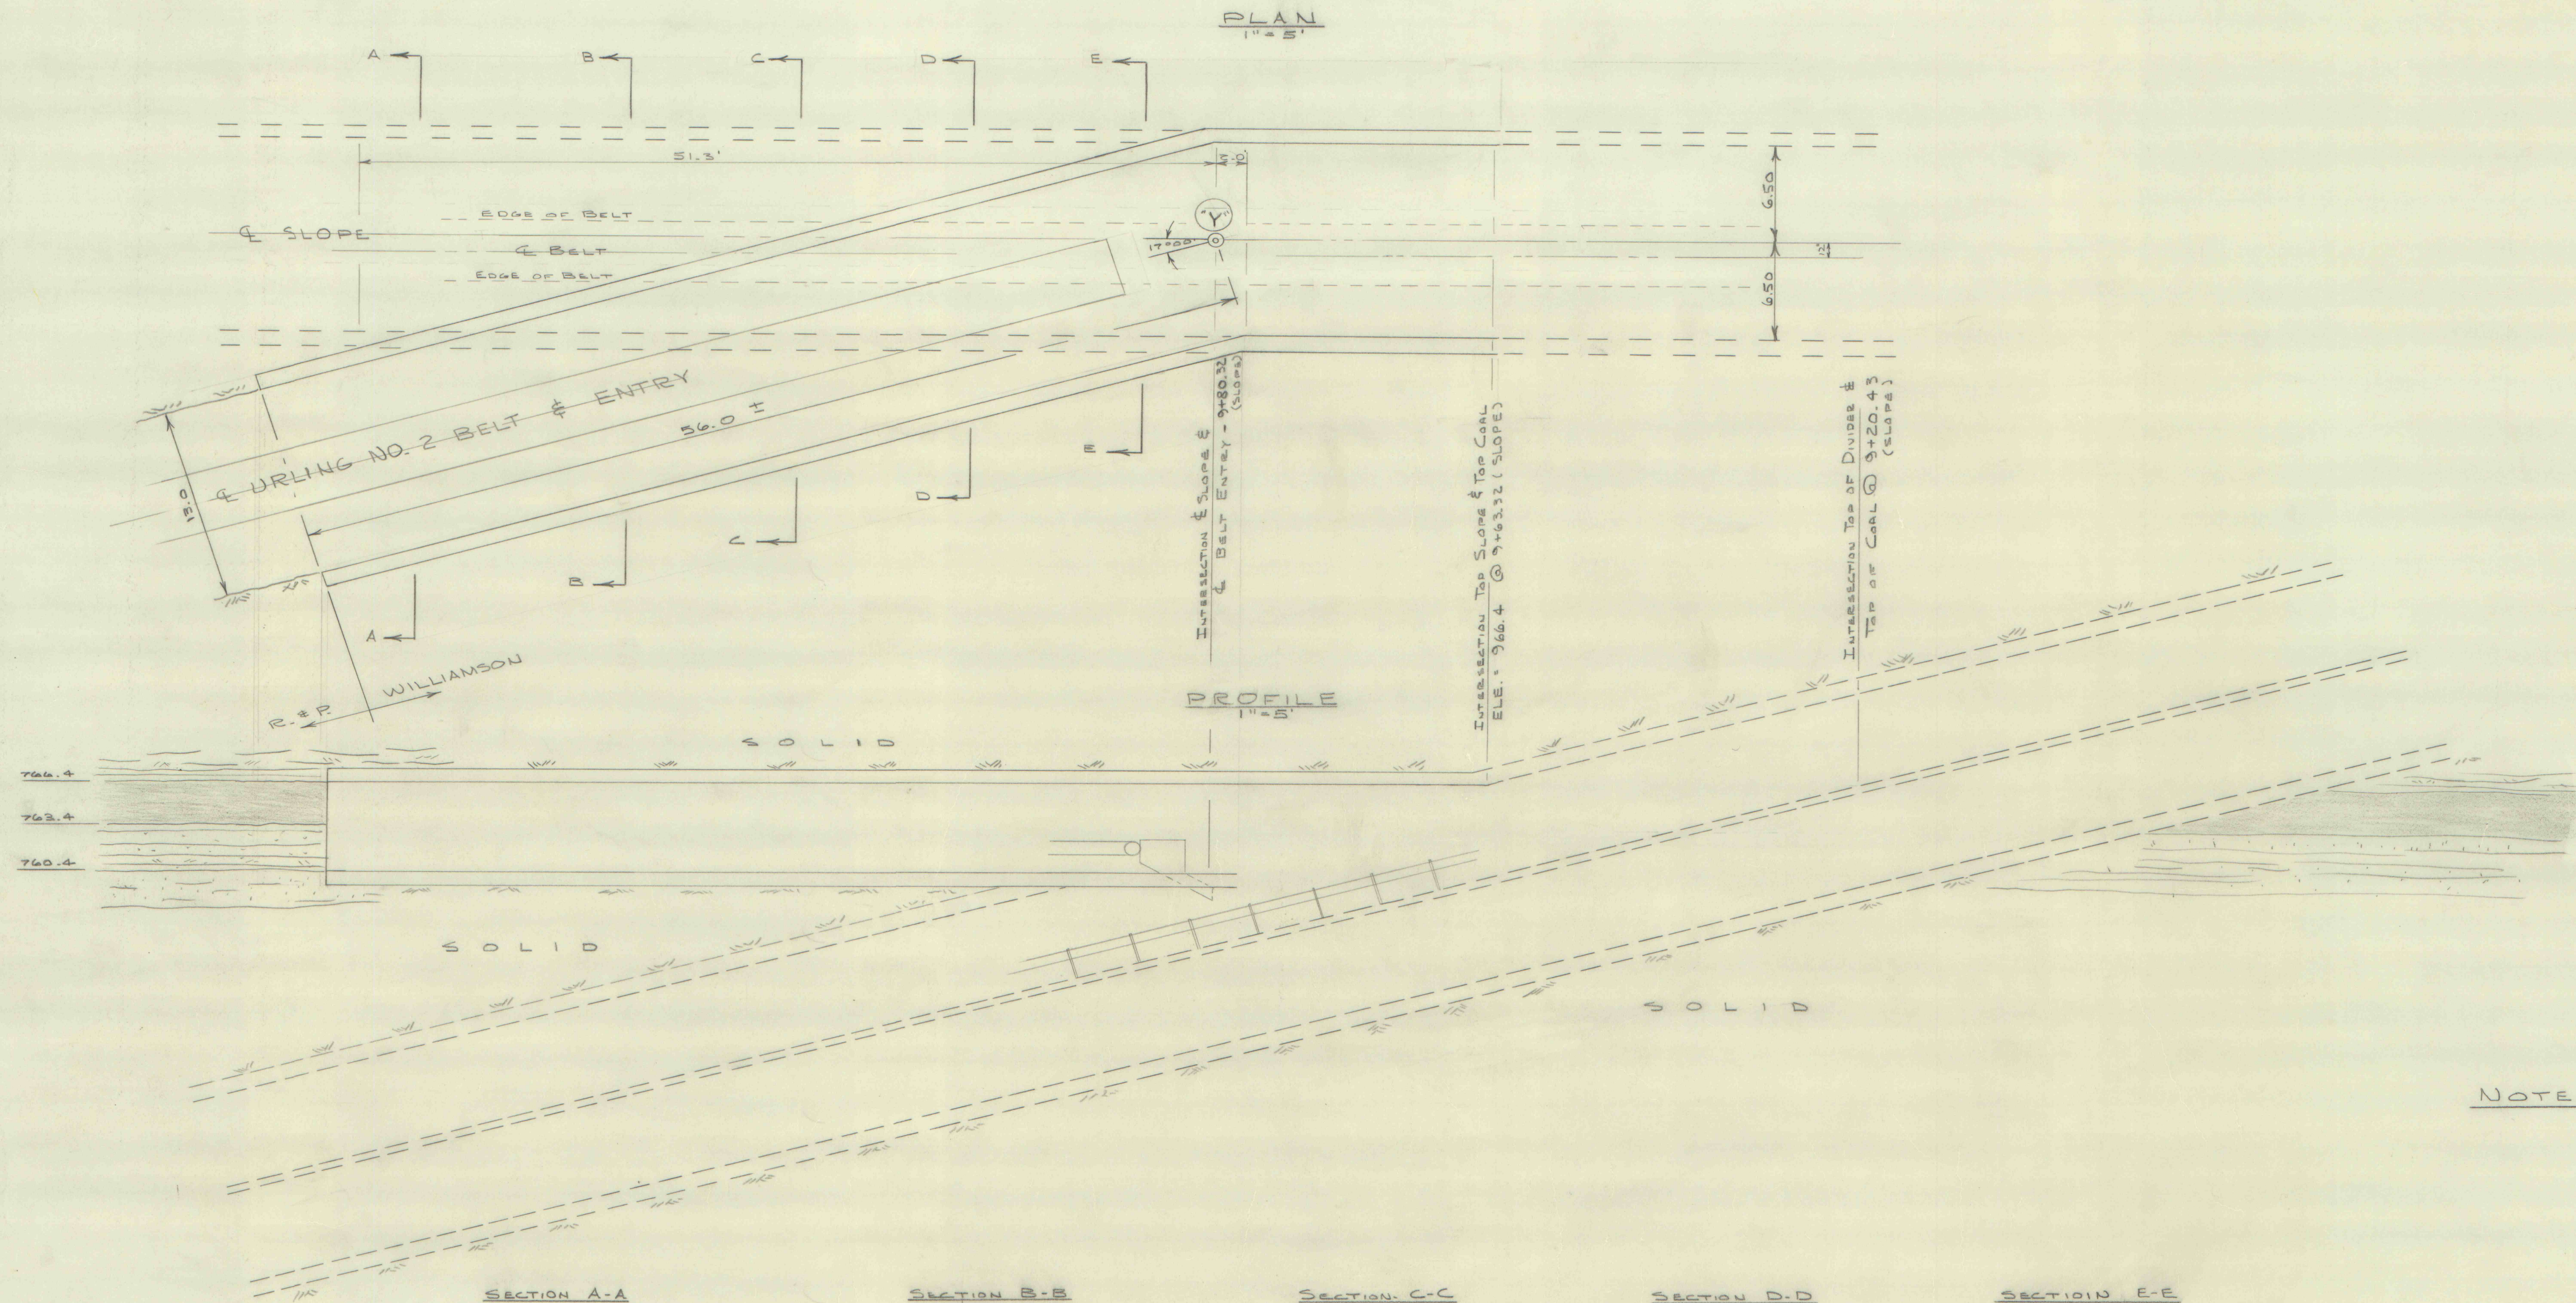

NOTE:

STATION 425 TO "Y"
HORIZONTAL - 298.57
@ 16° 15' - 310.99

STATION 426 TO "Y"
HORIZONTAL - 101.94
@ 16° 15' - 106.12

△ REV. LOCATION OF
SLOPE BELT CHANGED
TO 12" LEFT.

ROCHESTER & PITTSBURGH COAL CO.
ENGINEERING DEPT., INDIANA, PA.

URLING No. 2

BELT ENTRY TURNOUT

MADE BY JJSZ SCALE AS NOTED

TRACED BY DATE 8-11-75

CHECKED BY NO.

Imaps # 09179

10853-96

PR 6700-168