


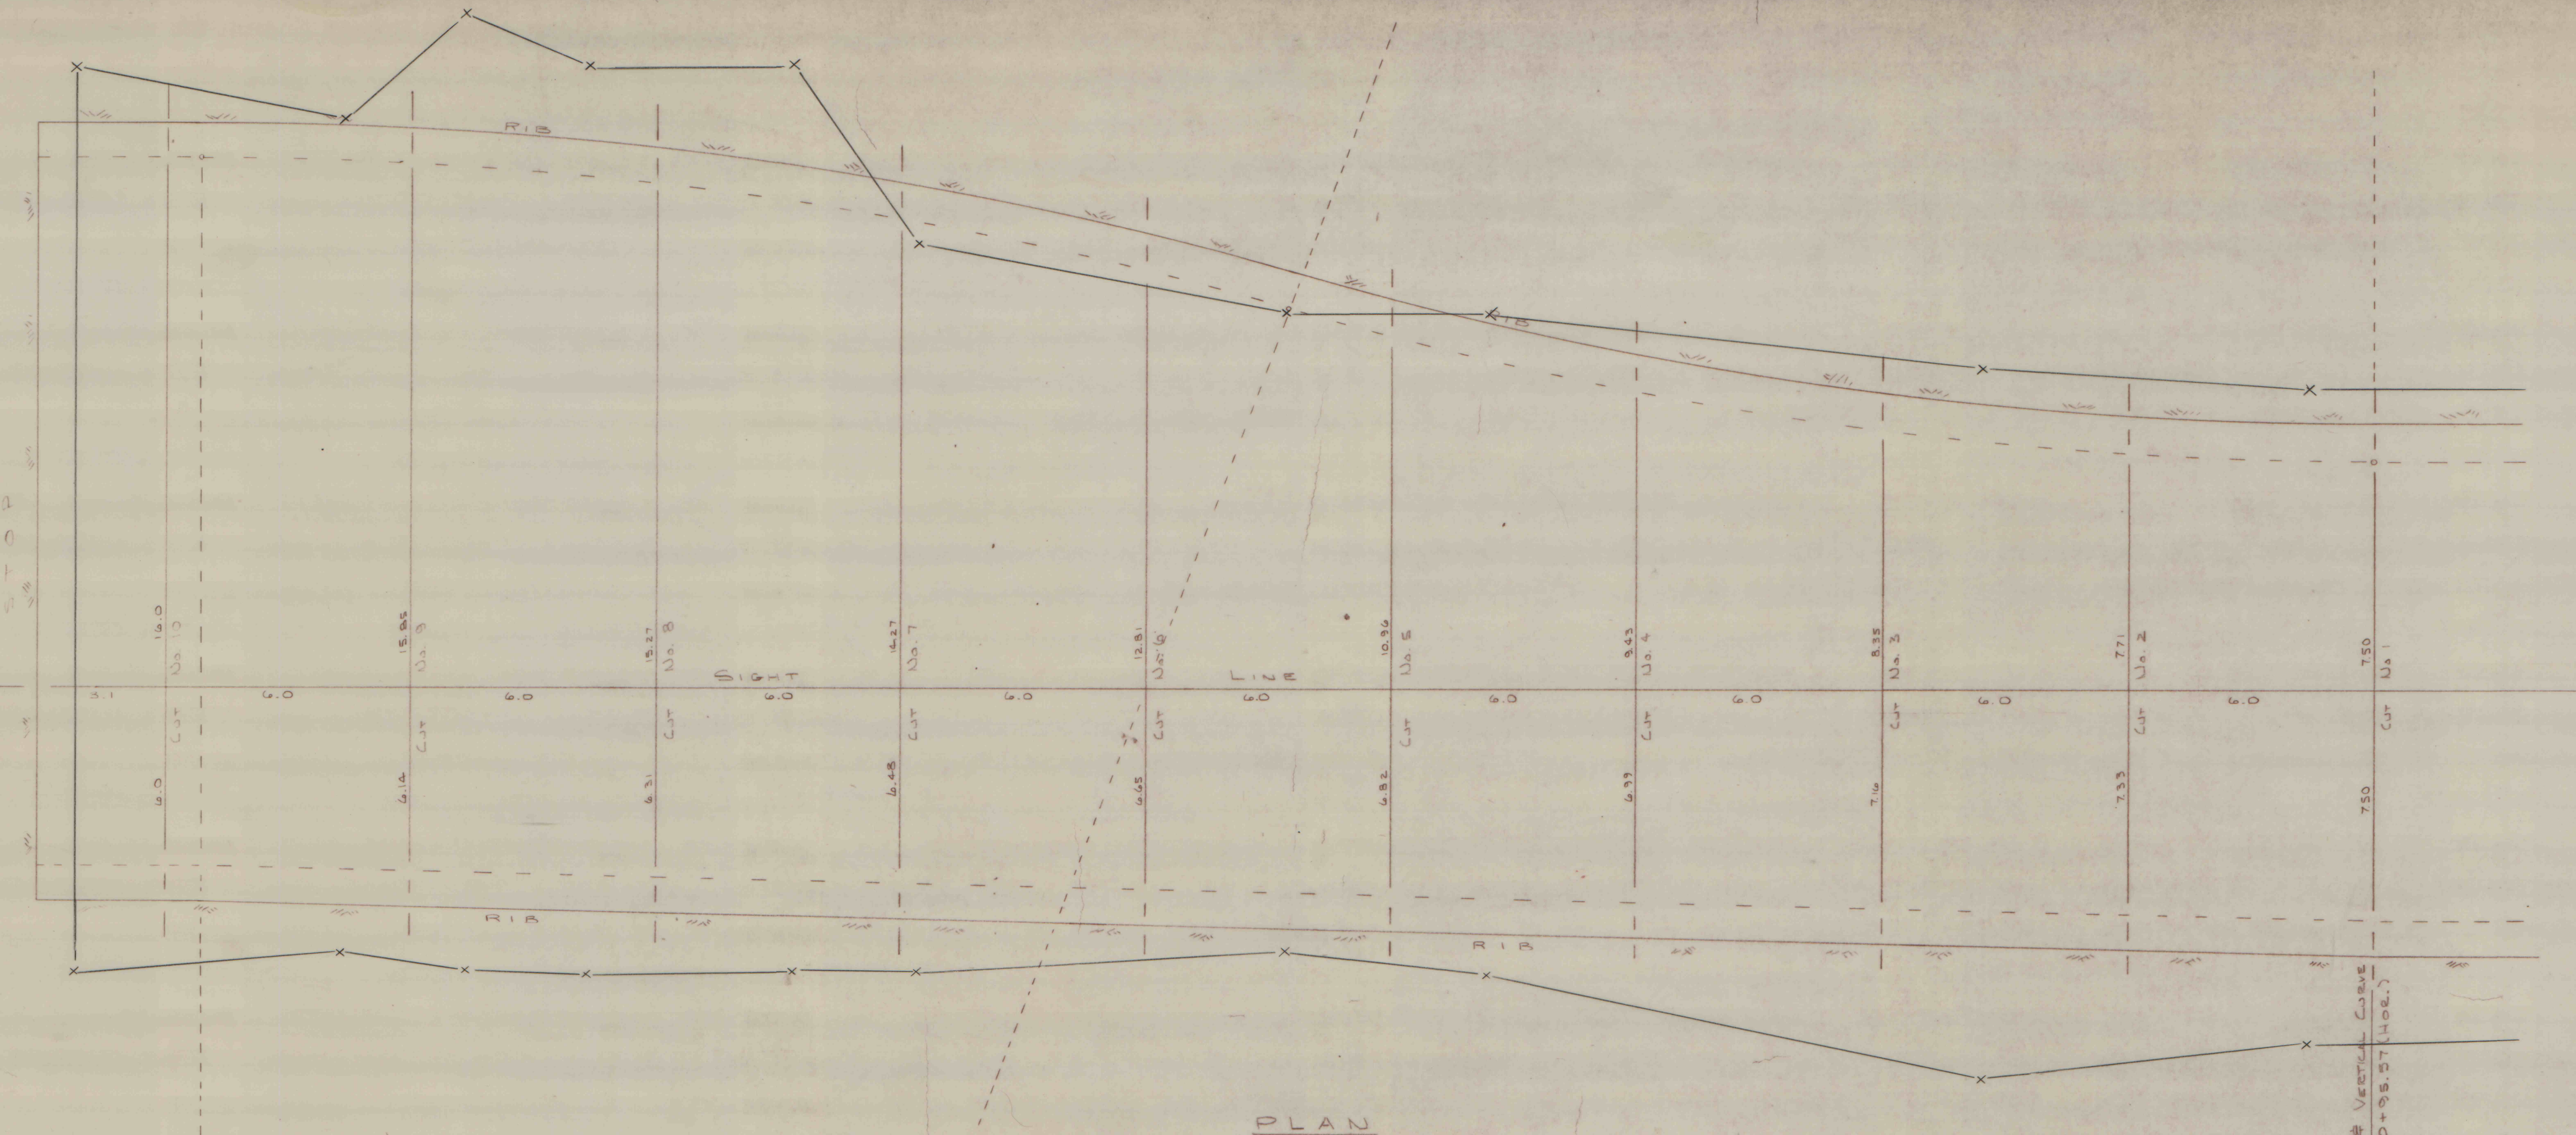

PLAN
1"=2'

X SURVEY LOCATION

BEGIN HORIZONTAL & VERTICAL CURVE
11+41.16 (SLOPE) & 10+95.57 (HOB.)

Page 1 of 3

ROCHESTER & PITTSBURGH COAL CO. ENGINEERING DEPT., INDIANA, PA.	
BOTTOM EXCAVATION URLING NO 1 SLOPE	
MADE BY JJS	SCALE 1"=2'
TRACED BY	DATE 1-28-76
CHECKED BY	NO.

IMAP5# 09182 10853-76