


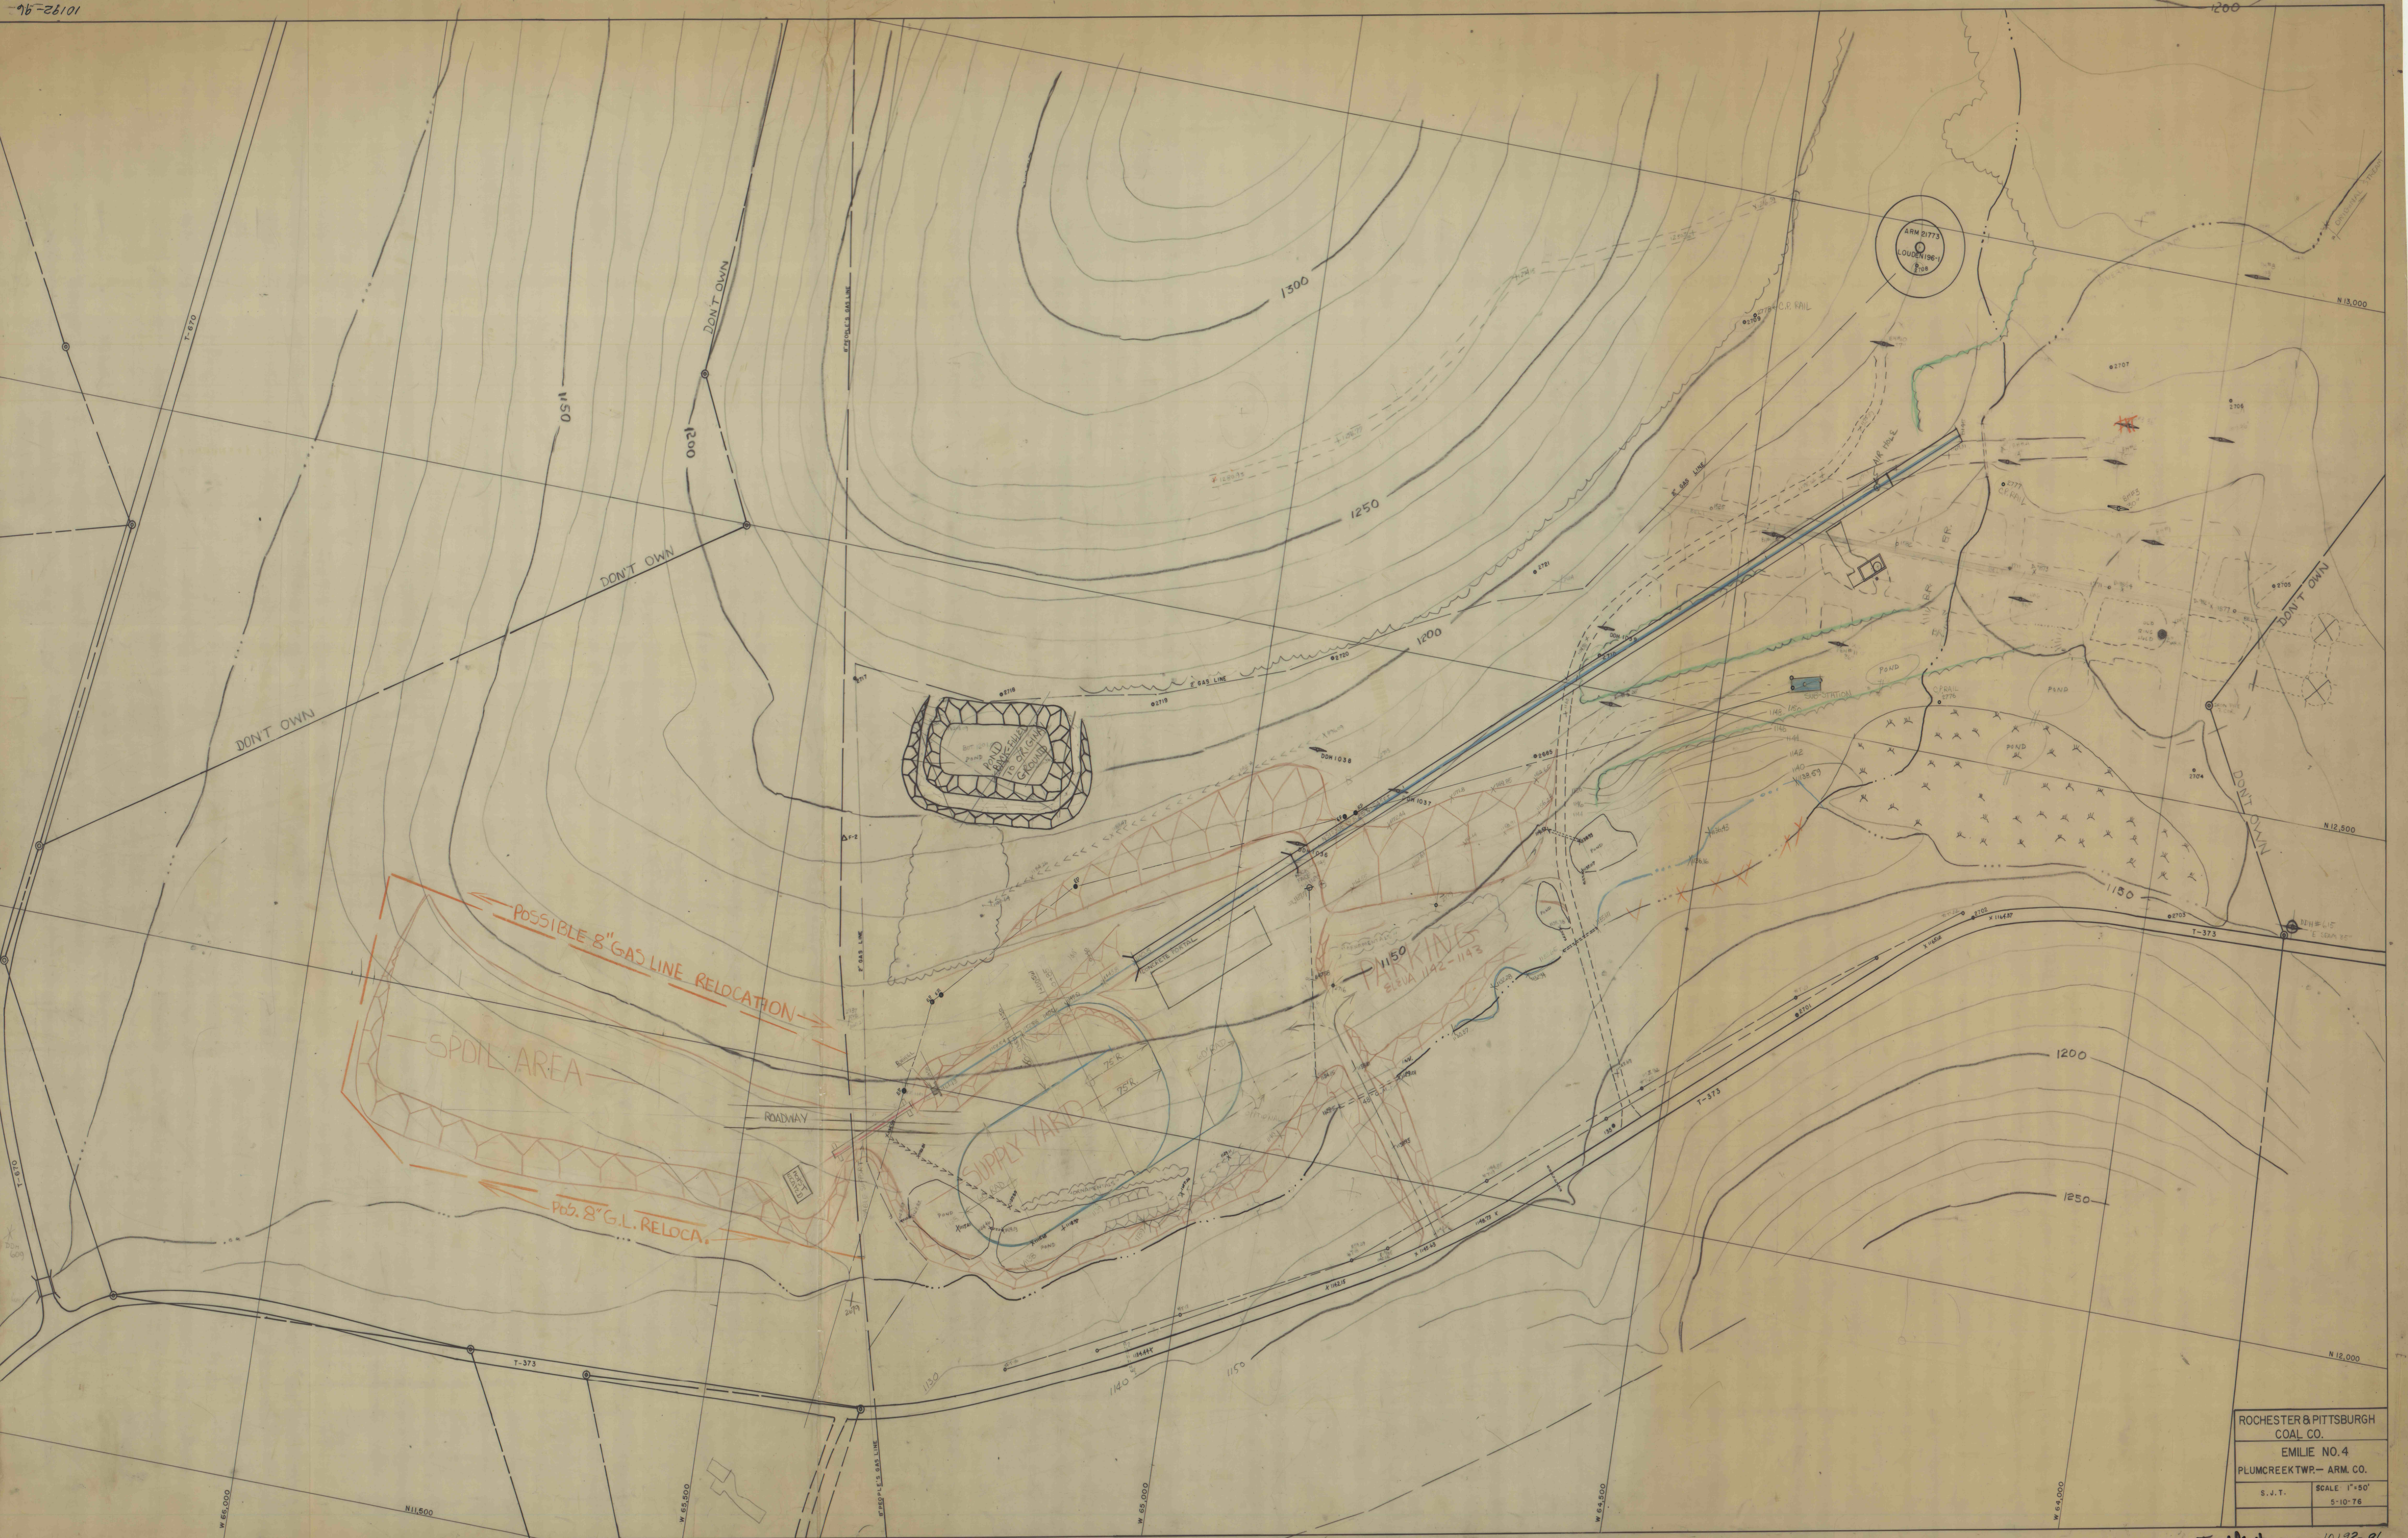

ROCHESTER & PITTSBURGH
COAL CO.
EMILIE NO. 4
PLUM CREEK TWP. - ARM. CO.
S. J. T. SCALE 1" = 50'
