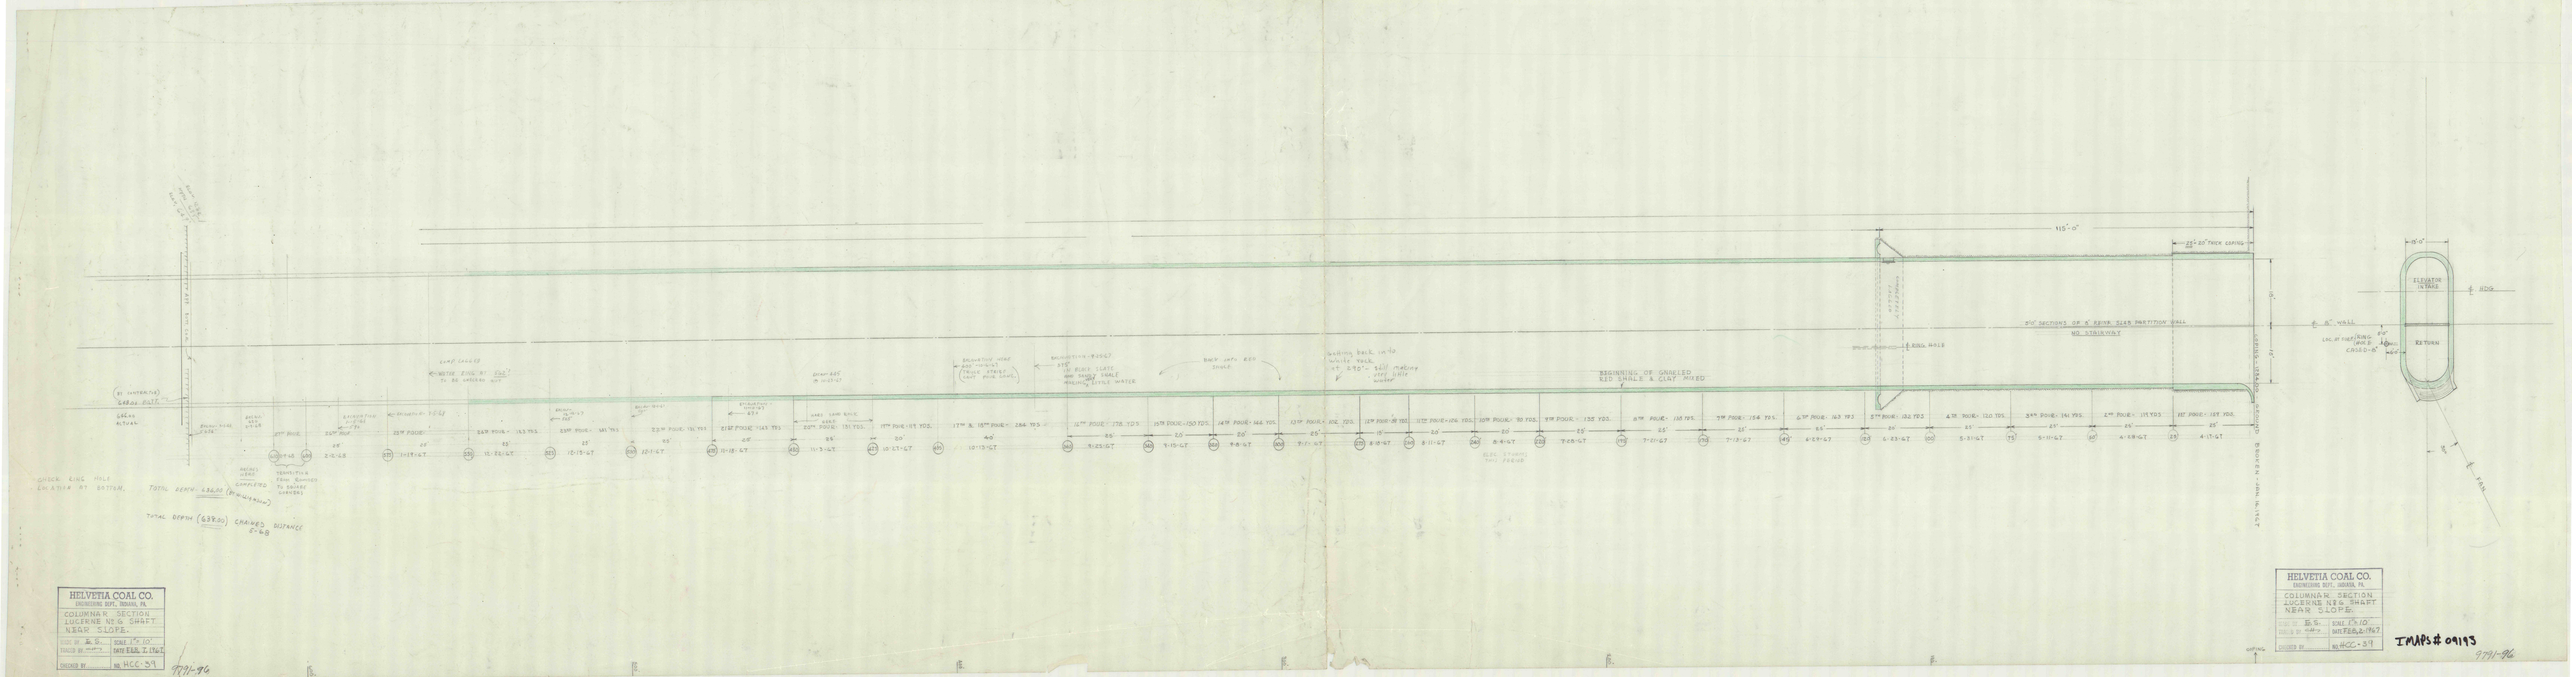
115'-0"
25'-20" THICK COPING
15'-0"
ELEVATOR INTAKE
RETURN
8" WALL
3'0" SECTIONS OF 8" BRICK SLAB PARTITION WALL
MID STAIRWAY
BEGINNING OF GARELED RED SHALE & CLAY MIXED
TOTAL DEPTH (638.00) CHAINED DISTANCE 8-68
CHECK CING HOLE ELEVATION AT BOTTOM.
HELVETIA COAL CO.
ENGINEERING DEPT. INDIANA, PA.
COLUMNAR SECTION
LUCERNE NO 6 SHAFT
NEAR SLOPE.
SCALE 1"=10'
DATE FEB. 7, 1967
NO. HCC-39
CHECKED BY
HELVETIA COAL CO.
ENGINEERING DEPT. INDIANA, PA.
COLUMNAR SECTION
LUCERNE NO 6 SHAFT
NEAR SLOPE.
SCALE 1"=10'
DATE FEB. 2, 1967
NO. HCC-39
CHECKED BY
IMAPS # 09193
7791-96