


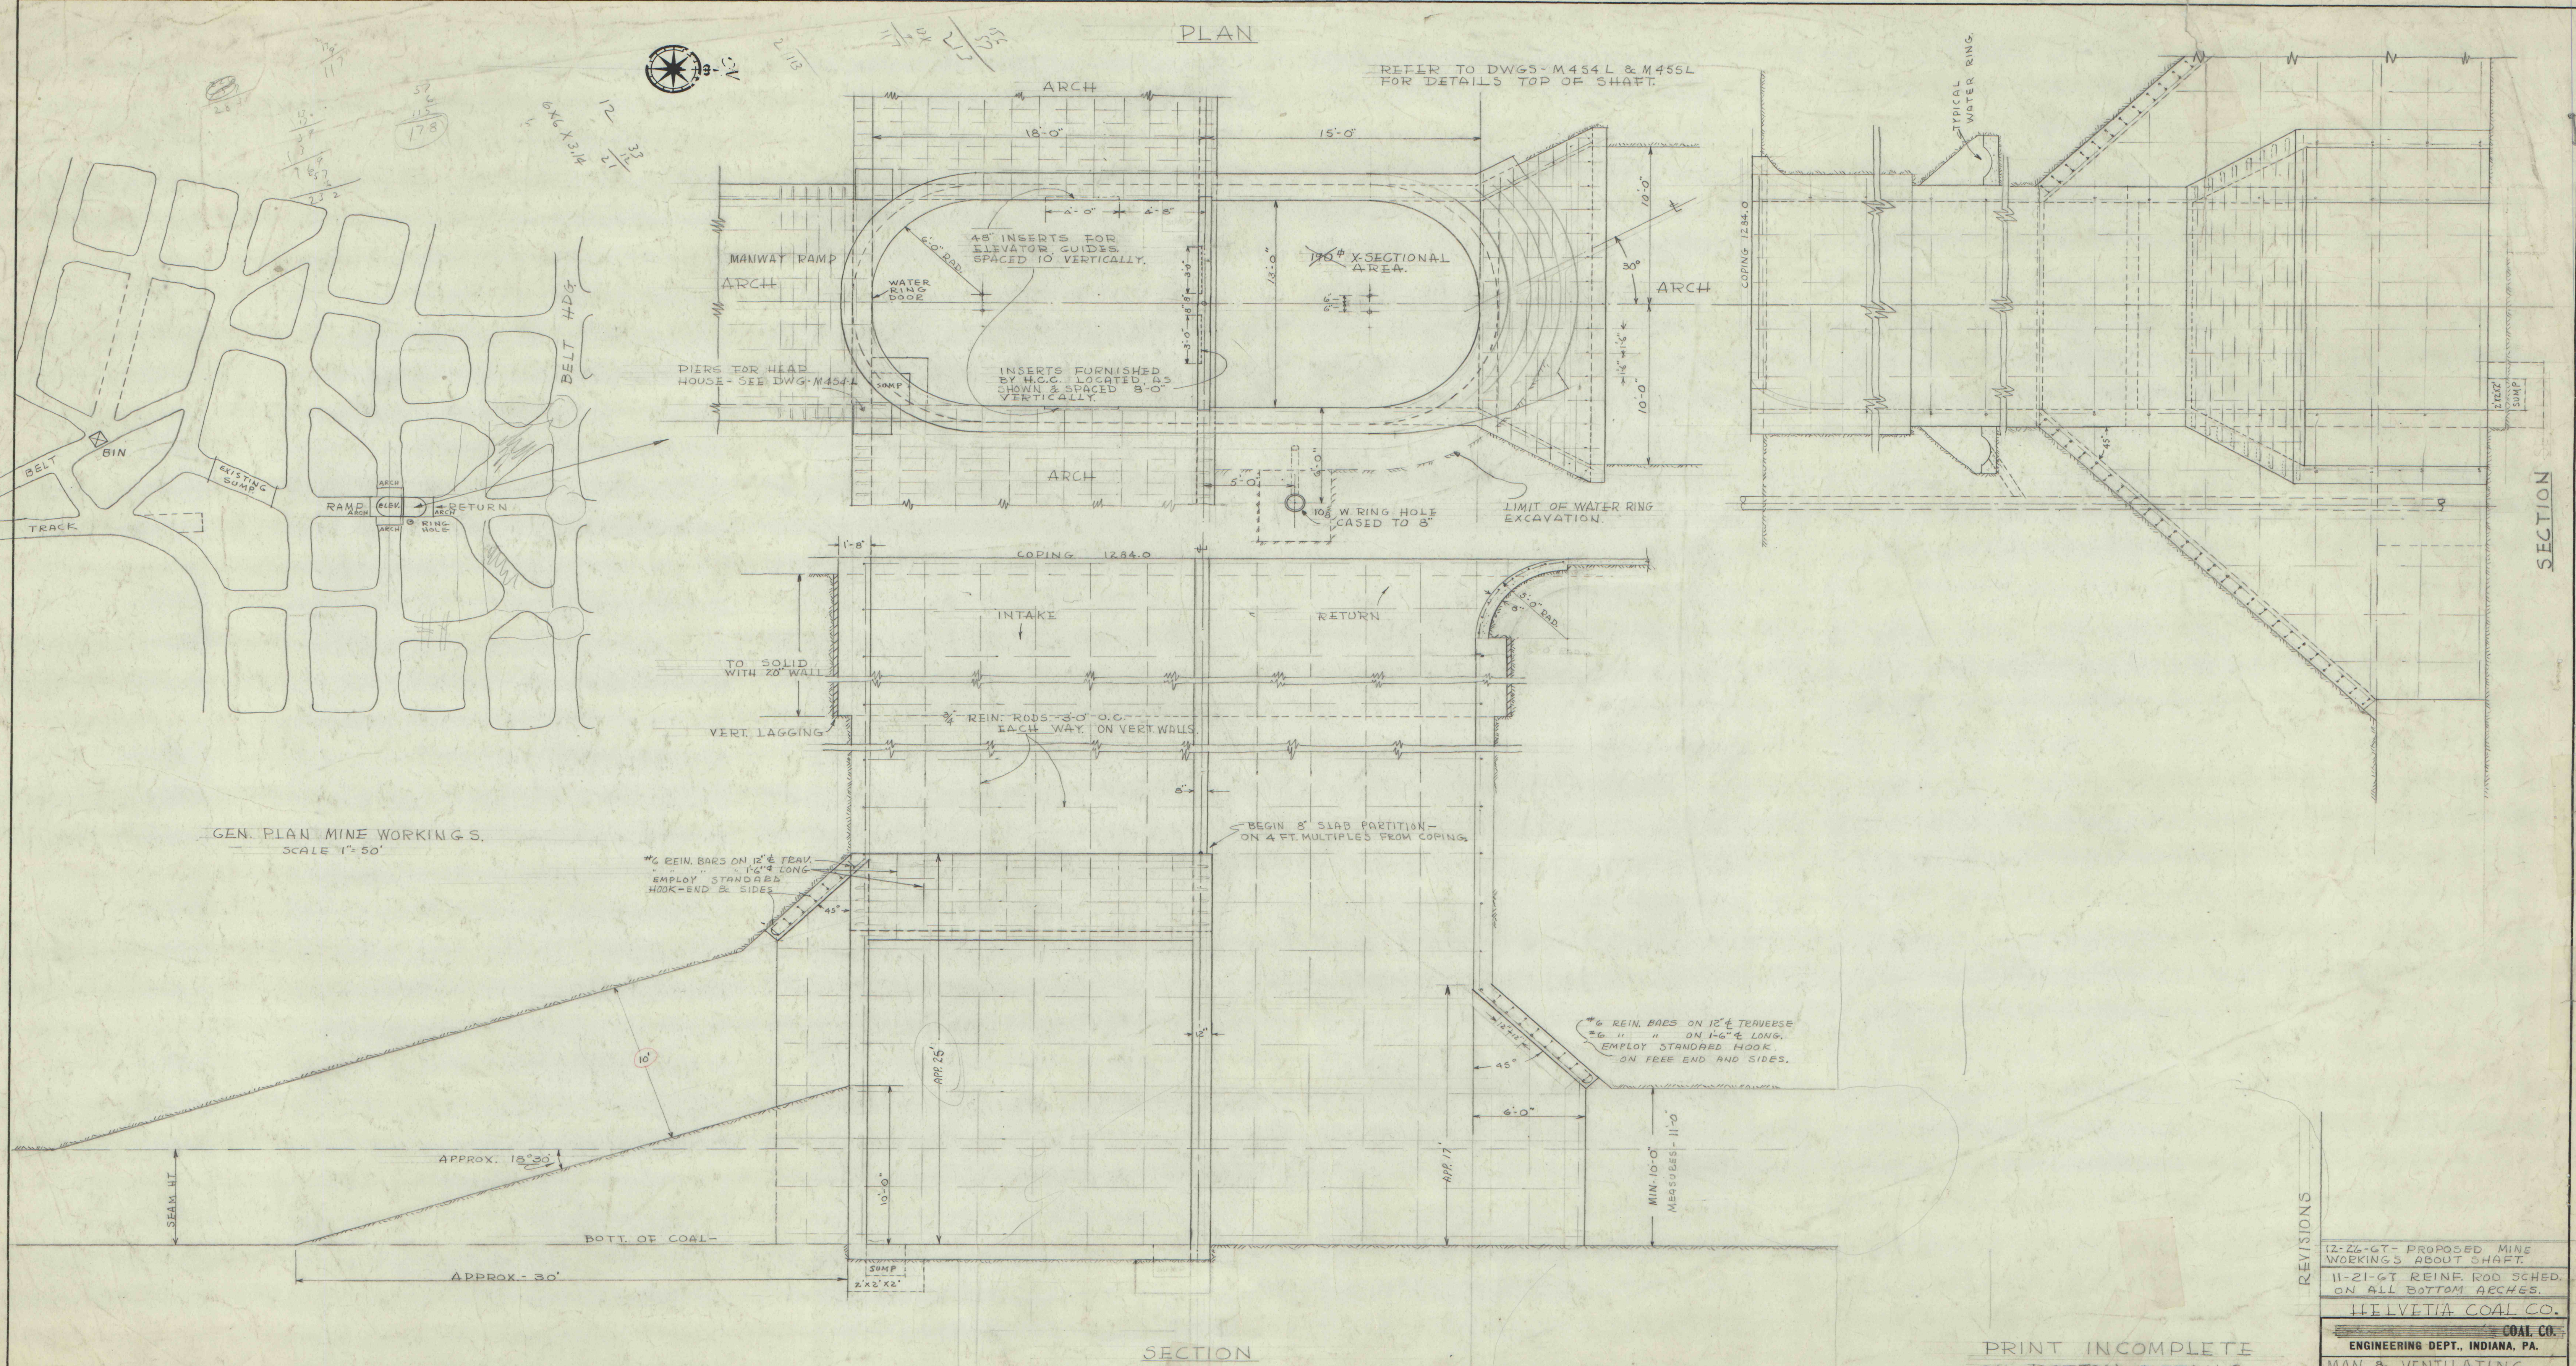

GEN. PLAN MINE WORKINGS.
SCALE 1" = 50'

SECTION

PRINT INCOMPLETE
ON BOTTOM DETAILS.
11-21-67

REVISIONS

12-26-67- PROPOSED MINE WORKINGS ABOUT SHAFT.	
11-21-67 REIN. ROD SCHED. ON ALL BOTTOM ARCHES.	
HELVETIA COAL CO.	
ENGINEERING DEPT., INDIANA, PA.	
MAN & VENTILATING SHAFT - LUCERNE #6 AT BOTTOM OF SLOPE	
MADE BY E.S.	SCALE 1/4" = 1'
TRACED BY	DATE 3-21-67
CHECKED BY	NO. HCC-38

IMAPS # 09196

9791-