"Special" CROSS SECTION 10X10 TO 1
B.K. ELLIOTT CO.
MADE IN U.S.A.

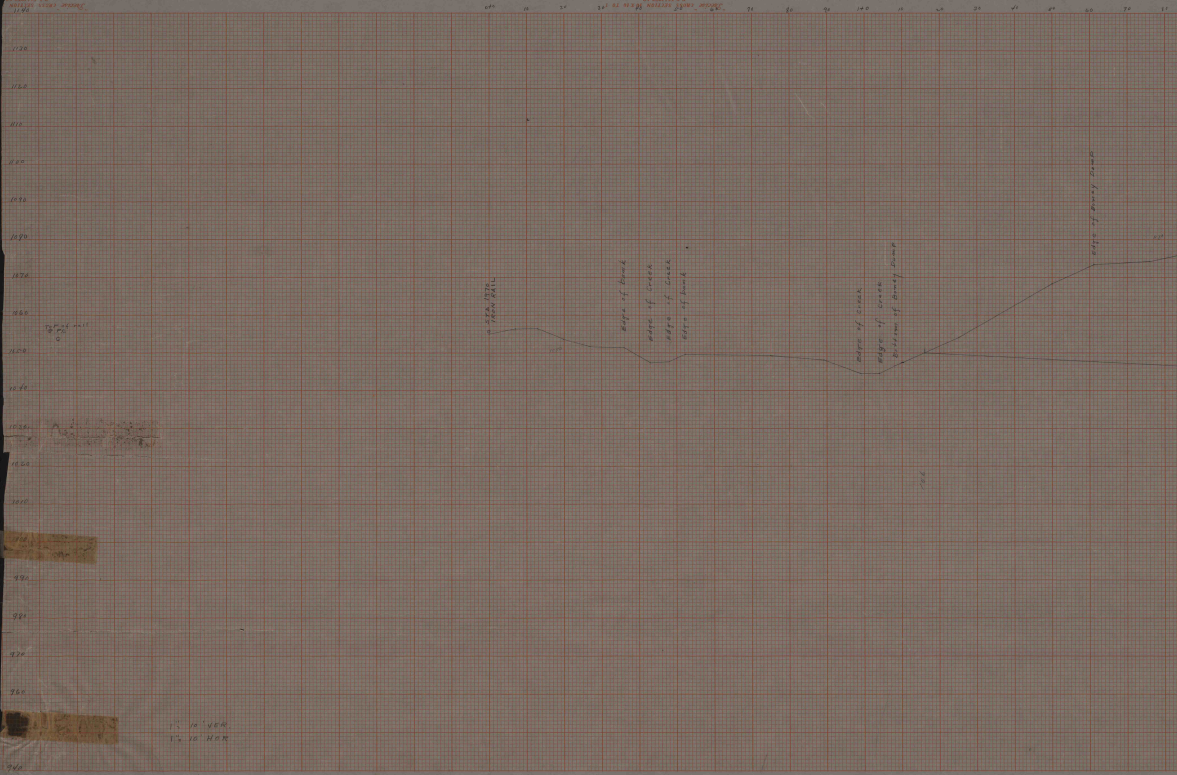

1" = 10' VER.
1" = 10' HOR

IMAPS # 09198

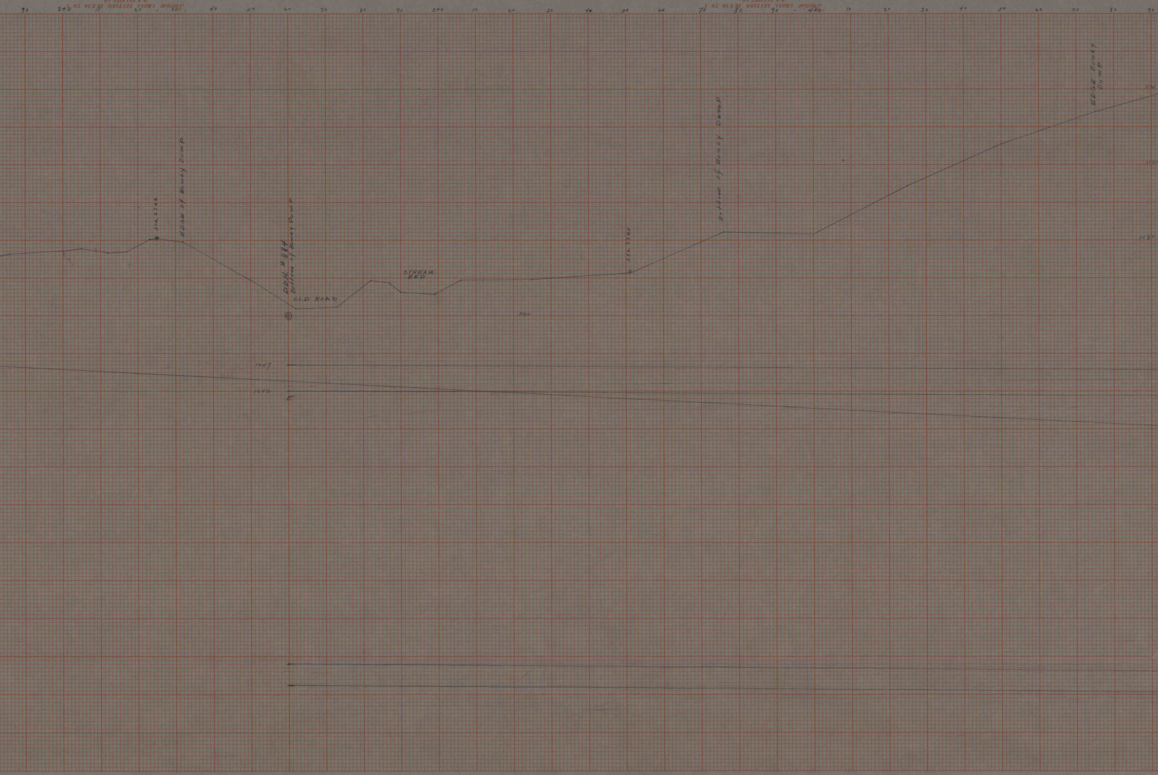
90
2+0
10
20
30
40
50
60
70
80
90
3+0
10
20
30
40
50
60
70
80
90
4+0
10
20
30
40
50
60
70
80
90
STA. 2744
EDGE of Bomey Dump
D.D.H. #884
Bottom of Bomey Dump
OLD ROAD
STREAM BED
1060
STA. 2745
Bottom of Bomey Dump
EDGE Bomey Dump
1120
1100
1080
1047
1040

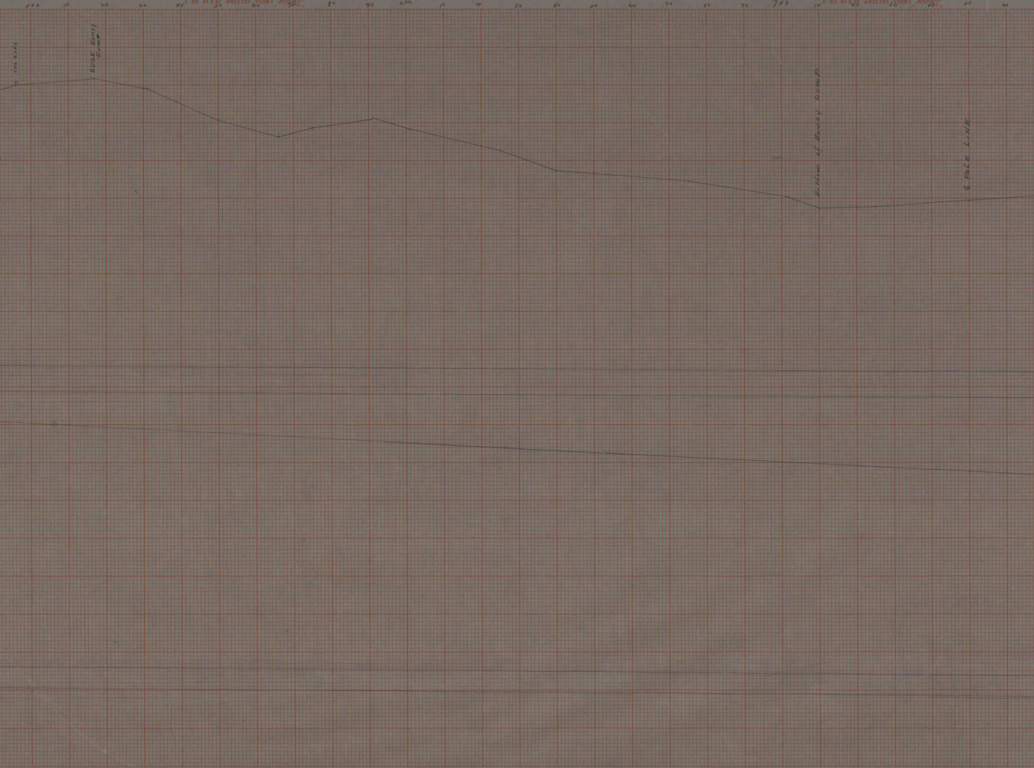
5+0
10
20
30
40
50
60
70
80
90
6+0
10
20
30
40
50
60
70
80
90
7+0
10
20
30
40
50
60
STA 27+6
EDGE Bowsy DUMP
1100
Bottom of Bowsy DUMP
℄ POLE LINE

"Albanene" CROSS SECTION 10 X 10 TO 1
B.K. ELLIOTT CO.
MADE IN U.S.A.

Precise CROSS SECTION 10 X 10 TO 1
R. K. ELLIOTT CO.
MADE IN U.S.A.

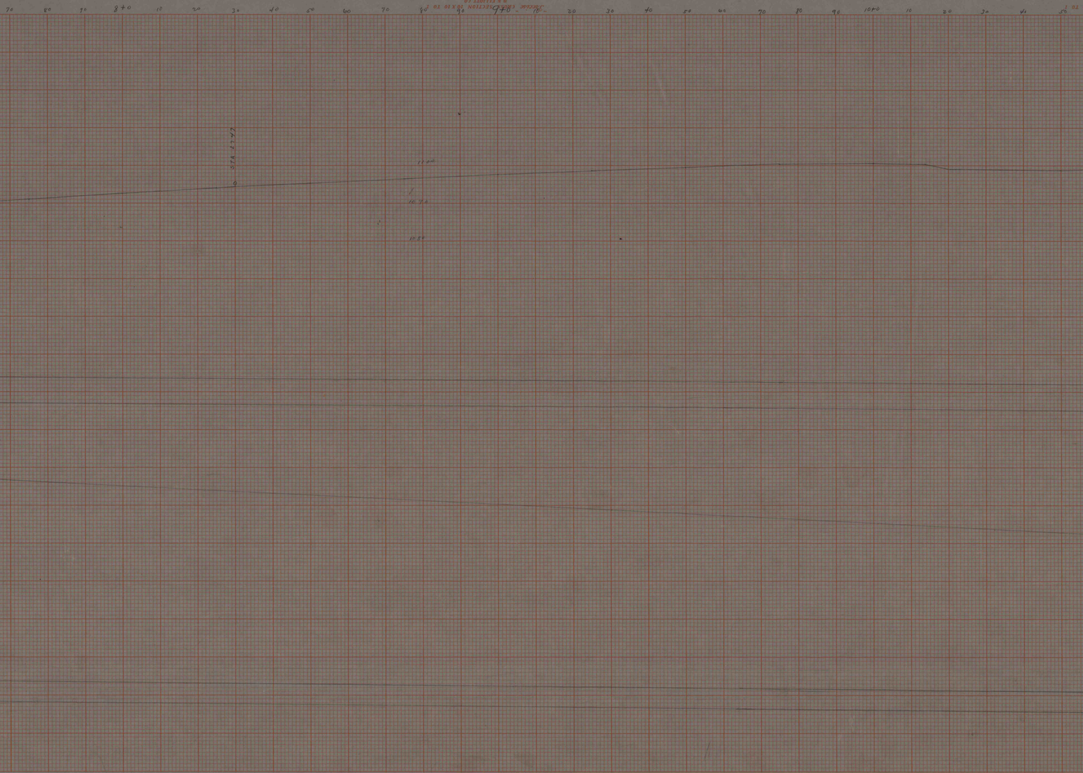
70
80
90
8+0
10
20
30
40
50
60
70
80
90
9+0
10
20
30
40
50
60
70
80
90
10+0
10
20
30
40
50
STA 2747
1100
1090
1080

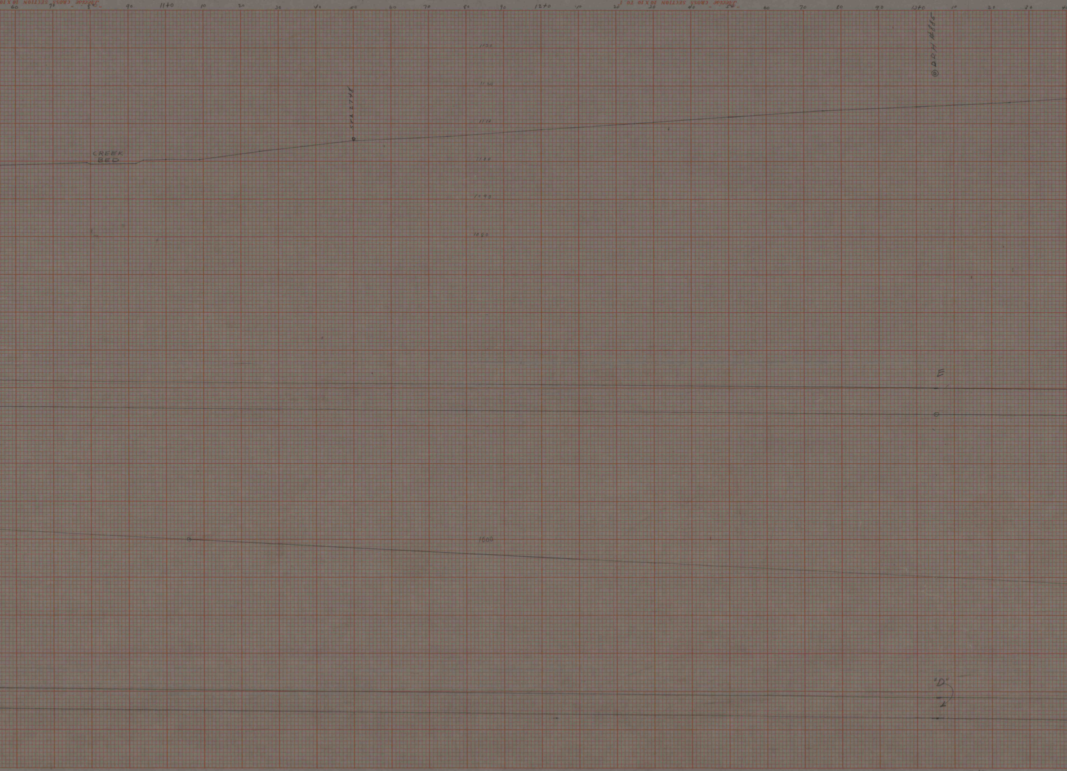
60
70
80
90
11+0
10
20
30
40
50
60
70
80
90
12+0
10
20
30
40
50
60
70
80
90
13+0
10
20
30
40
STA 27+48
CREEK BED
1130
1120
1110
1100
1090
1080
1000
DDH #88
E
"D"

940

Precise CROSS SECTION 10 X 10 TO 1
B.K. ELLIOTT CO.
MADE IN U.S.A.

Precise CROSS SECTION 10 X 10 TO 1
B.K. ELLIOTT CO.
MADE IN U.S.A.

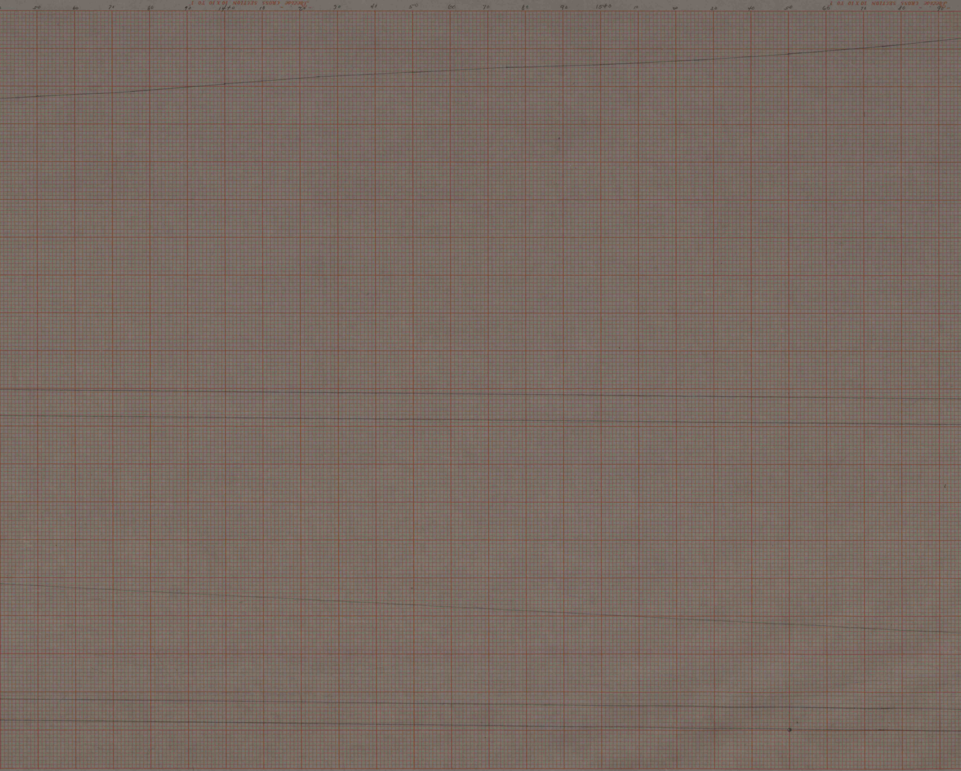
50
60
70
80
90
1470
10
20
30
40
50
60
70
80
90
1540
10
20
30
40
50
60
70
80
90

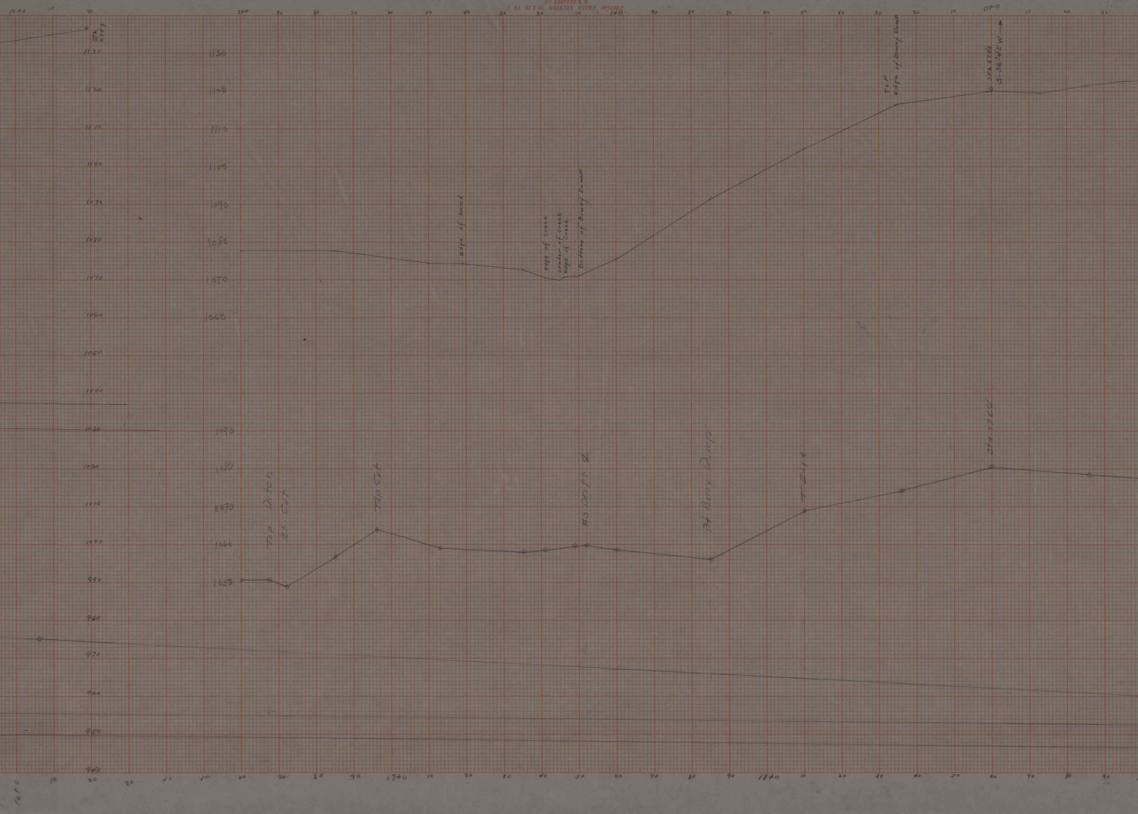
16+0
10
20
Sta. 2749
2+0
90
80
70
60
50
40
30
20
10
1+0
90
80
70
60
50
40
30
20
10
0+0
10
20
1130
1120
1110
1100
1090
1080
1070
1060
1050
1040
1030
1020
1010
1000
990
980
970
960
950
940
Edge of bank
Edge of Creek
center of Creek
Edge of Creek
Bottom of Bomey Dump
Top
Edge of Bomey Dump
STA 2746
S-36°45W →
Top Ditch
Bt. Cut
Top Cut
#3 Drift ℄
Bt Bmy Dump
T. Edge
Sta 2766
17+0
18+0

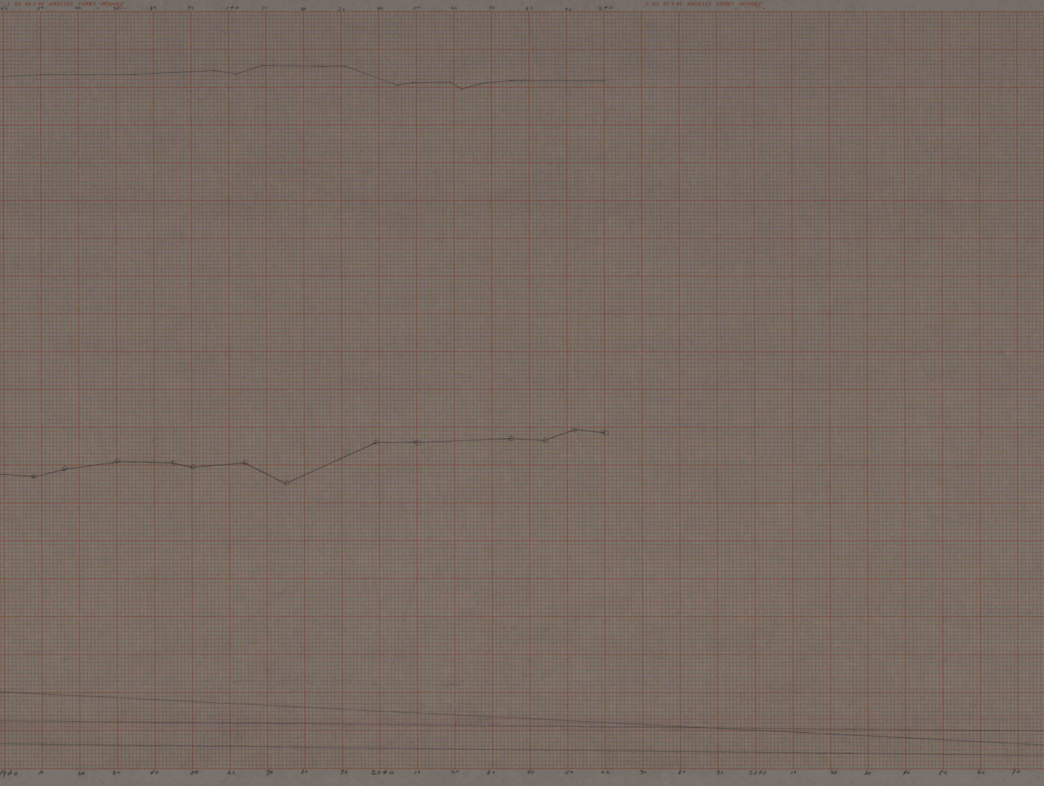

"Precise" CROSS SECTION 10 X 10 TO 1"
B.K. ELLIOTT CO.
MADE IN U.S.A.

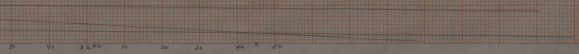
80
90
22+0
10
20
30
40
x
50