


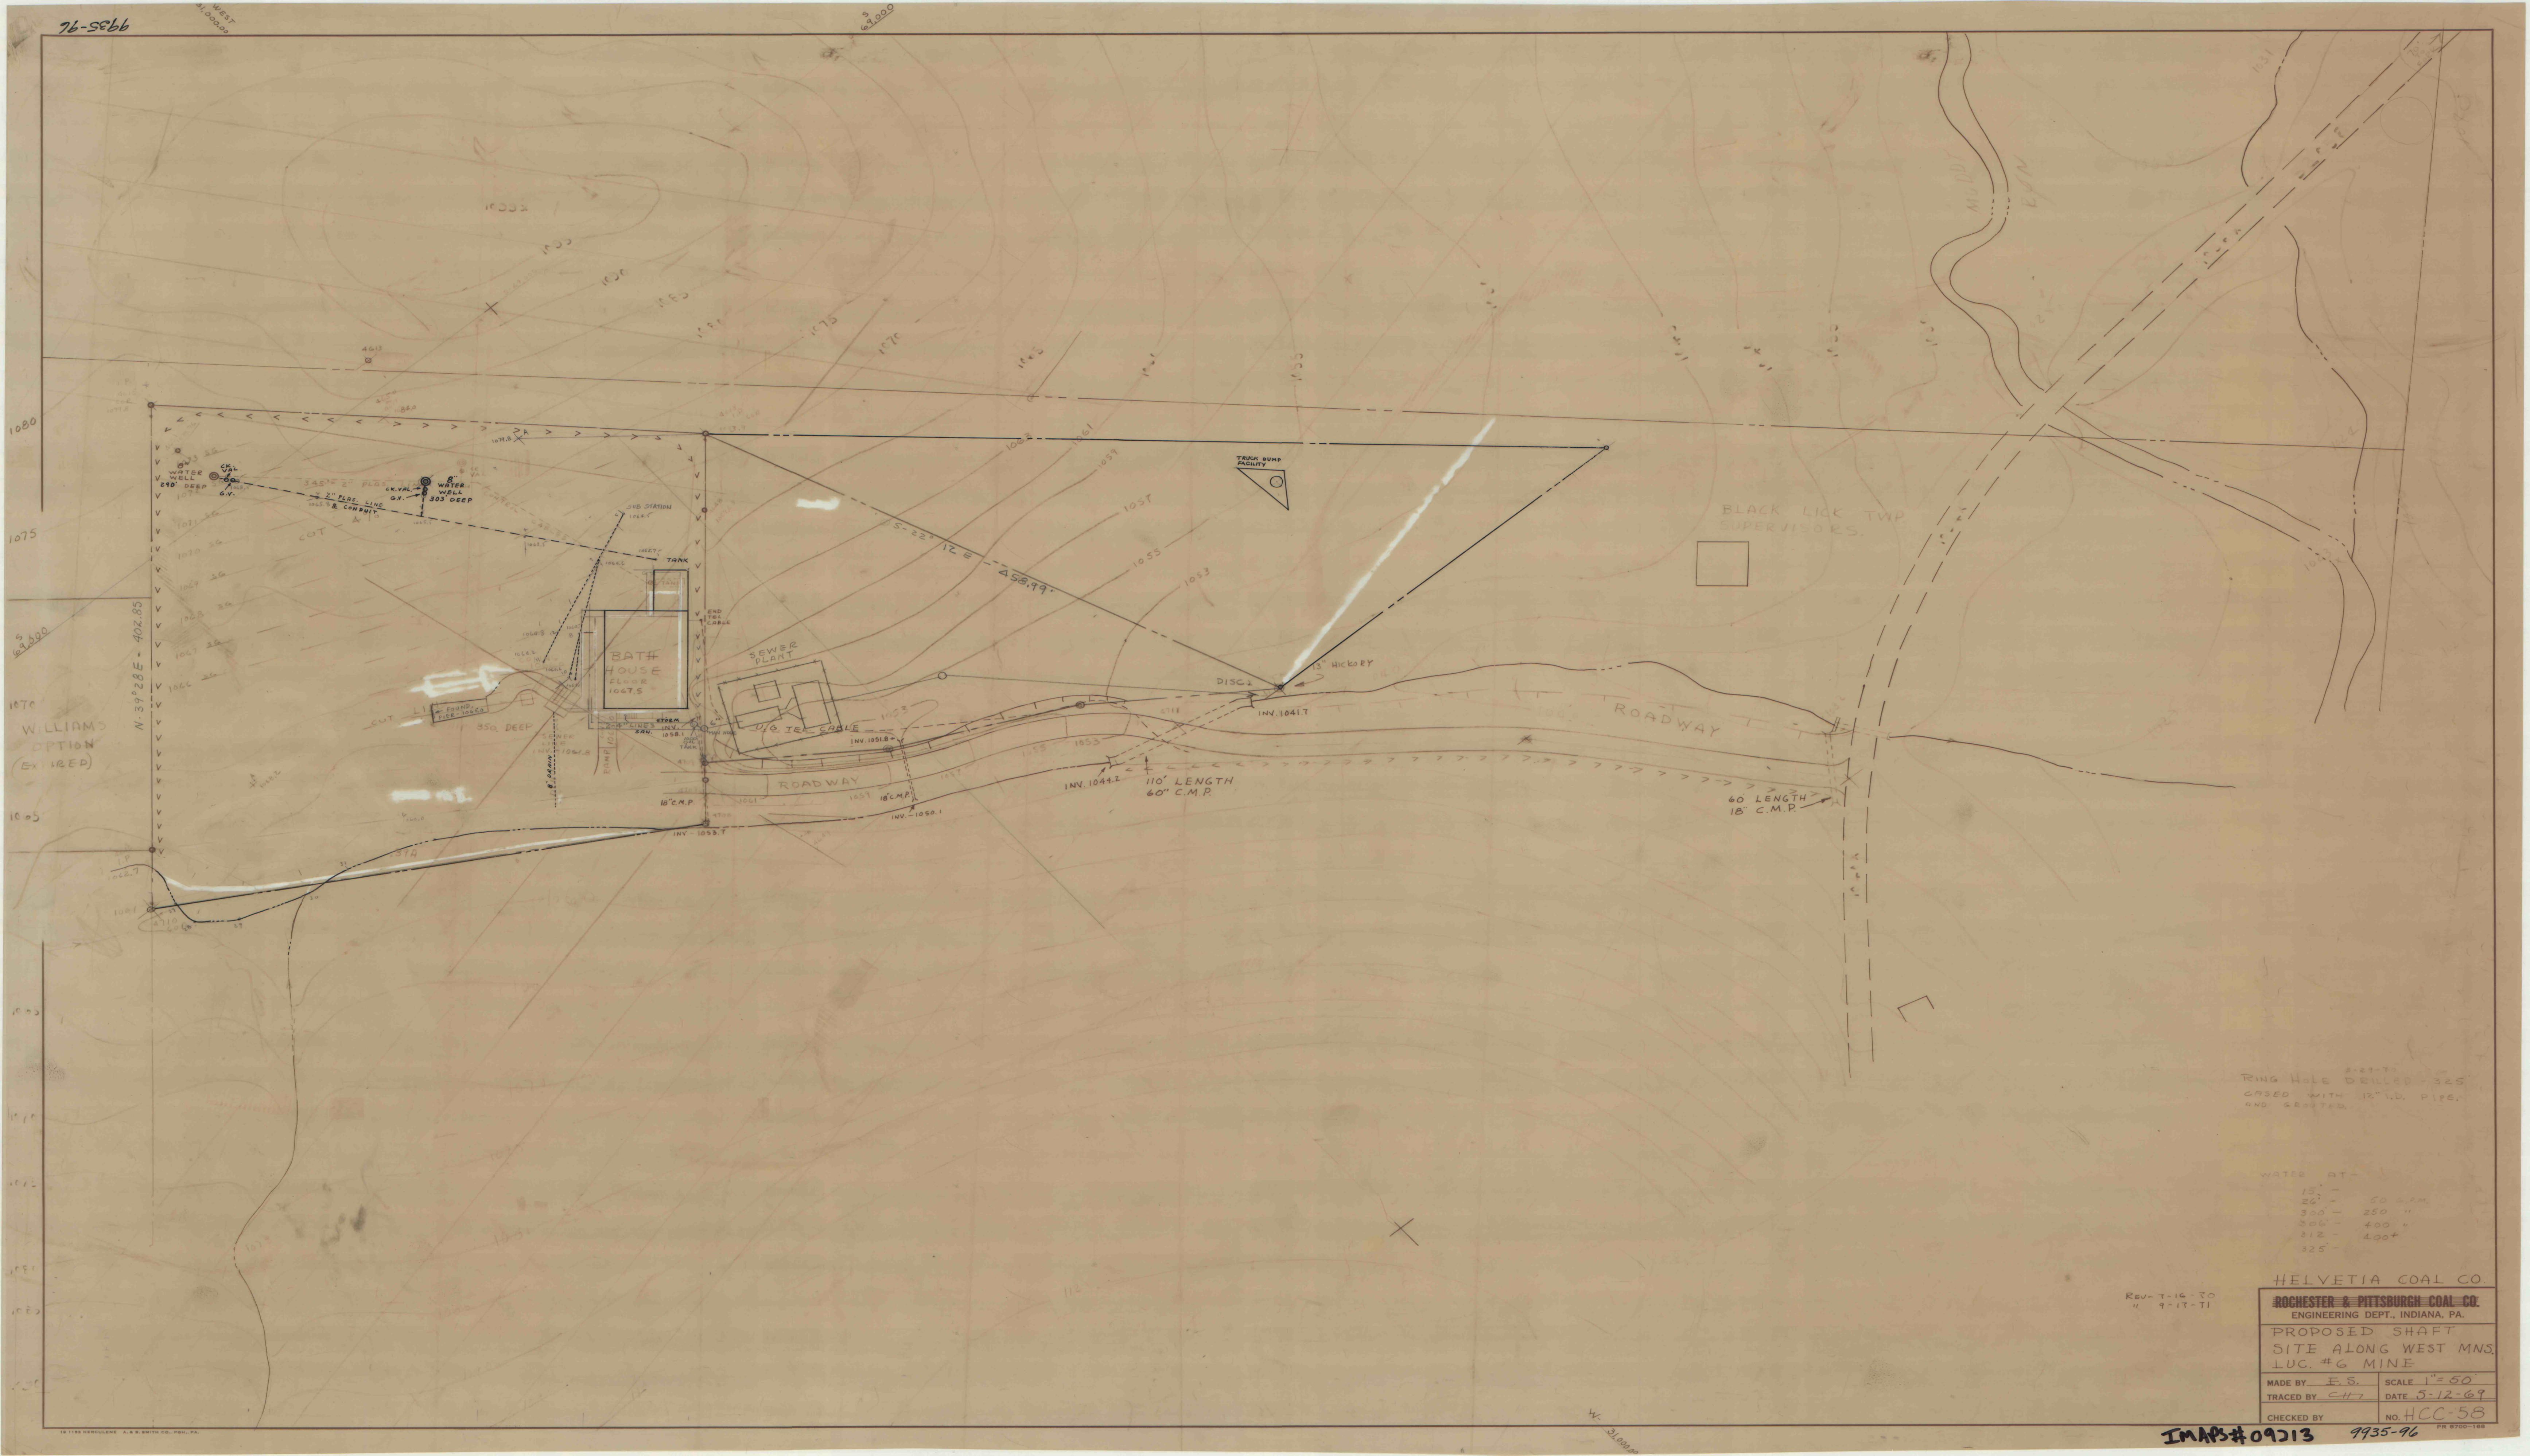

RING HOLE DRILLED - 325'
CASED WITH 12" I.D. PIPE
AND GROUTED

WATER AT -
15' -
24' - 50' G.A.M.
300' - 250' "
305' - 400' "
312' - 400' "
325' -

REV-T-16-30
" 9-17-71

HELVETIA COAL CO.	
ROCHESTER & PITTSBURGH COAL CO.	
ENGINEERING DEPT., INDIANA, PA.	
PROPOSED SHAFT	
SITE ALONG WEST MNS	
LUC. #6 MINE	
MADE BY: F.S.	SCALE: 1"=50'
TRACED BY: CH7	DATE: 5-12-69
CHECKED BY:	NO. HCC-58