9791-96

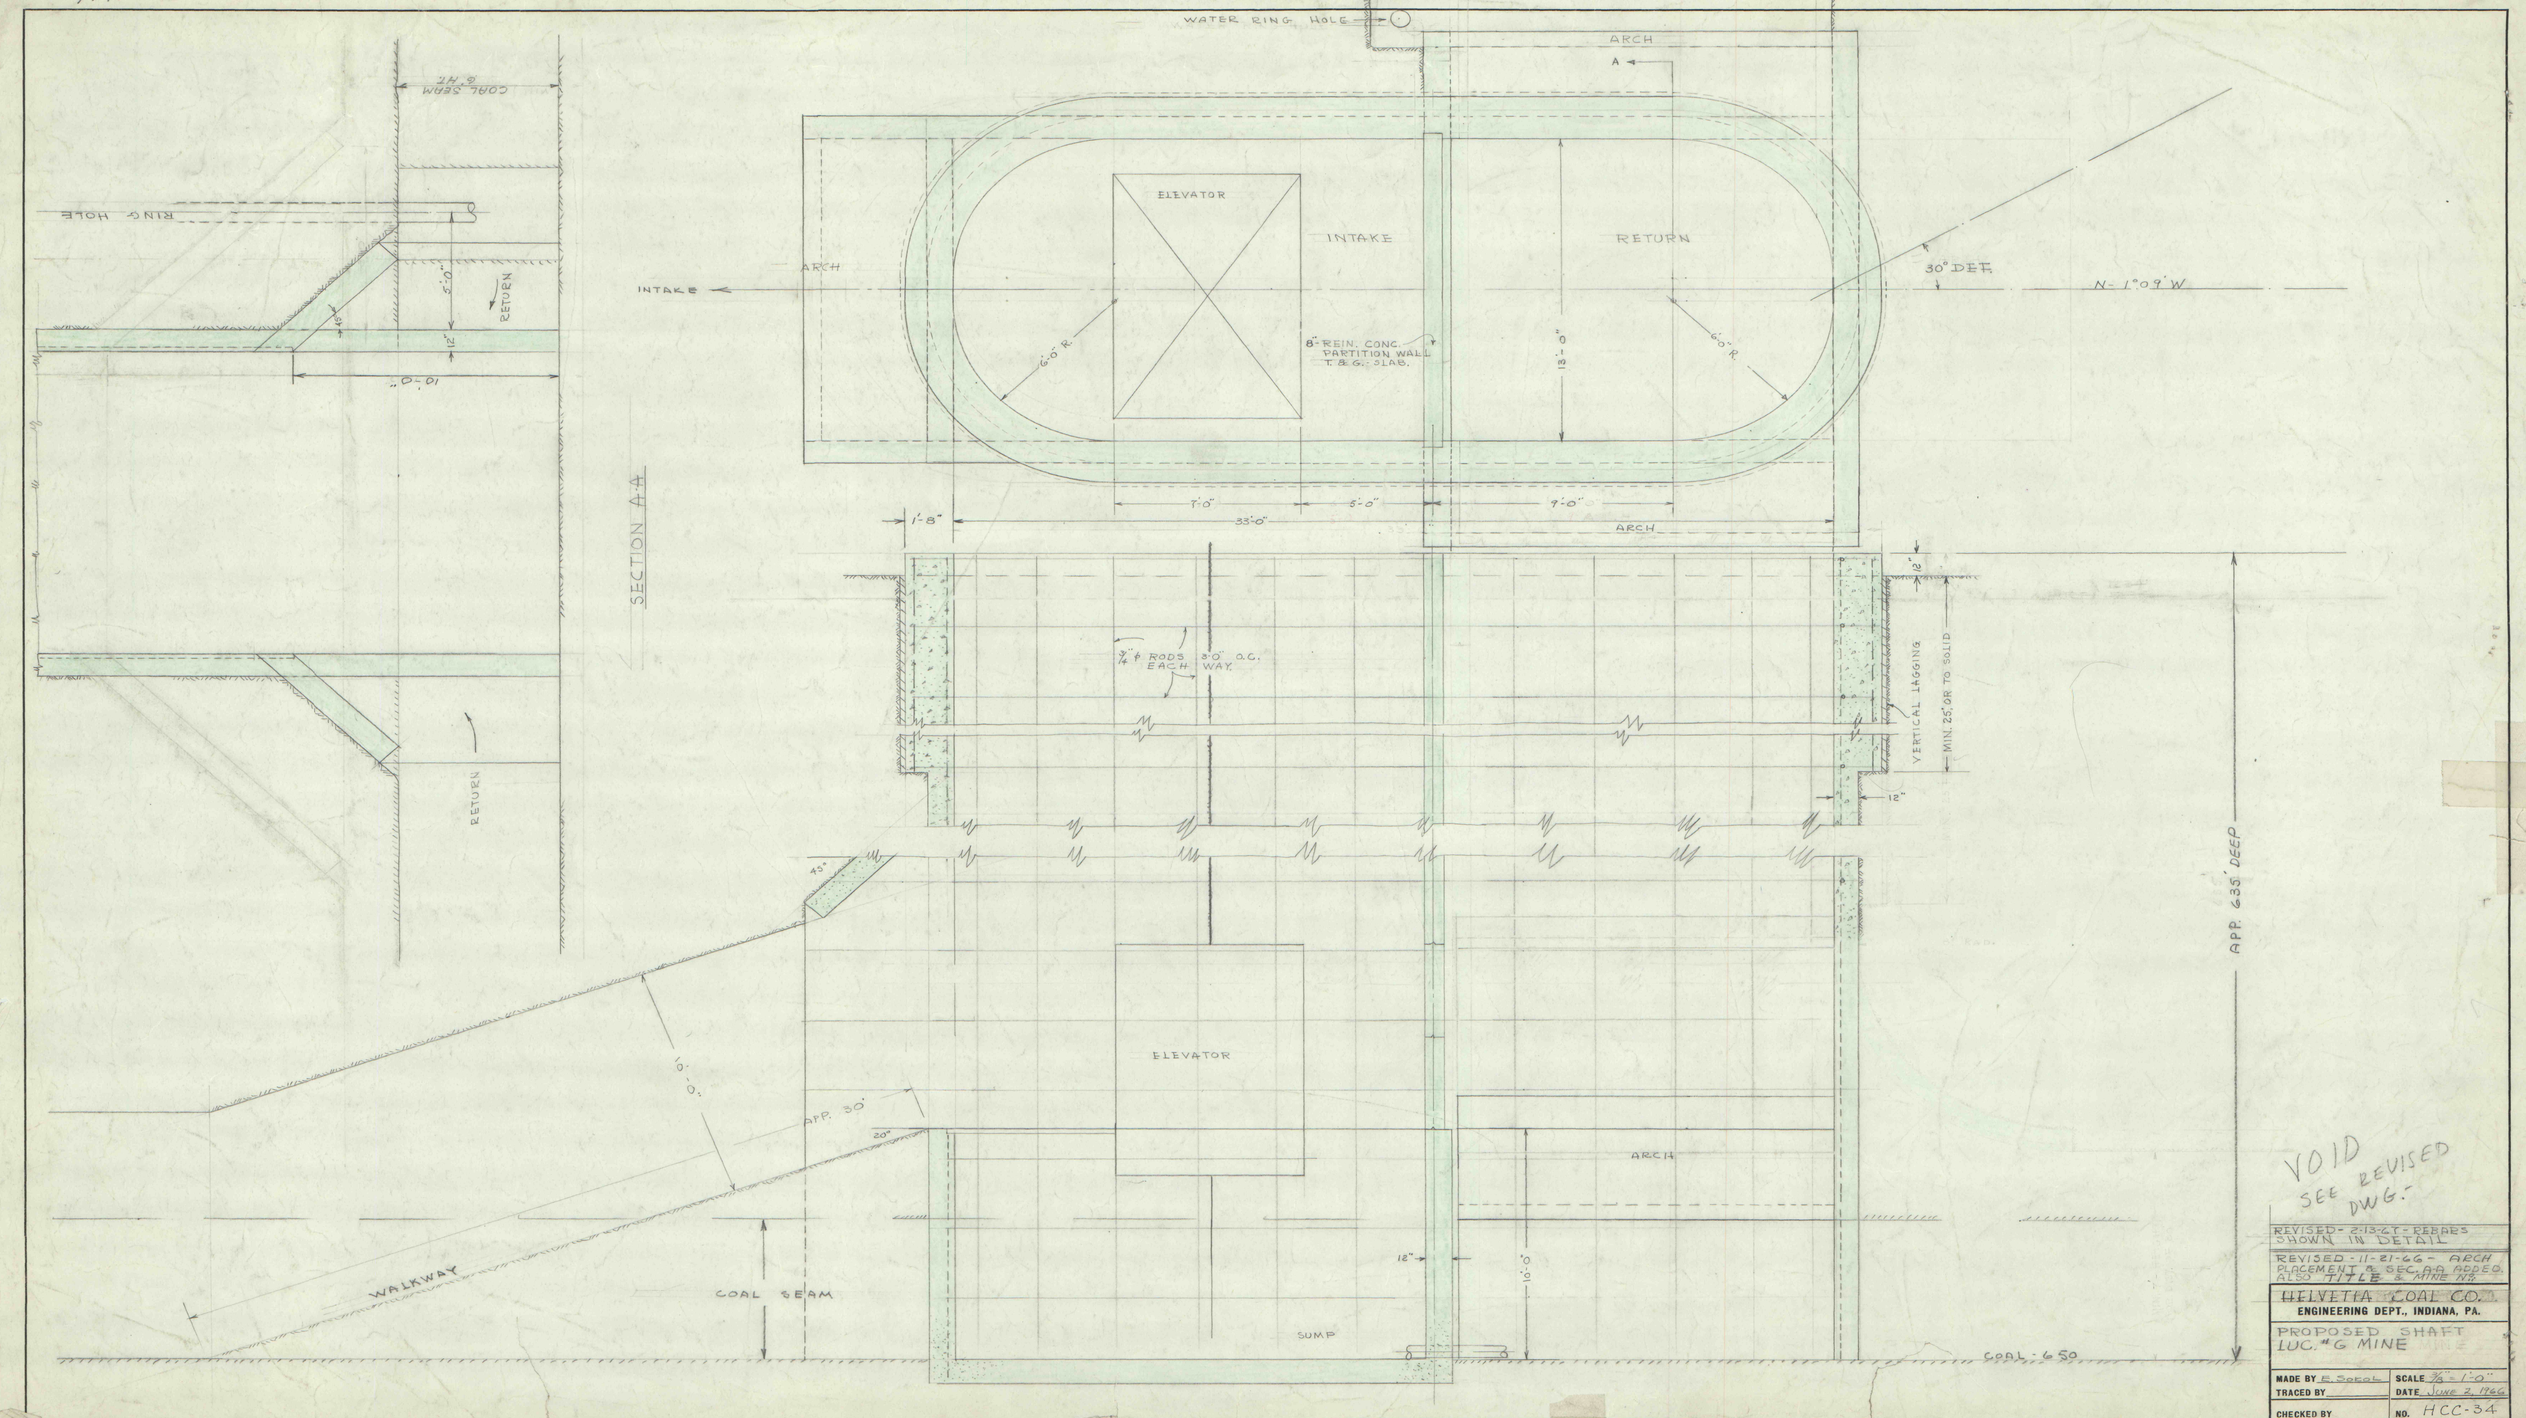

VOID
SEE REVISED DWG.

REVISED - 2-13-67 - REBARS SHOWN IN DETAIL

REVISED - 11-21-66 - ARCH PLACEMENT & SEC. AA ADDED. ALSO TITLE & MINE NO.

HELVETIA COAL CO.
ENGINEERING DEPT., INDIANA, PA.

PROPOSED SHAFT
LUC. "G" MINE

MADE BY E. Sokol	SCALE 1/8" = 1'-0"
TRACED BY	DATE June 2, 1966
CHECKED BY	NO. HCC-34

IMAPS # 09215

9791-96

K. ELLIOTT CO., PGH., PA. REORDER A-23471