


96-5944-681-229

8-1-28

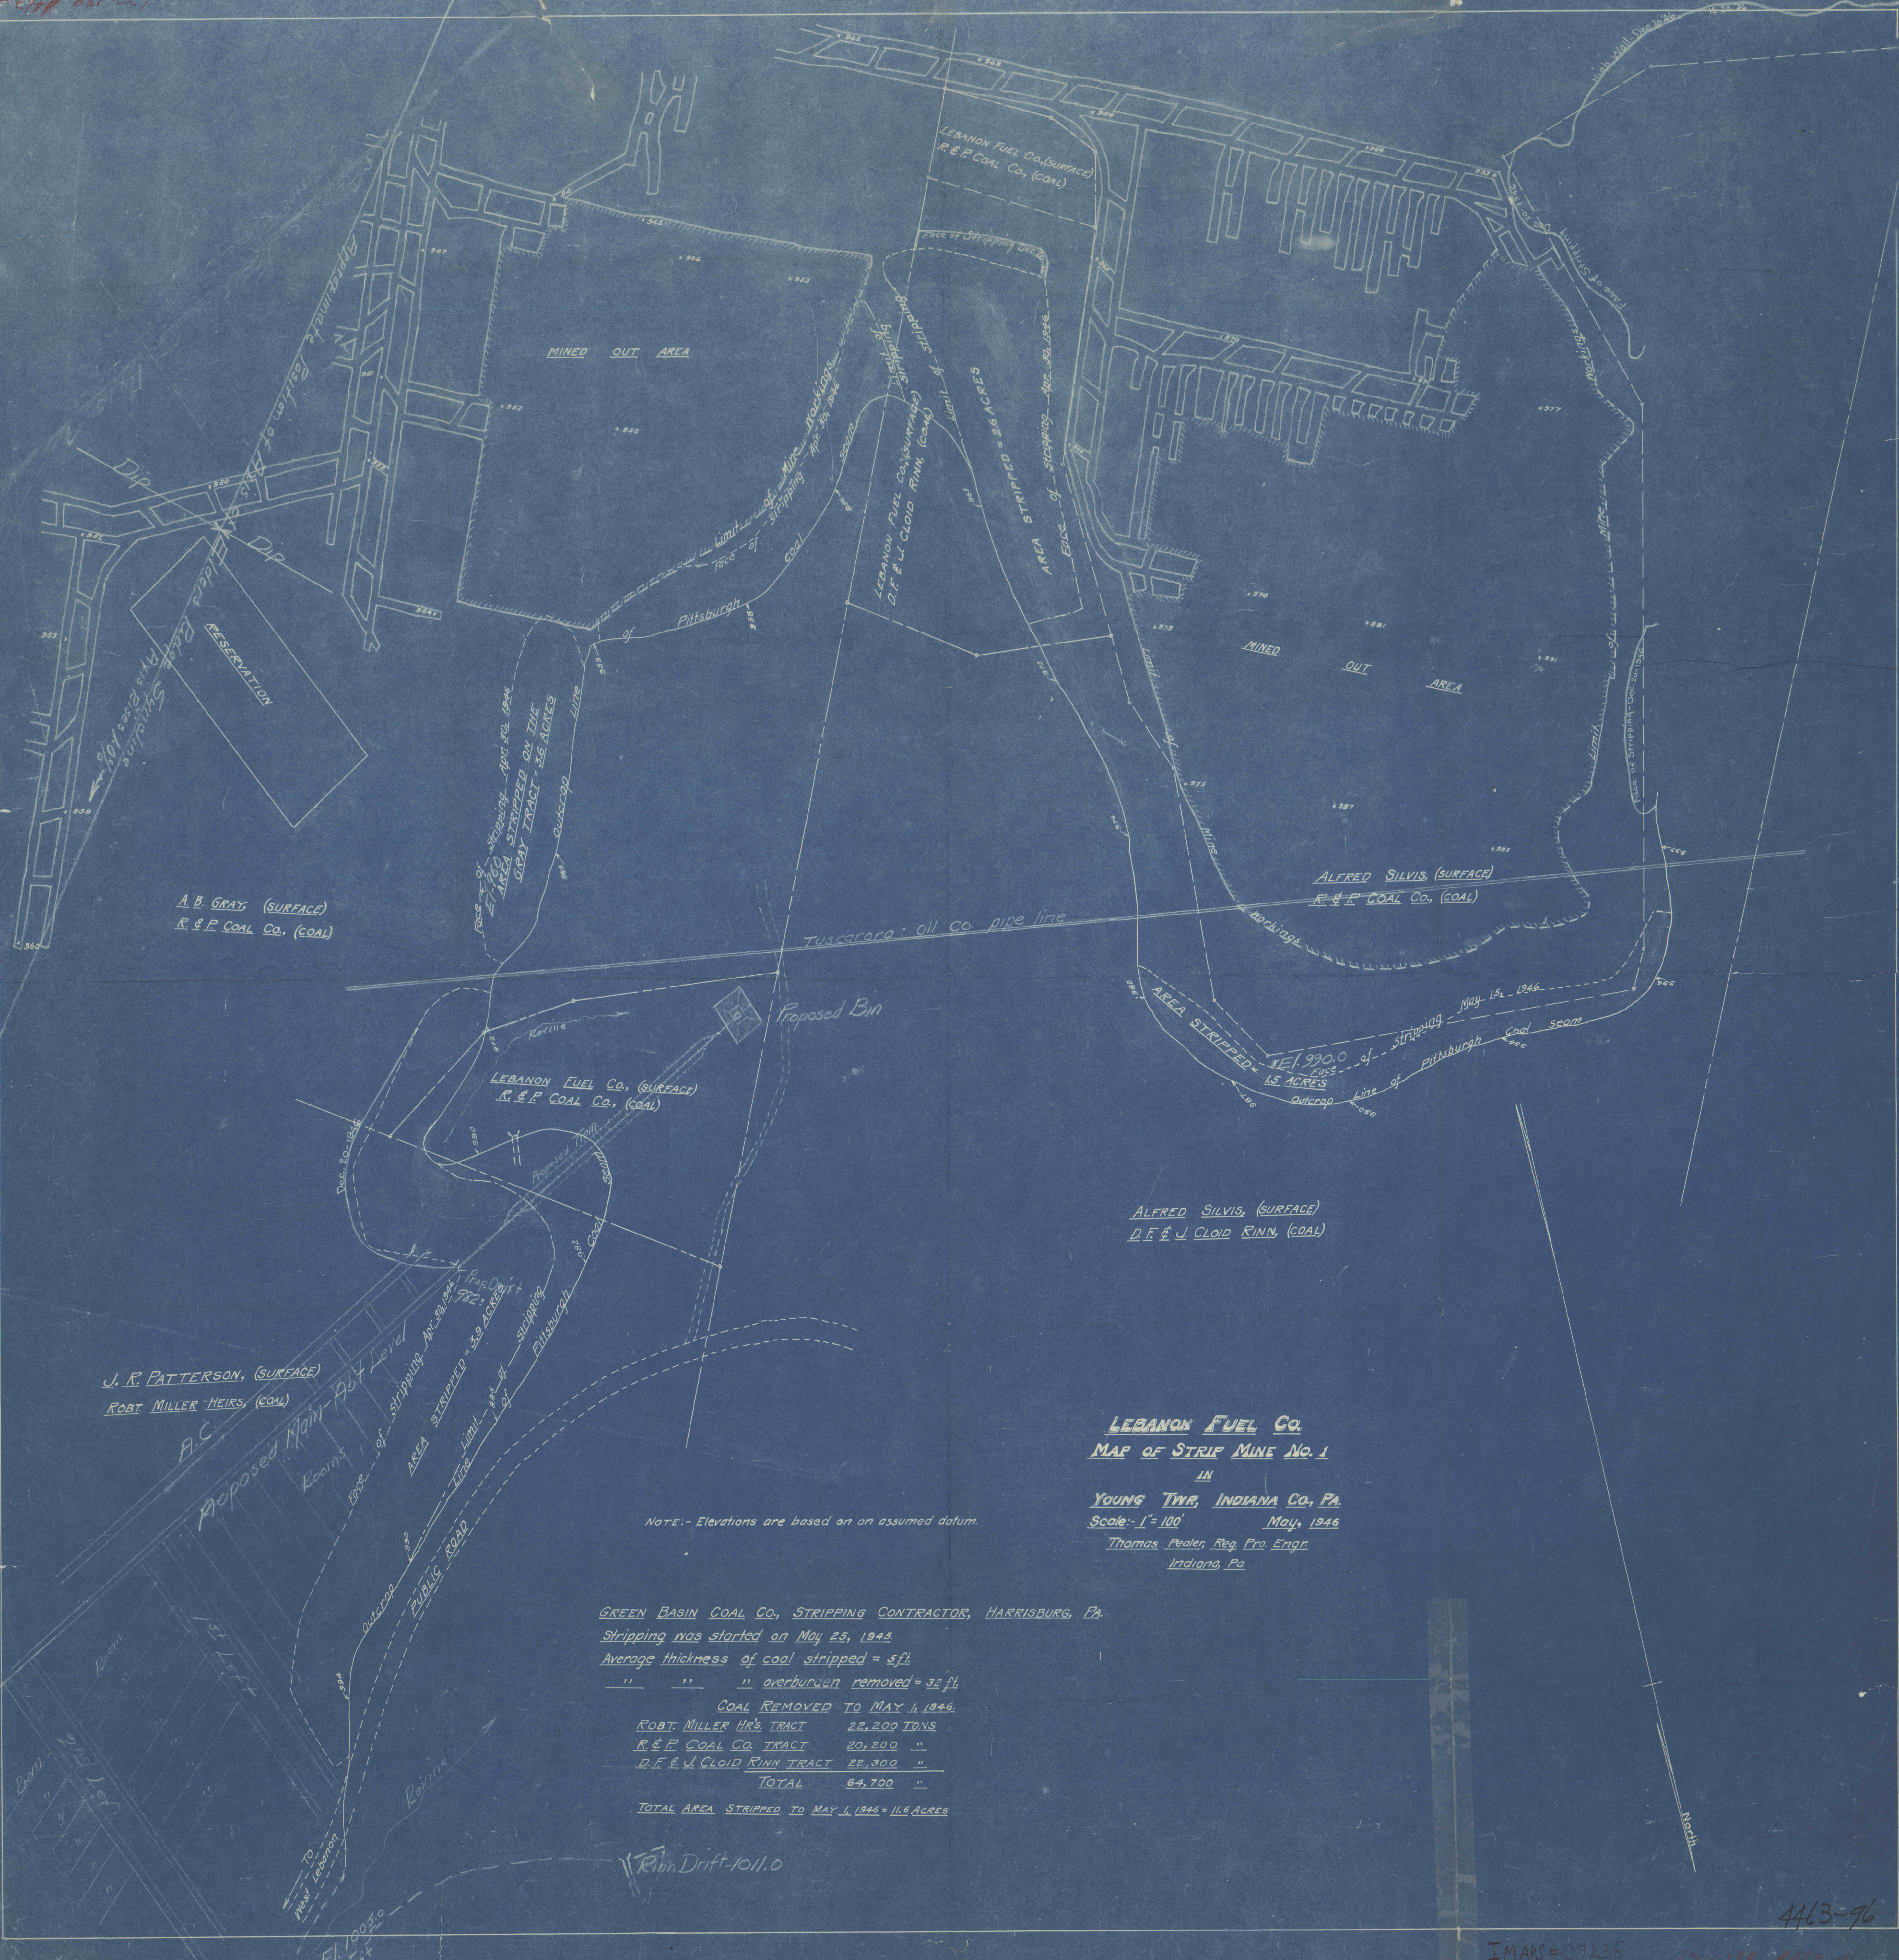

A. B. GRAY (SURFACE)
R. & F. COAL CO. (COAL)

FACE of stripping Apr. 30, 1946
AREA STRIPPED ON THE
GRAY TRACT - 126 ACRES
outcrop line

Tuscarora oil Co. pipe line

Proposed Bin

LEBANON FUEL CO. (SURFACE)
R. & F. COAL CO. (COAL)

ALFRED SILVIS (SURFACE)
D. F. & J. CLOUD RINN (COAL)

J. R. PATTERSON (SURFACE)
ROBT MILLER HEIRS (COAL)

Proposed Main Road
Proposed Level
FACE of stripping Apr. 30, 1946
AREA STRIPPED - 32.9 ACRES
outcrop line
Pittsburgh

NOTE: - Elevations are based on an assumed datum.

LEBANON FUEL CO.
MAP OF STRIP MINE No. 1
IN
YOUNG TWP, INDIANA CO., PA.
Scale: 1" = 100' May, 1946
Thomas Pealer, Reg. Prof. Engr.
Indiana, Pa.

GREEN BASIN COAL CO., STRIPPING CONTRACTOR, HARRISBURG, PA.
Stripping was started on May 23, 1945.
Average thickness of coal stripped = 5 ft.
" " " overburden removed = 32 ft.
COAL REMOVED TO MAY 1, 1946.
ROBT MILLER HEIRS TRACT 22,200 TONS
R. & F. COAL CO. TRACT 20,200 "
D. F. & J. CLOUD RINN TRACT 22,300 "
TOTAL 64,700 "
TOTAL AREA STRIPPED TO MAY 1, 1946 = 11.6 ACRES

Rinn Drift 1011.0

4463-96

IMARS#09238

62-119-1463-96